


23.2.10.
7.4.10

Detail Sketches of Profile & Dk Plans
to be submitted

PROPOSED TWIN SCREW STEAMER
DIMENSIONS 525'-0" x 61'-0" x 36'-6" TO UPPER DECK.


PROFILE

SCALE $\frac{1}{16}$ " = 1 FOOT.

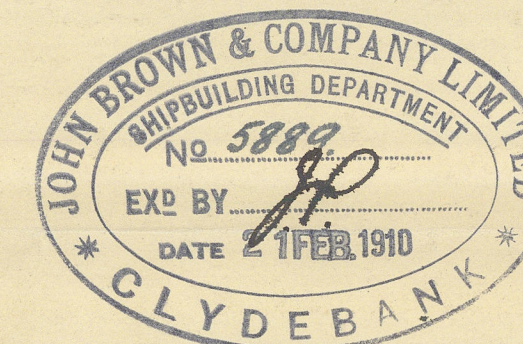

Load Draft 30.0

Coeff. .78
Sheer ft. 9' 9"
aft. 3'

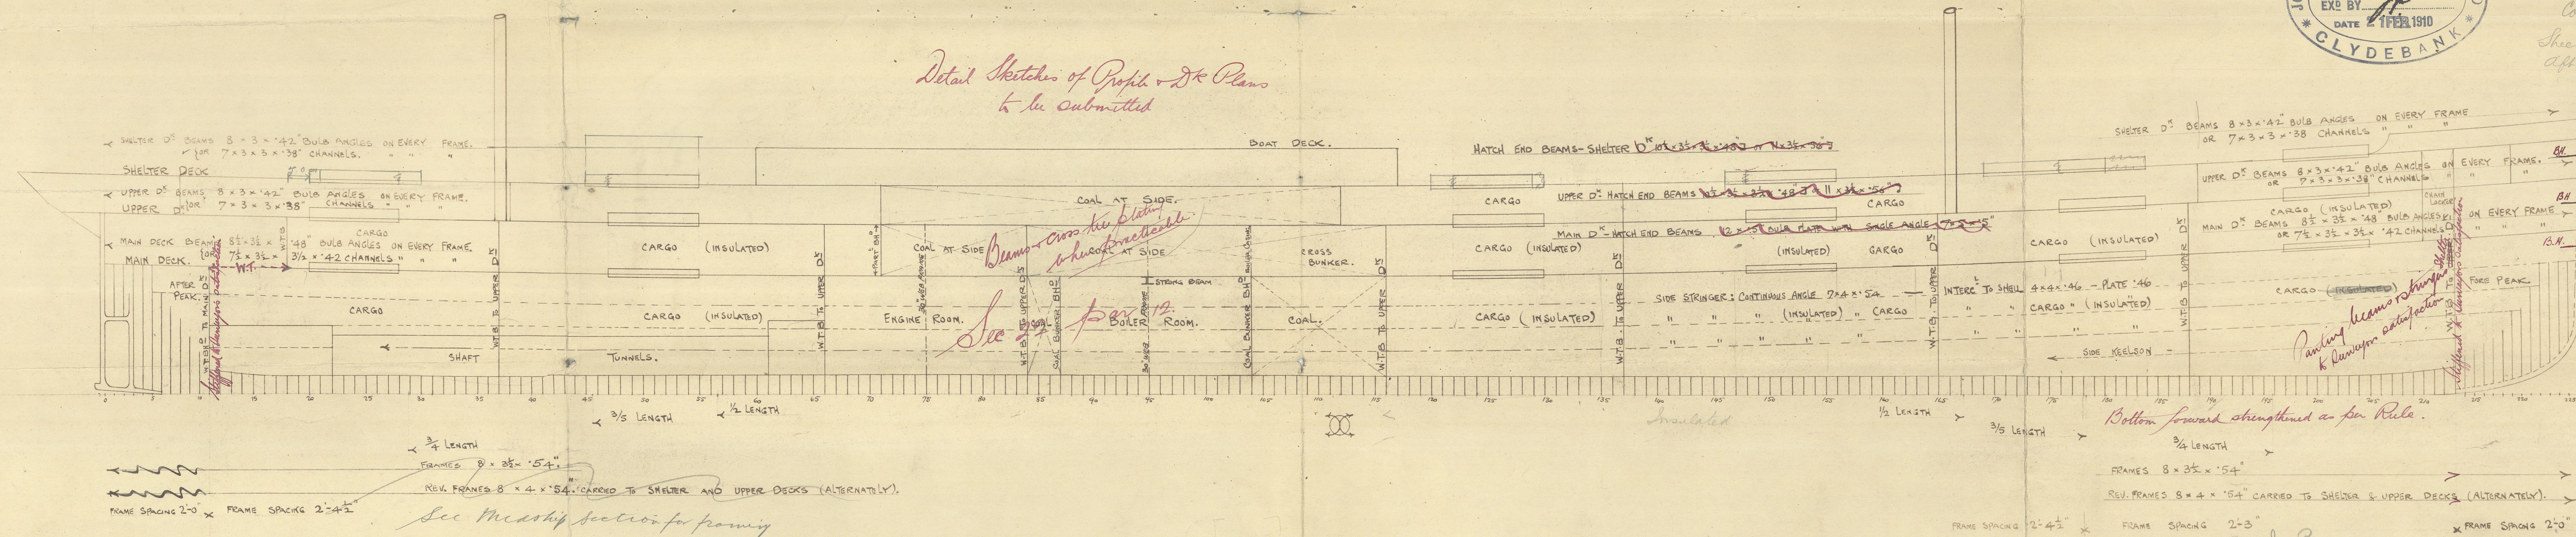

C.F.
23/2/10.

Mr. J. Paterson
Hotel Metropole
Northumberland Av.



© 2020
Lloyd's Register
Foundation




J. Brown & Co

Nos 399, 400 & 401

Profile

399 Argyllshire

GLASGOW REPORT No. 30357

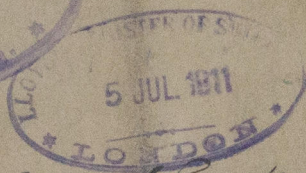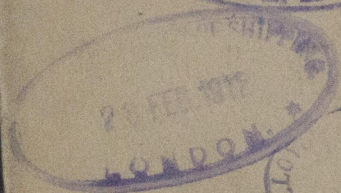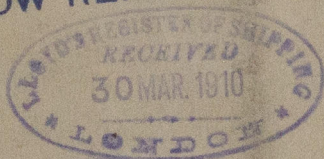


400 S.S. Shropshire

Glasgow Report No 30673

401 S.S. Wiltshire

GLASGOW REPORT No. 31145

RETAINED

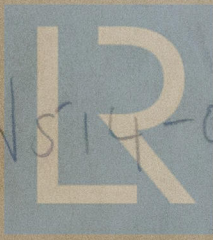

© 2020

WS14-0269

Lloyd's Register
Foundation