



Lloyd's

T.S.S. No 399 - 400 - 401

PROFILE SHOWING DISPOSITION OF BULKHEADS, HATCHES, ETC.

Scale 1/8" = 1 Foot

26 APR 1911

 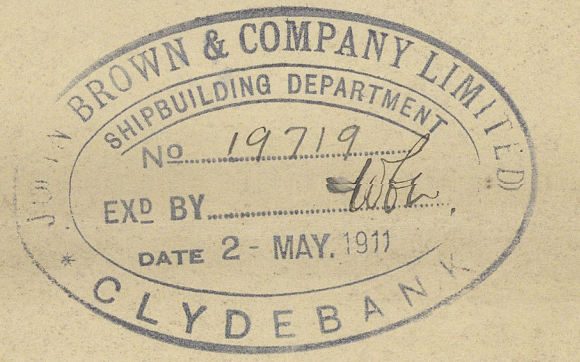

J. Brown & Co Ltd

No 399

"argyllshire"




Profile as built.

GLASGOW REPORT No 30357.

45 "Wiltshire"

GLASGOW REPORT No 31145-

RETAIN

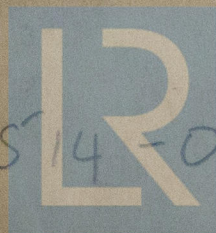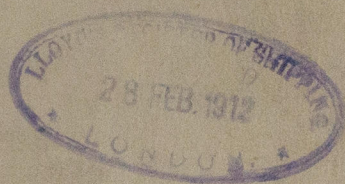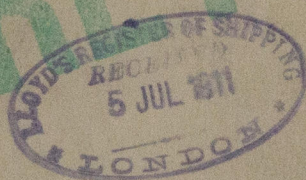

© 2020

WS 14-02 Lloyd's Register
Foundation