

PLATE $1\frac{3}{4}$ " THICK
PIVETS $1\frac{3}{8}$ " Ø (E) MACHINE

FIREBOX STAYS "STEEL" MINIMUM TENSILE STRENGTH 27 TONS PER SQ. INCH
" " "LOWMOOR IRON" " " " 19 " " " "
FOR 7,000 LBS. CONSTANT

A circular library stamp from John Brown & Company, Limited, Engineering Department. The text "JOHN BROWN & COMPANY, LIMITED" is curved along the top, and "ENGINEERING DEPARTMENT" is curved along the bottom. In the center, the date "30 APR 1910" is stamped, with a handwritten signature "R.K." written over it. The stamp is surrounded by a decorative border.

Nº 399.

MAIN BOILERS 2-OFF

SCALE 1" = 1 FOOT

JEM
 6/5/10


97M
6/5/10

Amended Plan.


J Brown & Co Ltd.

No 399.

Single Ended Boiler
W P. 215 lbs².

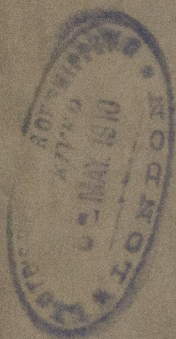

No 10620
Lloyds Cert
430 lbs.
H.C. 12-10-10

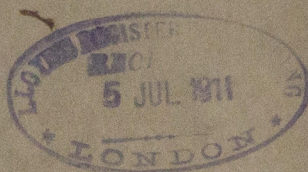

1/2 Argyllshire

GLASGOW REPORT No:

30357

RETAIN

WS74-0271



© 2020

Lloyd's Register
Foundation