



FROM

DIMENSIONS 135 OBP x 23.6 EX x 13-1 MOULDE  
SCALE 1/4 INCH

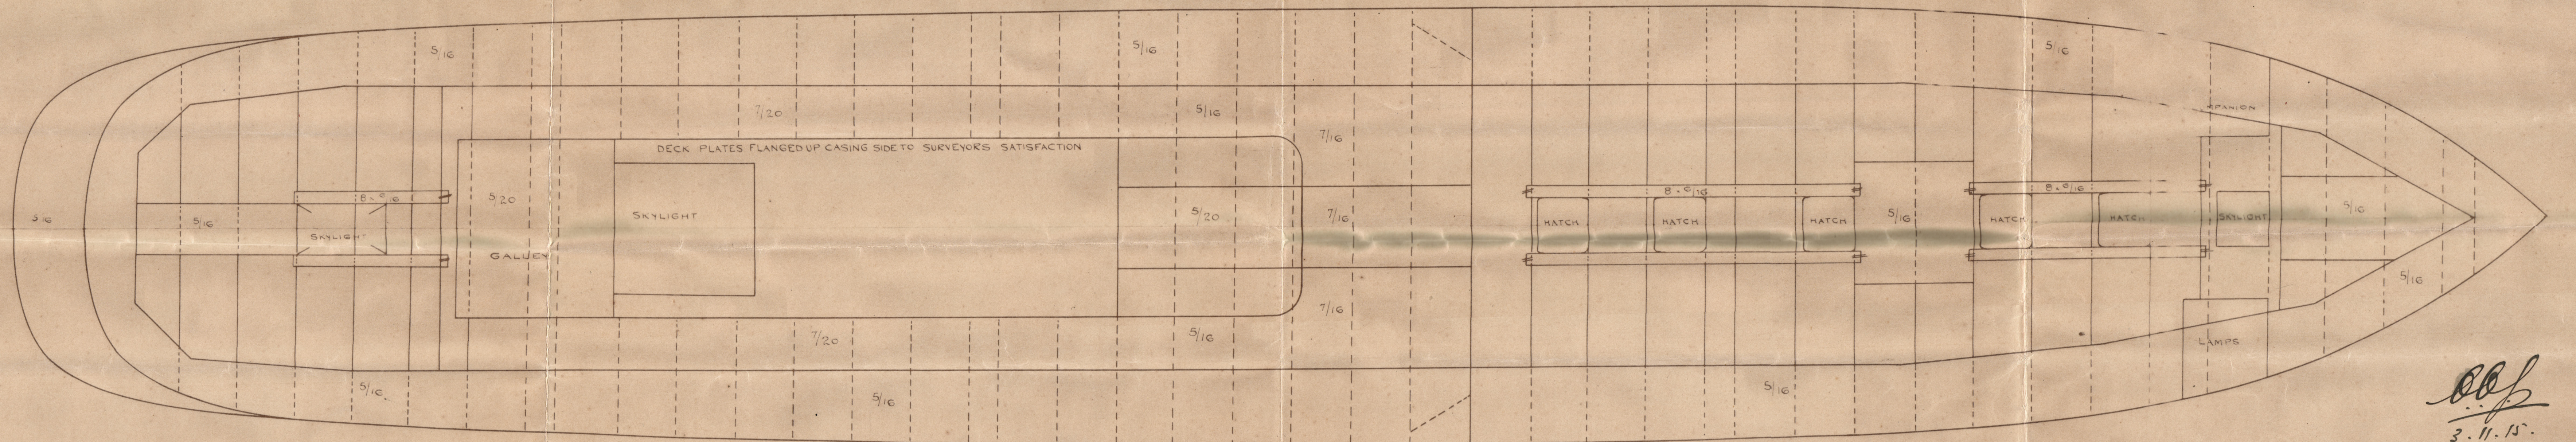

3. 11. 15.

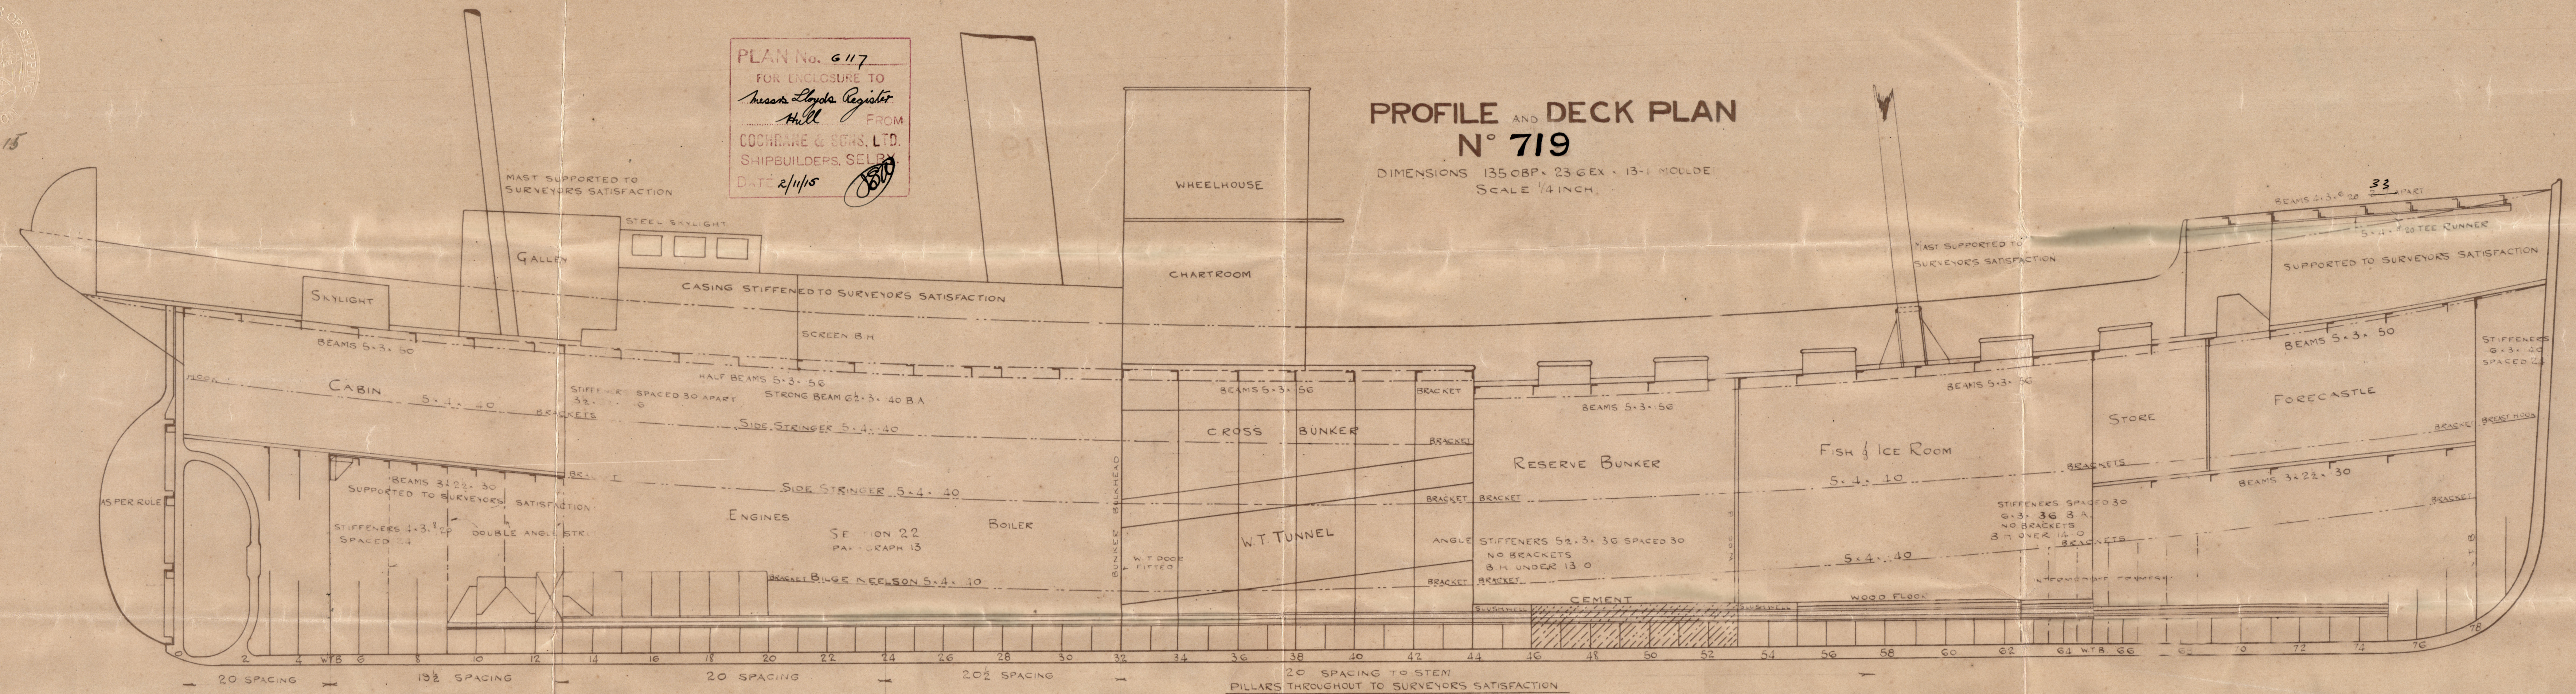

PROFILE & DECK PLAN.


COCHRANE & SONS LTD

No 719



*S. Wynn Evans "Hull" R.R. No. 29421.*

RETAIN

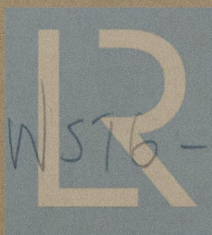

© 2019

W 576 - 0180 Lloyd's Register  
Foundation