


6/2/23

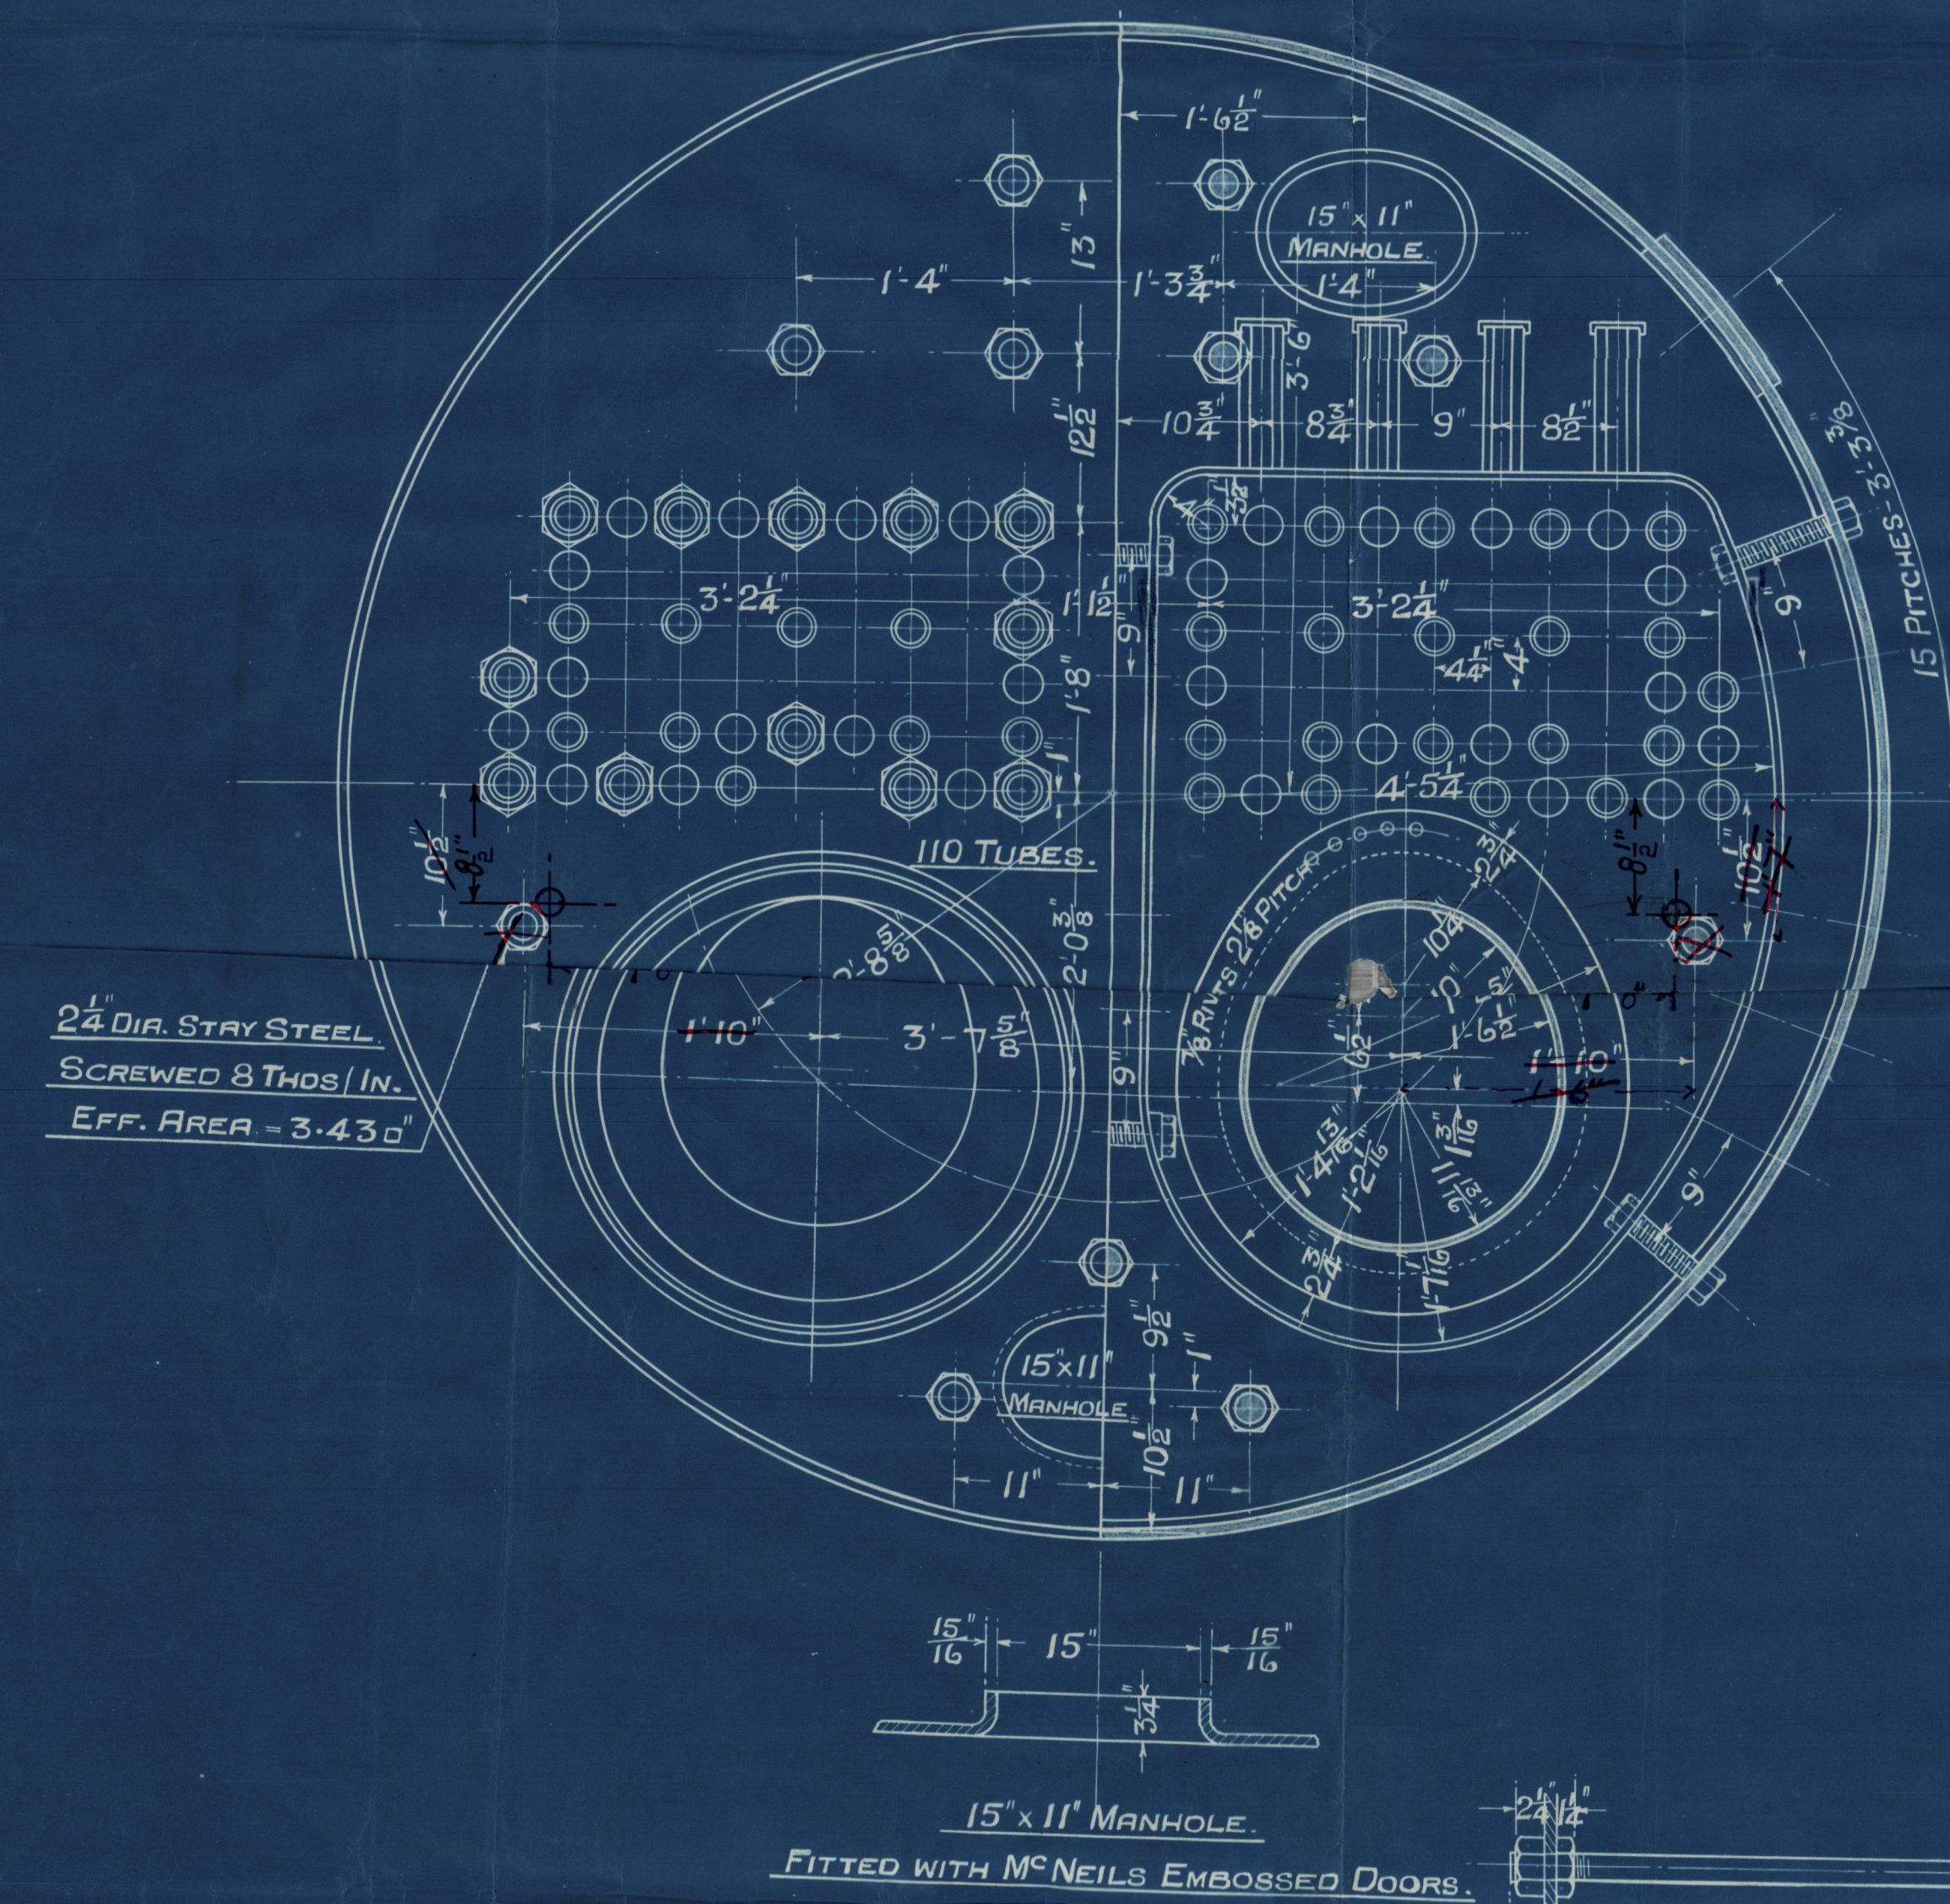



Approved copy Boilers  
7/5 Invercormi

RETAIN

GLASGOW REPORT No. 42764

RETAIN



© 2019

Lloyd's Register  
Foundation

W518-0058