

S.S. NO 1183.

PROFILE DECK PLANS & TRANSVERSE FRAMING IN POOP BRIDGE & FORECASTLE.


DIMENSIONS: LENGTH B.R. 386' 0" BREADTH EX 52' 8 1/2" DEPTH M.L.D. 29' 3"

SCALE 1" = 1 FOOT

SECTION THRO POOP

SECTION THROUGH BRIDGE.

SECTION THROUGH FORECASTLE.


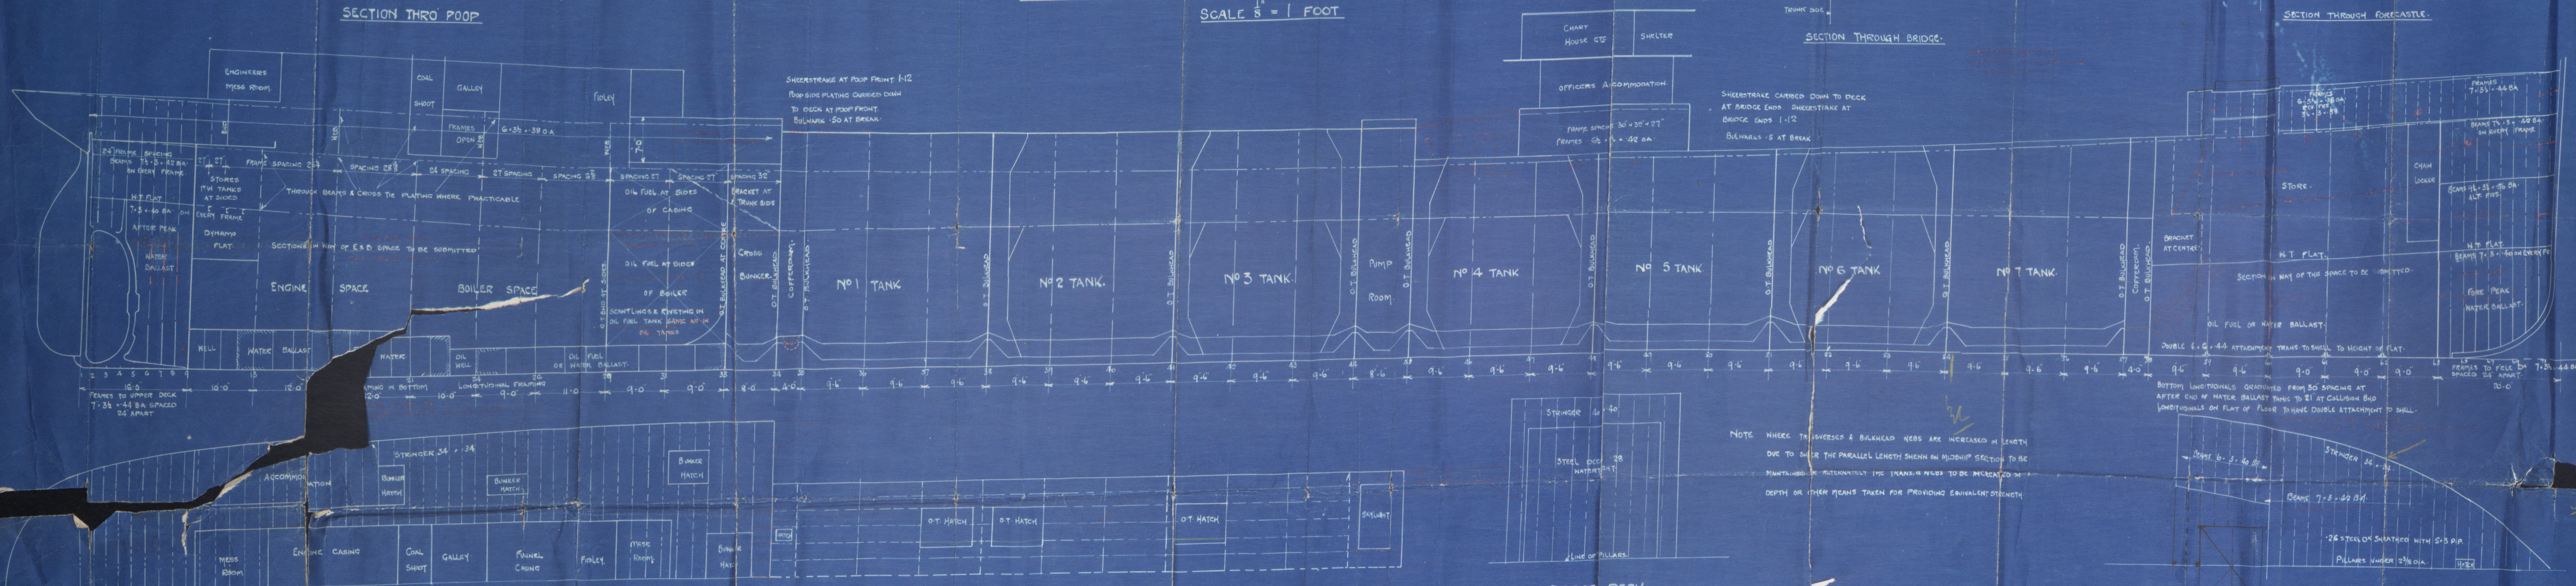


BRIDGE DECK.

FORE DECK.

UPPER DECK.

MAIN DECK.

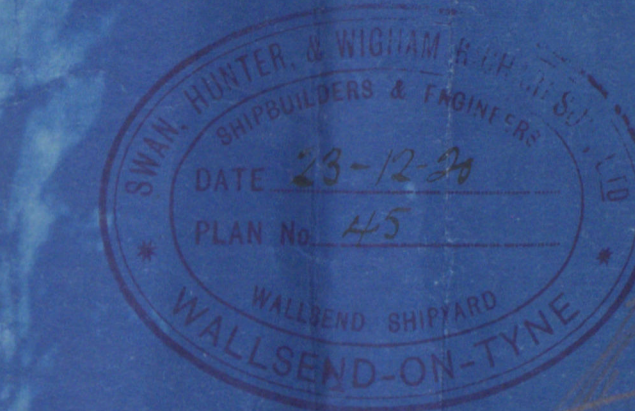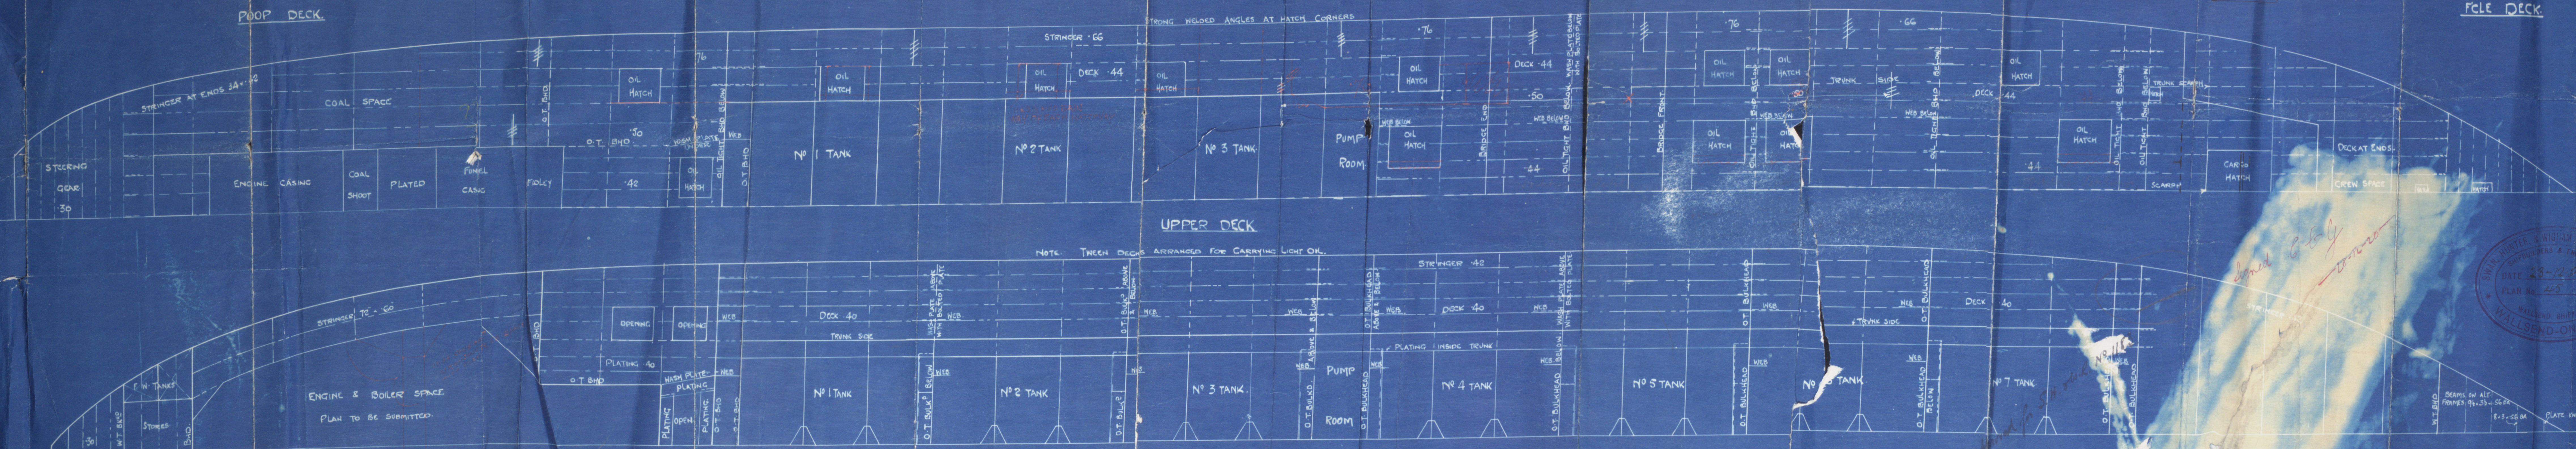

WS8-0210

9-6


11-11

11-11

11-11

1/10 100
Profile Deck Plans &
Transverse Framing
(Approved by Lloyds)

11" Kausicaa"
Ref 8749.

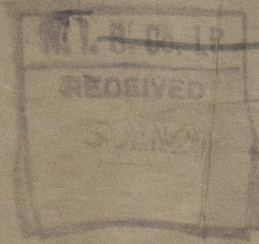


RETAIN

RETAIN



W 518-0210