

17/12/25

EQUIPMENT		NUMBER
2 BOWER ANCHORS	10 CWTs	Stockless
STREAM	104	EN STOCK
210 FATHOMS	15	STUP. LINES
50	24	STEEL WIRE
90	1 1/4	

EQUIPMENT		NUMBER
BRIDGE	83	775 + 75
FORECASTLE	83	775 + 75
		220 08
		9322.24


• **Nº 993.**

DIMNS - 190' 0" BP x 31' 3" MLD x 15' 0" MLD
 TO CLASS 100A1 + LLOYDS
 SCALE 2" = 1' 0"

NUMERALS

L.D.	2850
L. (B.D.)	3787.50
d. to main d.	12.45
to	12.66

(13.25 + 7.140)
Waterman

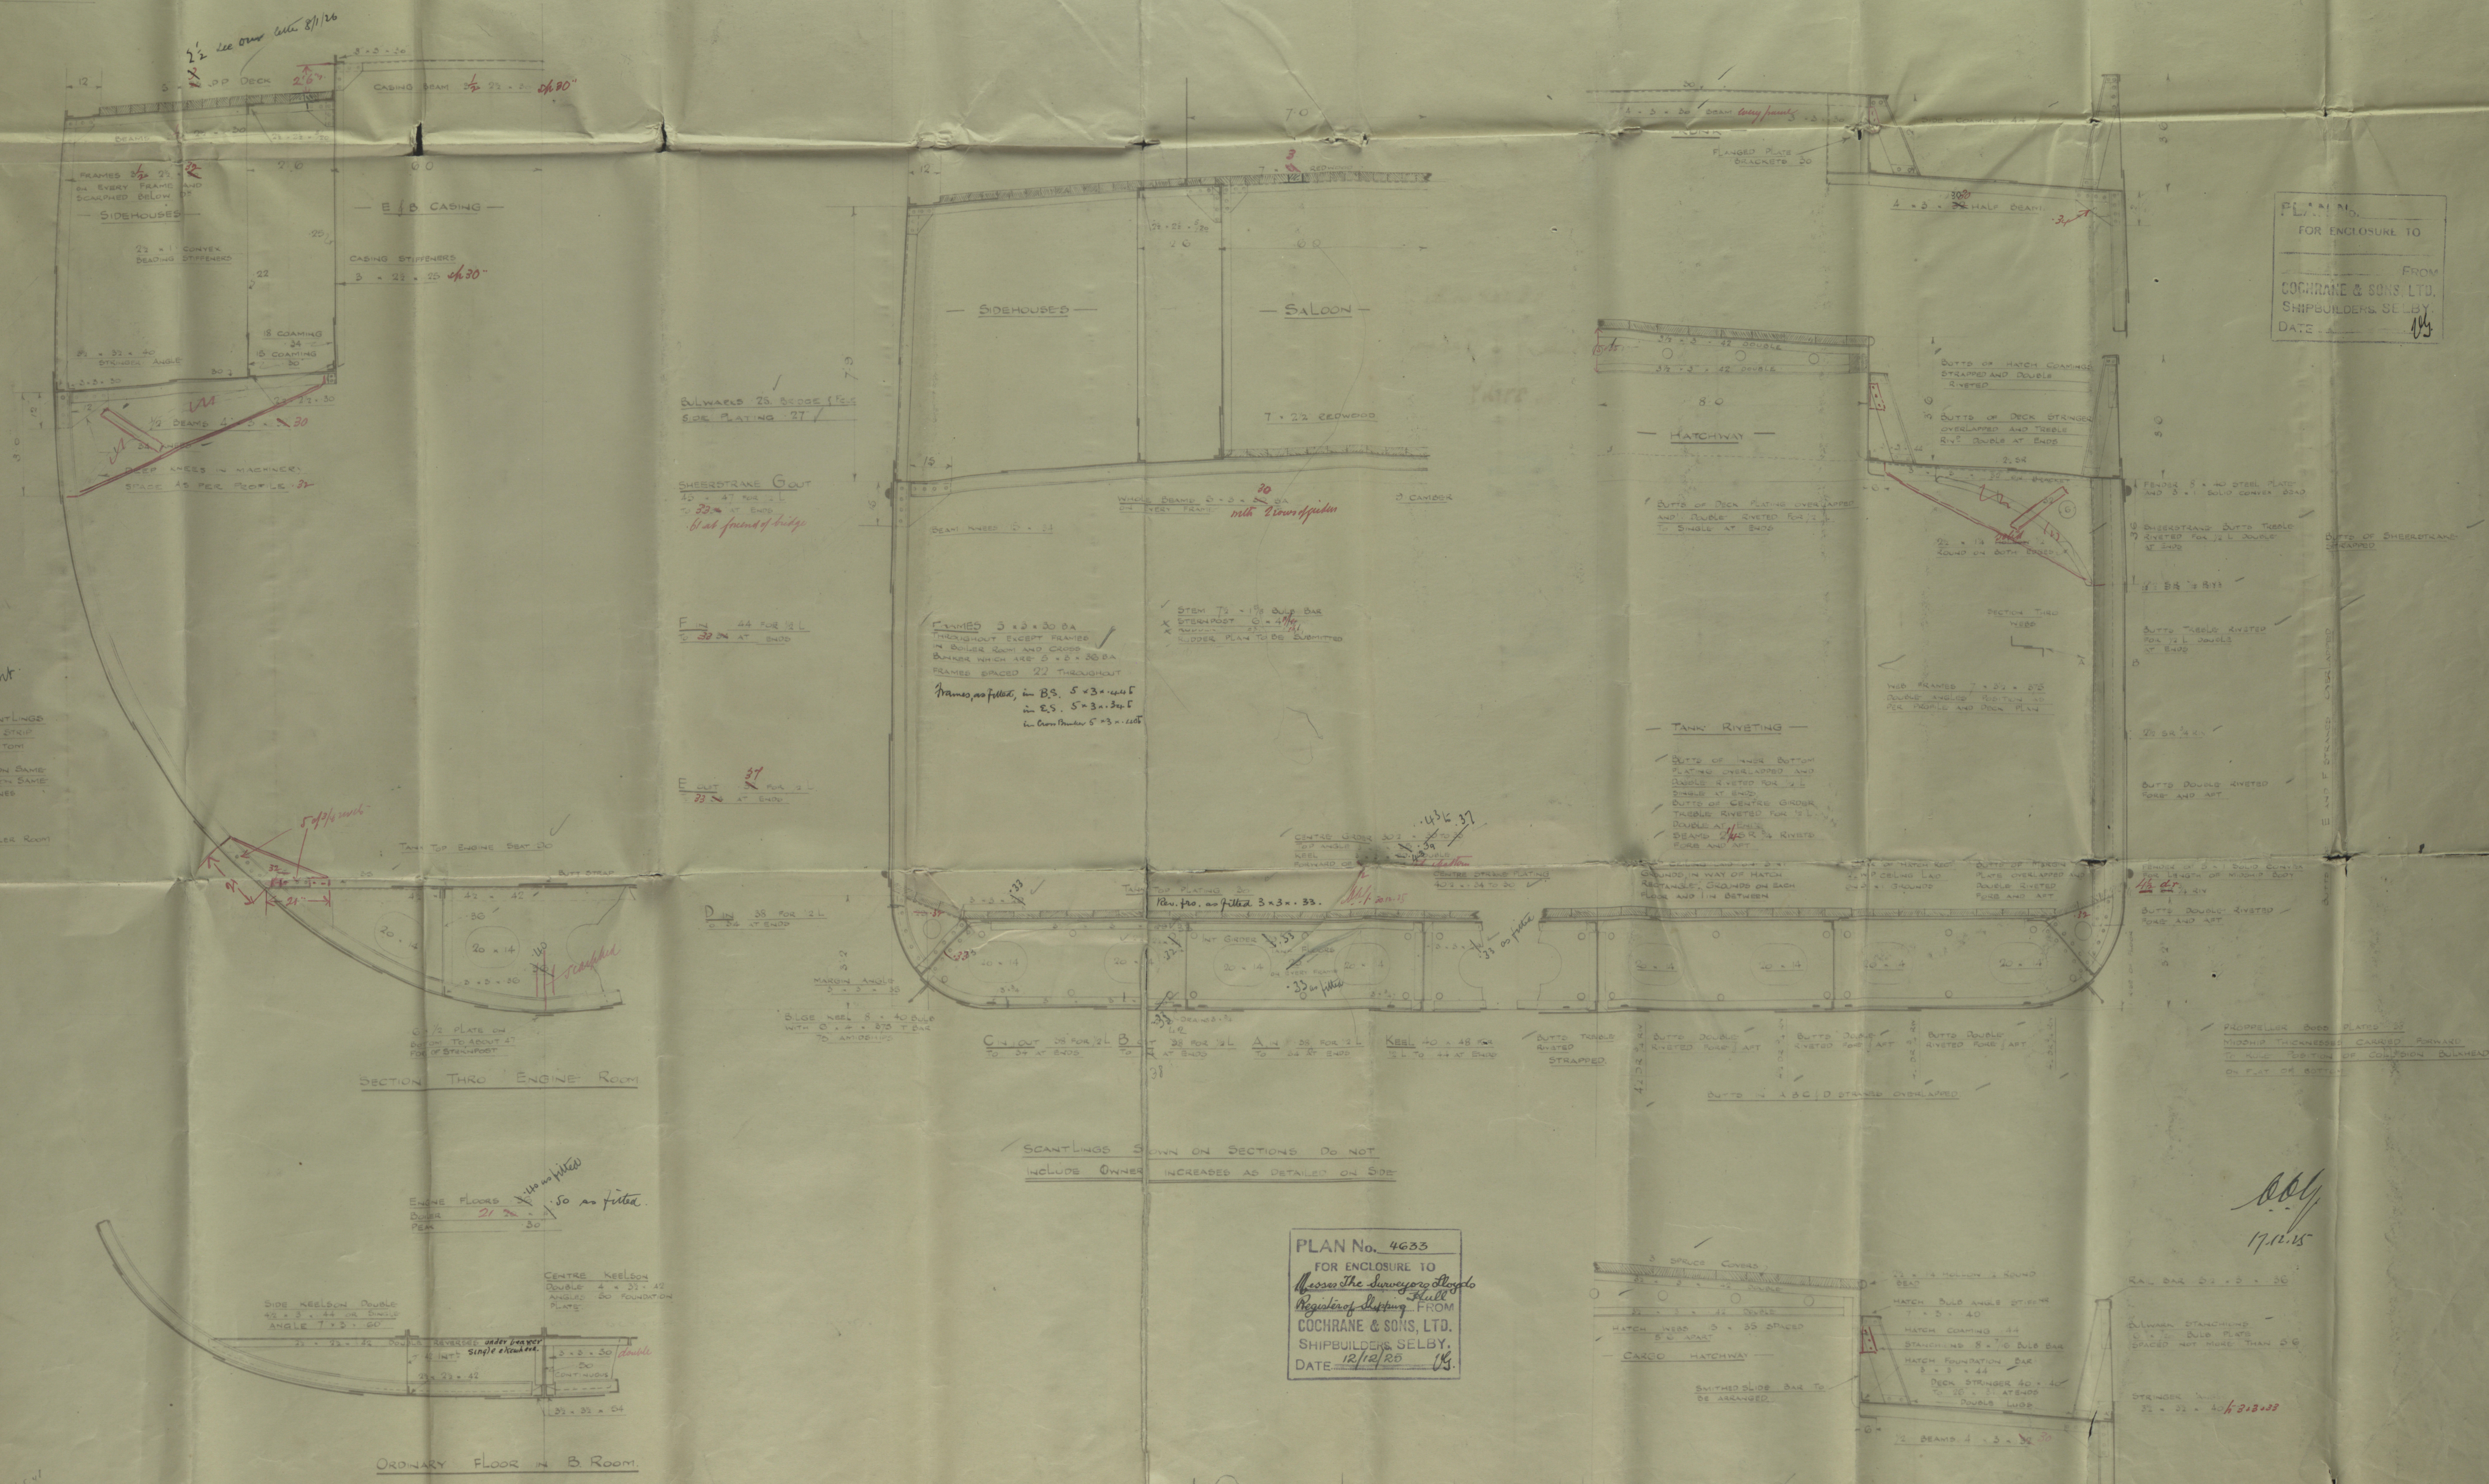

PLAN No. 4633
 FOR ENCLOSURE TO
 FROM
 COCHRANE & SONS LTD.
 SHIPBUILDERS SELBY
 DATE 12/12/25

17.12.25

WS19-0184

Muskeg Section

Cochrane is

No 993

S.S. Kakwiski

Issue 4. E. Report-

No. 37124

RETAIN



© 2019

Lloyd's Register
Foundation