


19.4.13

28.4.13

BRIDGE-SIDE PLATING.

S.S. 57.

SCALE = $\frac{1}{2}$ " = 1 FOOT.

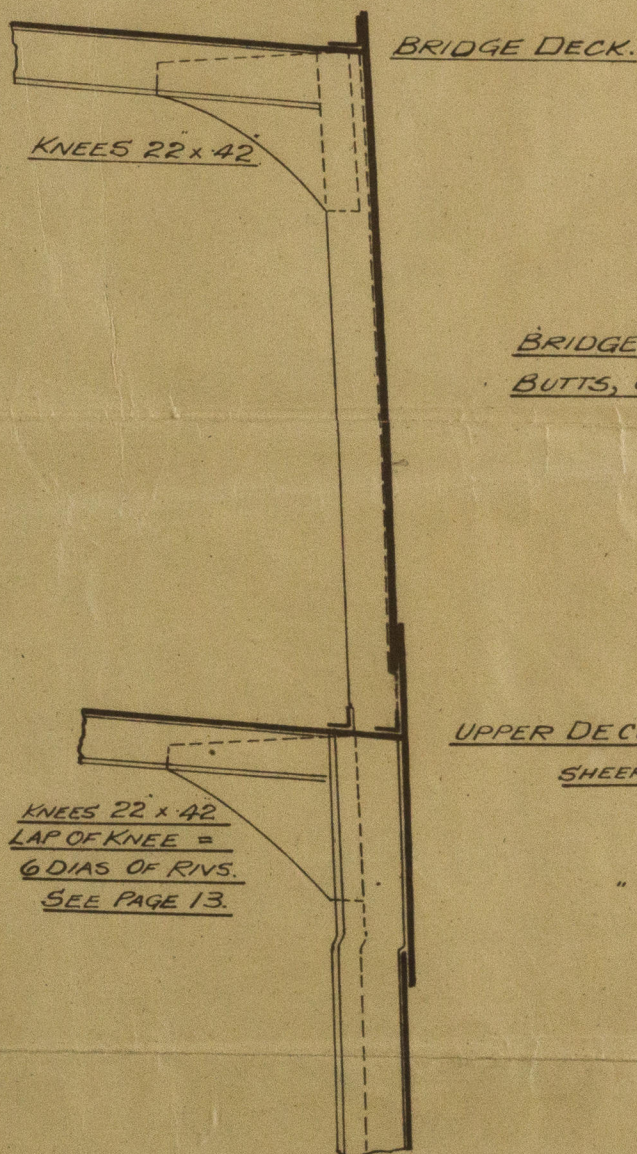

BRIDGE SHEERSTRAKE 93 x 66.
BUTTS, OVERLAPPED & QUAD RIV.
Quantuple

UPPER DECK.

KNEES 22 x 42
LAP OF KNEE =
6 DIAS OF RIVS.
SEE PAGE 13.

SHEERSTRAKE CLEAR OF BRIDGE
48 x 1.02 FOR $\frac{1}{2}$ L.
IN BRIDGE 48 x 62.
TO 48 x 46 AT ENDS.
DOUBLED AT ENDS OF BRIDGE.
RIVETING AS PER RULE

C.B.

J.M.

19.4.13





WS2-0046

North of Ireland S.B. Co.

Nº 57

Alteration to Bridge
Side plating.

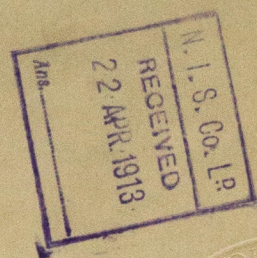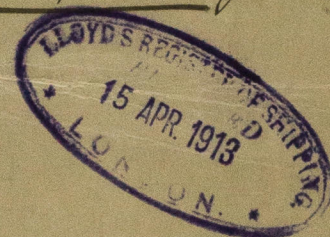

© 2021

Lloyd's Register
Foundation