

The Greenock Dockyard Co. Ltd.
Greenock

No. 419. Profile and Decks.


SCALE 2" = 1'-0"

M.L.D. DIMS: 420'-0" x 59'-0" x 27'-9" / 36'-3" TO UPPER DECK.
BULB ANGLES TO 1924 BRITISH STANDARD EXCEPT WHERE STATED.

L = 420'-0" D = 35'-15" B = 59'-0" d = 23'-26"

TO CLASS 100 A1. (WITH FREEBOARD) COMPLETE SUPERSTRUCTURE WITH TONNAGE OPENING.

FILLING UNDER WIND-ASS. WIND-NEP. MATIS. ETC. TO SURVEYORS SATISFACTION.

 

APPROVED
LLOYD'S REGISTER OF SHIPPING
29.8.29.

2ND DECK

The Great Dock of
LAGOSIAN Ex
S. I. MELMAY.

N. 419

Profile & B. plans.


WS.

4

Gr. 1st E. Ref. N. 1923

1920

Profile.

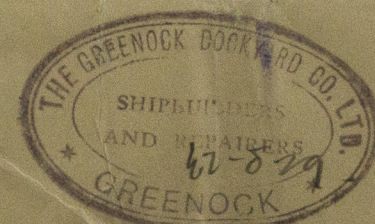

WS2-0068



© 2021

Lloyd's Register
Foundation