


LONGITUDINAL SECTION. S.S. NO 159.

15.10.10
25.10.10
29.10.10

DIMENSIONS.
LENGTH B.P. 352'-6"
BREADTH EXT. 50'-10"
DEPTH MLD. 27'-4"
SCALE 1/8" = 1 FOOT.

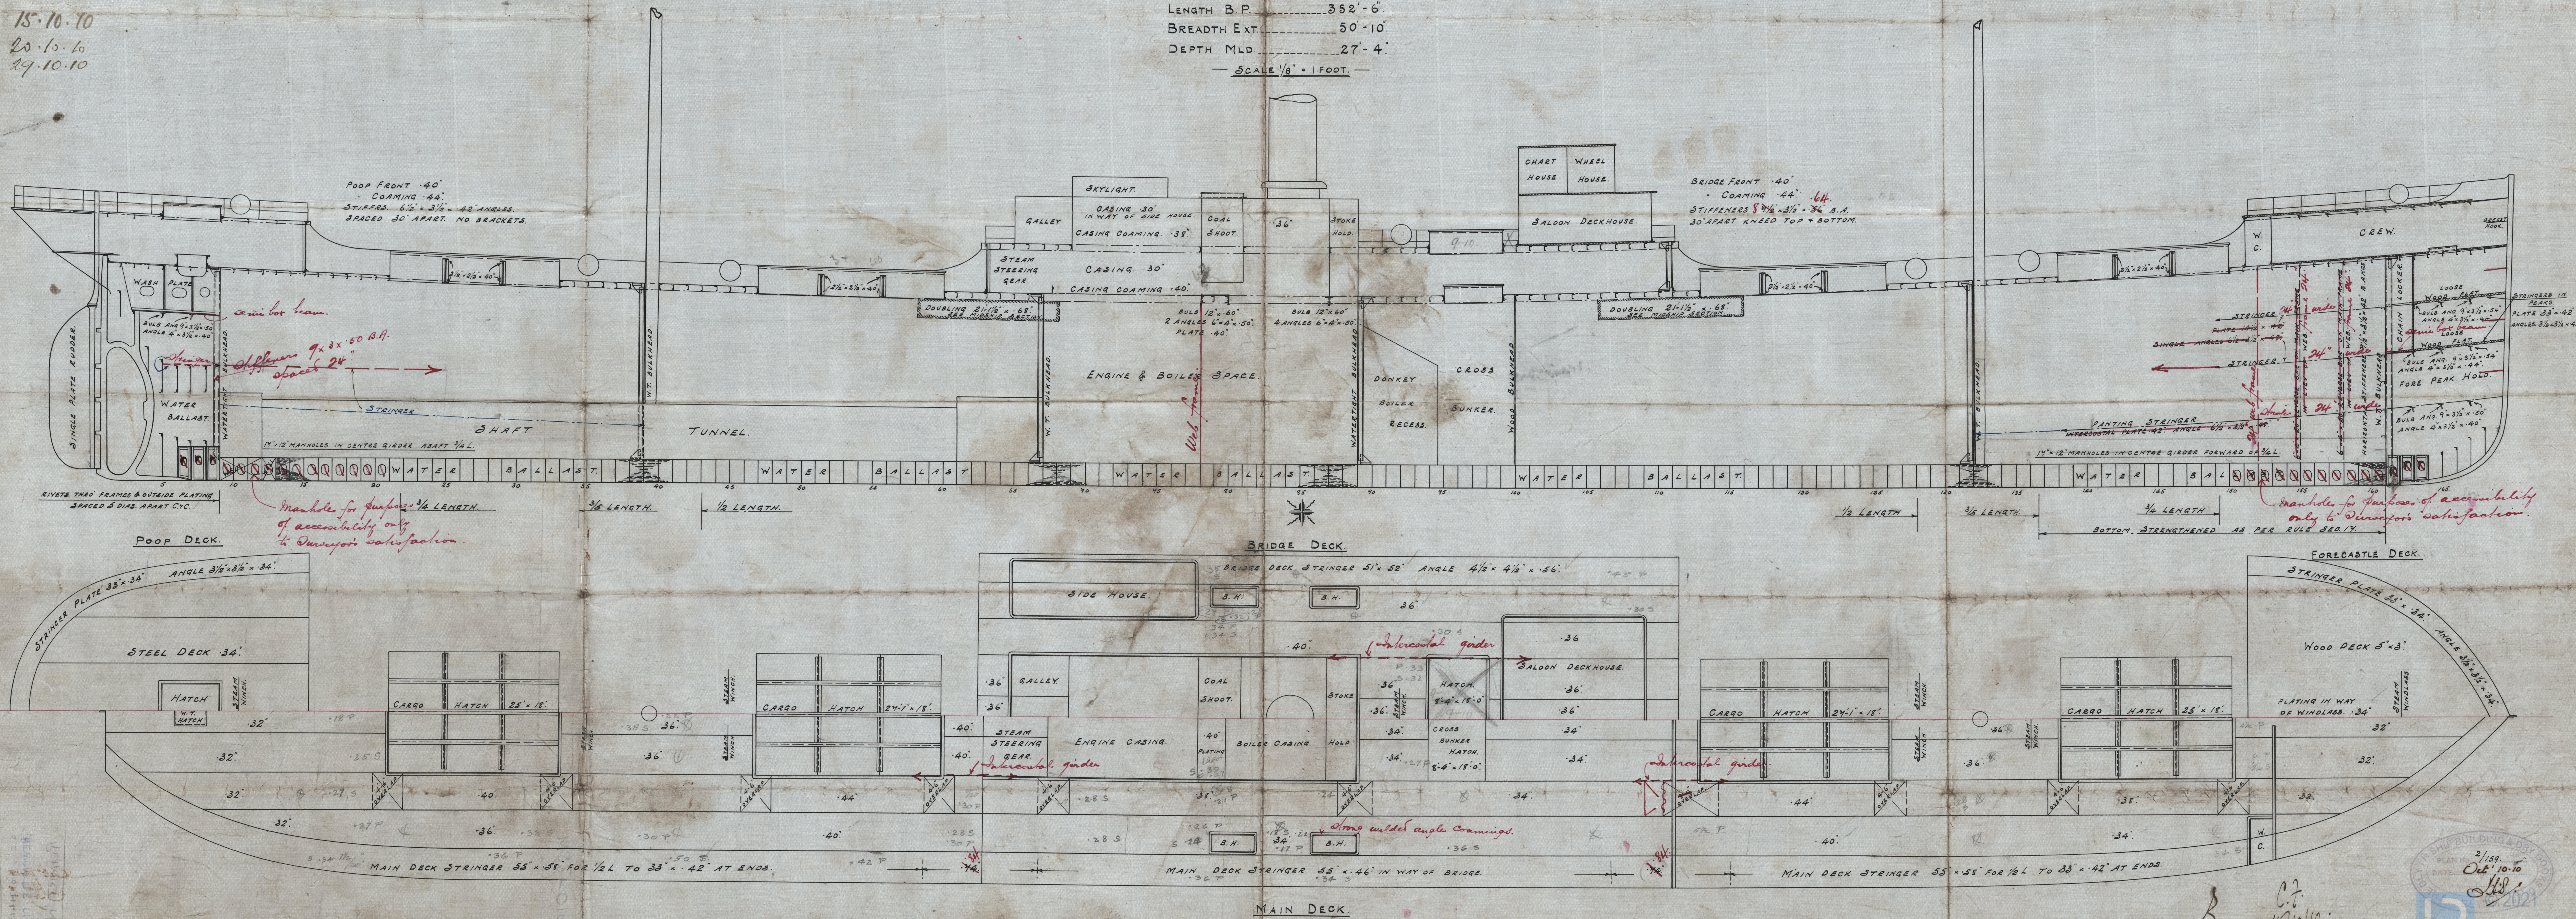

BLYTH. S.S. N°159

PROFILE.

Kyima

S.S. "ROTHLEY"
NEWCASTLE - ON - TYNE.

REPORT N°61138

© 2021

Lloyd's Register
Foundation

W52-0193