

(1)


C

Latest

Standard Vessel

Edward Amherst 364

Checked with app^d plans.
Industries Section

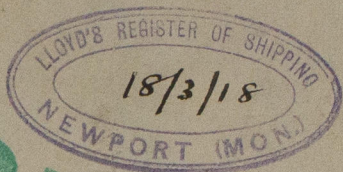

RE-MAIN
No 3

Mar Caspio

RE-MAIN

W520-0198



© 2020

Lloyd's Register
Foundation