


C. (2)

Standard Vessel

Edward Smith & Co 3624

Deck & Profile plan

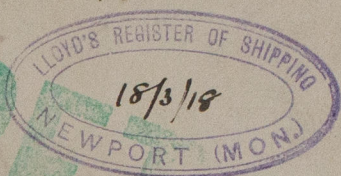

Checked & found to
agree with London plan
dated 10/11/17

Mar Caspio

W520 - 0199



© 2020

Lloyd's Register
Foundation