


SCALE $\frac{1}{8}'' = 1 \text{ FOOT}$

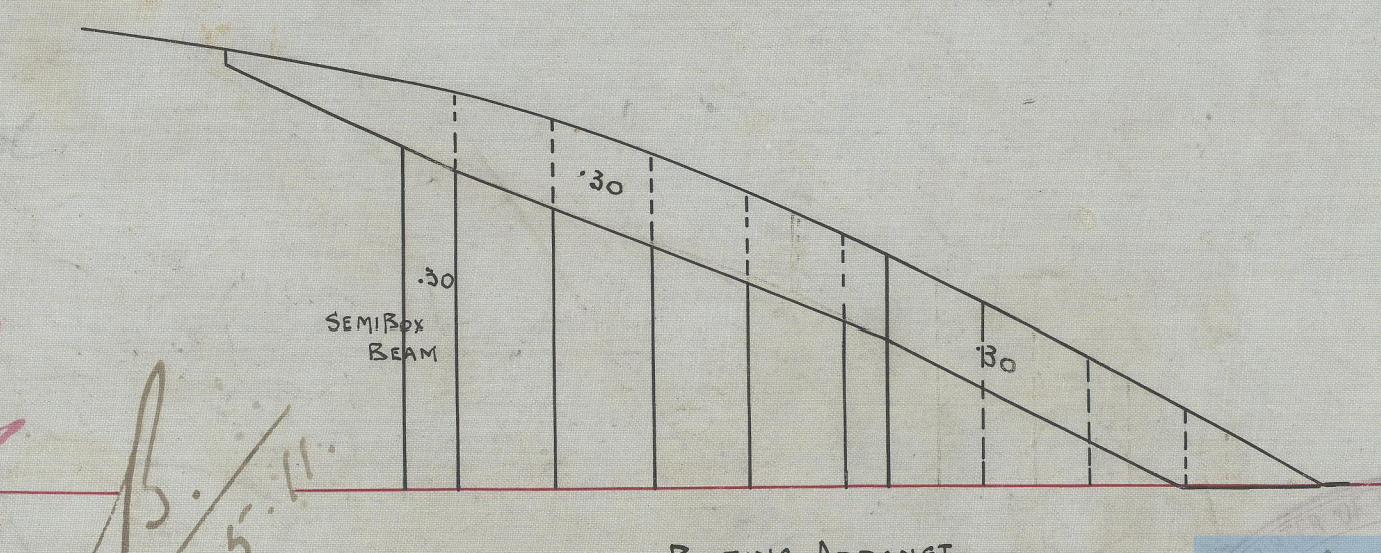

Profile & Deck Plans.
R. Duncan to Ed. S.S. No 320

RETAIN

S/S. Agnes Duncan
Greenock Report No 16283

RETAIN

W521-0077



© 2021

Lloyd's Register
Foundation