
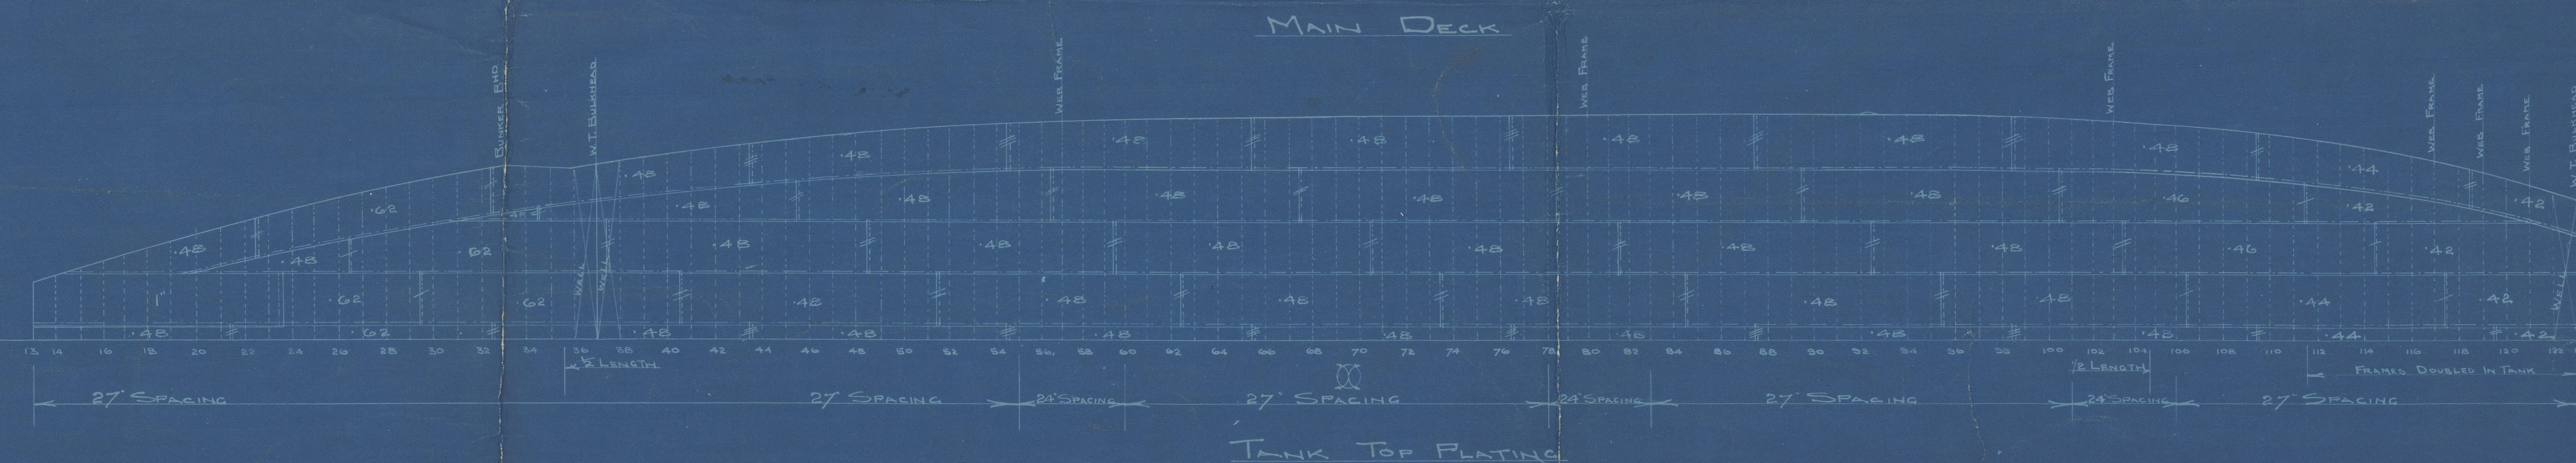
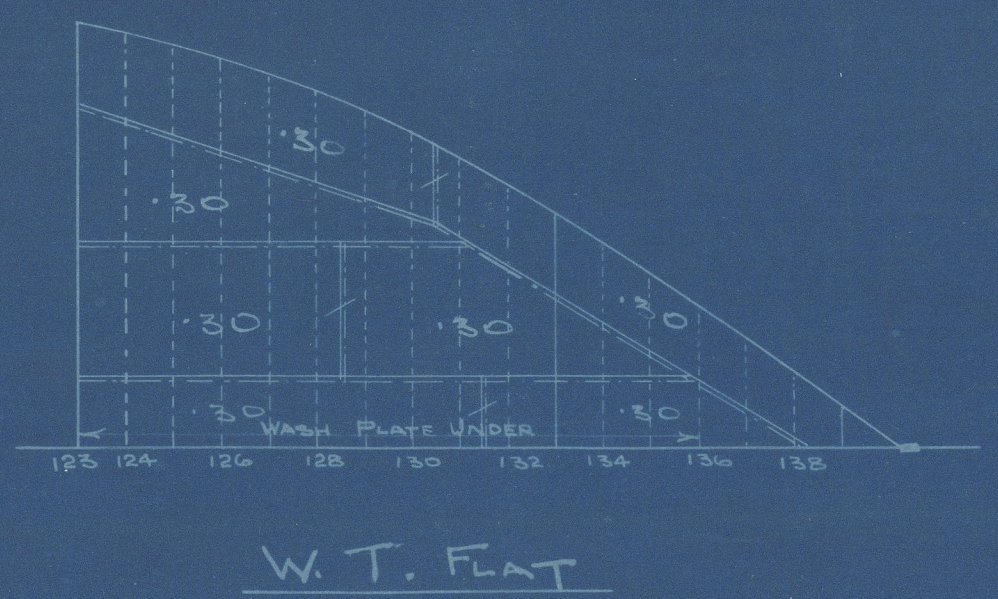
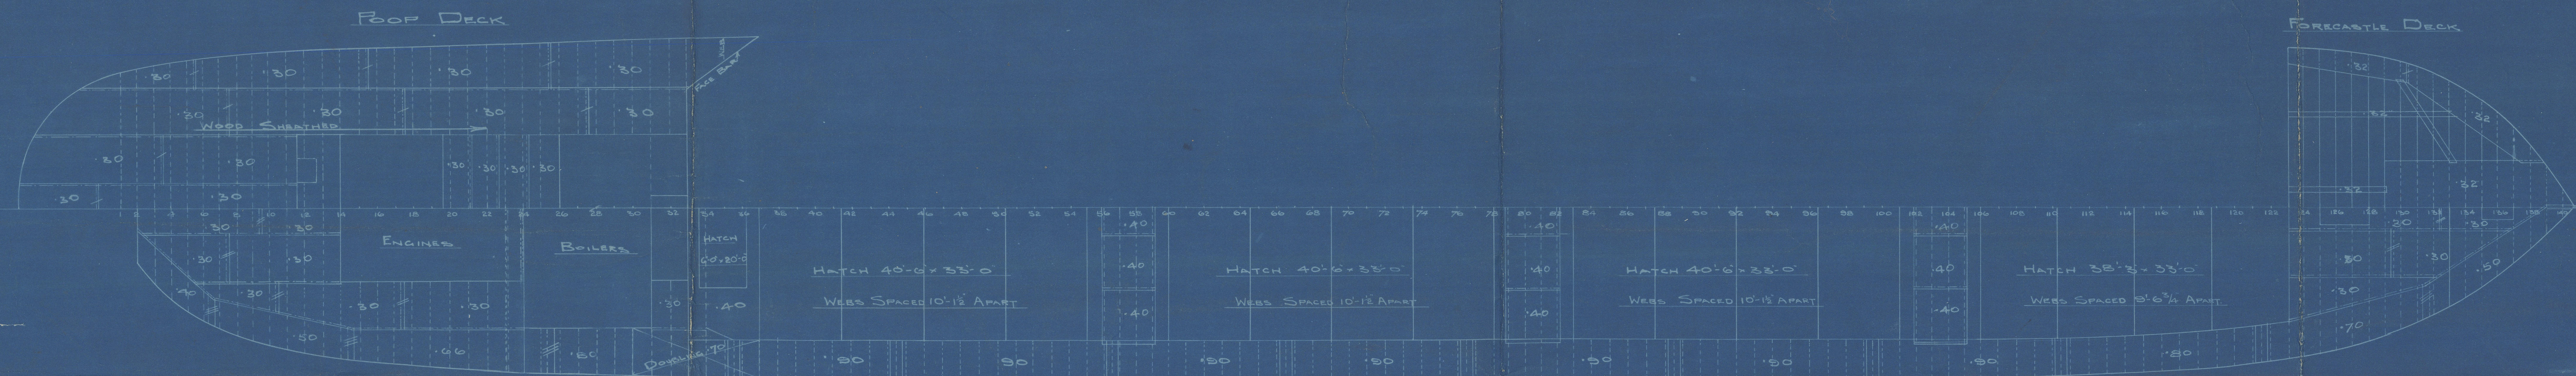


GENERAL ARRANGEMENT OF STEEL WORK AS FITTED

S. S. "AGNES DUNCAN"

DIMENSIONS 305'-0" x 43'-0" x 22'-7 1/2" M^{LD}.

SCALE 1/8" = 1 FOOT.

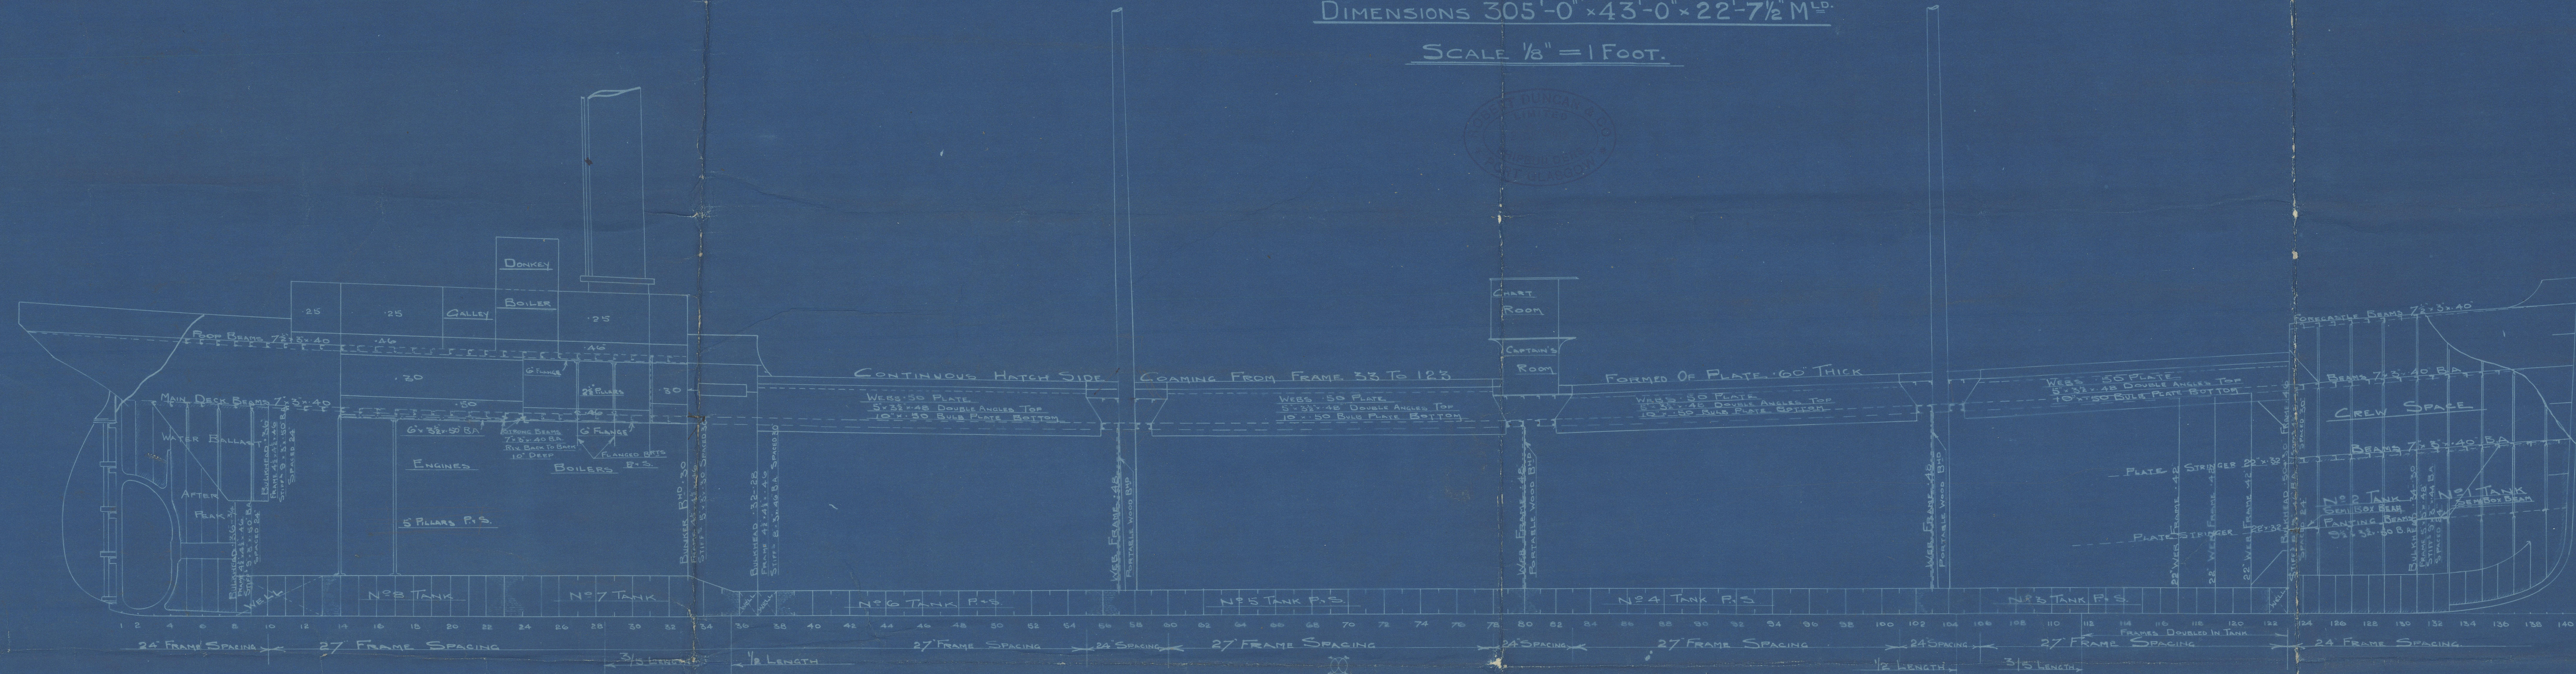

Profile of Deck Plan
R. Duncan to No 320

BOUG

J. Agnes Duncan
Greenock Report No. 16-283

RETAIN W. 135.



RETAIN

W521-0087



© 2021

Lloyd's Register
Foundation