

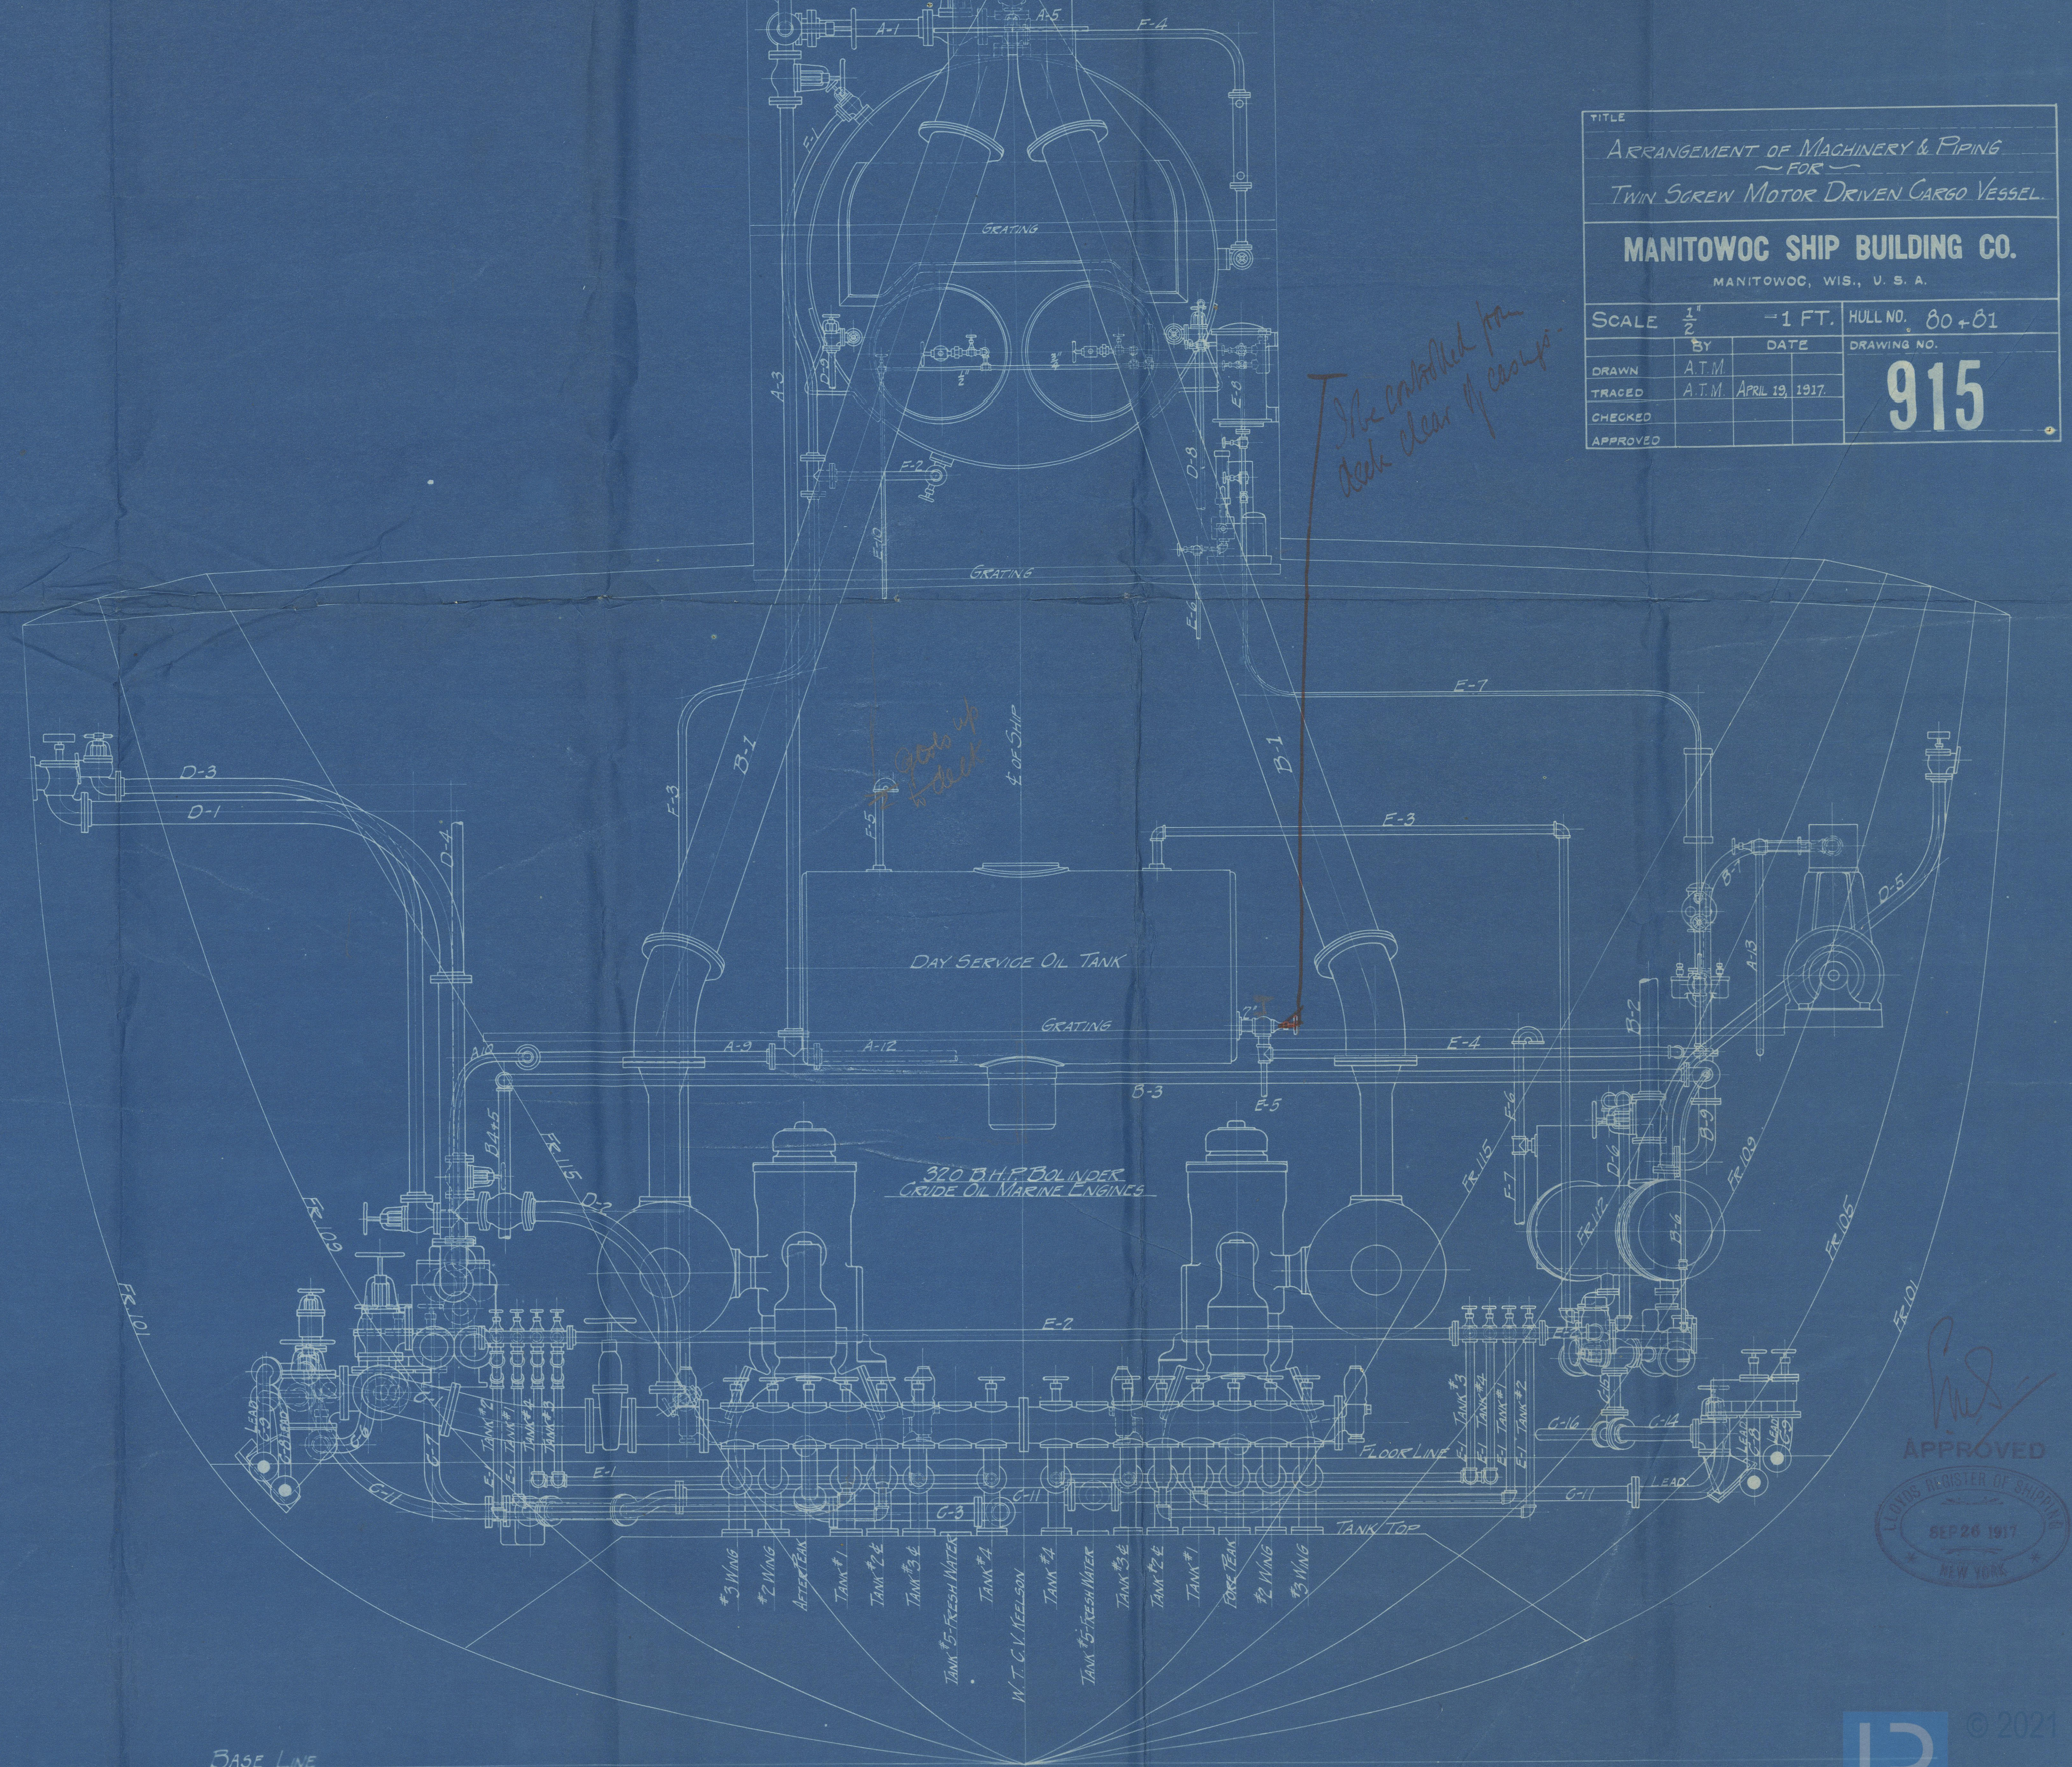


Mk.	Size	Wt.	Mat.	Description
A-1	3"			EXHAUST MAIN STEAM
A-2	3"			STEAM FORWARD TO WINGLES
A-3	2 1/2"			TO ENGINE ROOM
A-4	1 1/2"			TO STEERING ENGINE
A-5	1 1/2"			TO WHISTLE, FUEL OIL HEATER + PUMP
A-6	1 1/2"			TO HEATING SYSTEM - REDUCED TO 30"
A-7	1 1/2"			TO FUEL OIL HEATER + PUMP
A-8	1 1/2"			TO PUMP
A-9	2"			TO BALLAST + GENERAL SERVICE PUMPS
A-10	1 1/2"			TO PUMP
A-11	1 1/2"			TO GENERAL SERVICE PUMP
A-12	2"			TO BOILER FEED PUMP, AIR + CIRC. PUMPS,
A-13	1 1/2"			GENERATOR, + DAY OIL TANK PUMP
A-14	1 1/2"			TO GENERATOR
B-1	4" x 2"			W.I. MAIN EXHAUSTS FROM MOTORS
B-2	4"			2nd LWS. EXHAUST FROM WINGLES
B-3	2 1/2"			BALLAST, GENERAL SERVICE + OIL PUMPS
B-4	2"			PUMP
B-5	2"			GENERAL SERVICE PUMP
B-6	2"			DAY OIL TANK PUMP
B-7	2"			GENERATOR
B-8	1 1/2"			BOILER FEED, FUEL OIL + AIR + CIRC. PUMPS
B-9	3"			C.I. TO CONDENSER
B-10	3"			THRU SAFETY VALVE ESCAPE PIPE
C-1	8"			C.I. BALLAST MANIFOLD CONNECTION TO SEA + PUMP
C-2	6"			C.I. SUCTION - BALLAST PUMP FROM SEA + MANIFOLD
C-3	3"			C.I. MANIFOLD FROM AFTER PEAK
C-4	3"			C.I. GENERAL SERVICE PUMP FROM MANIFOLD
C-5	3"			C.I. GENERAL SERVICE PUMP FROM BALLAST TANKS
C-6	3"			C.I. PUMP CONNECTION TO SEA
C-7	3"			C.I. DILGES
C-8	3"			C.I. DILGE MANIFOLD FROM HOLD #1 - F + S
C-9	3"			C.I. FROM DILGE MANIFOLD
C-10	3"			C.I. FROM DILGE MANIFOLD
E-1	1 1/2"			2nd LWS. OIL MANIFOLD SUCTIONS FROM TANKS
E-2	2"			DAY OIL TANK PUMP SUCTION FROM MANIFOLD
E-3	1 1/2"			DISCHARGE TO DAY SERVICE TANK
E-4	1 1/2"			FUEL OIL PUMP SUCTION FROM
E-5	1 1/2"			ENGINE
E-6	1 1/2"			STARTER
E-7	1 1/2"			FUEL TANK DISCHARGE TO HEATER
E-8	1 1/2"			FUEL OIL TO BURNERS
E-9	1 1/2"			STARTER DISCHARGE TO BURNERS
E-10	1 1/2"			RETURN TO SUCTION LINE
F-1	1 1/2"			2nd LWS. SURFACE BLOWOFF
F-2	1 1/2"			BOTTOM
F-3	1 1/2"			BLOWOFF DISCHARGE OVERBOARD
F-4	1 1/2"			WATER COLUMN
F-5	1 1/2"			SERVICE TANK VENT
F-6	1 1/2"			FEED
F-7	1 1/2"			OVERFLOW TO FRESH WATER TANKS

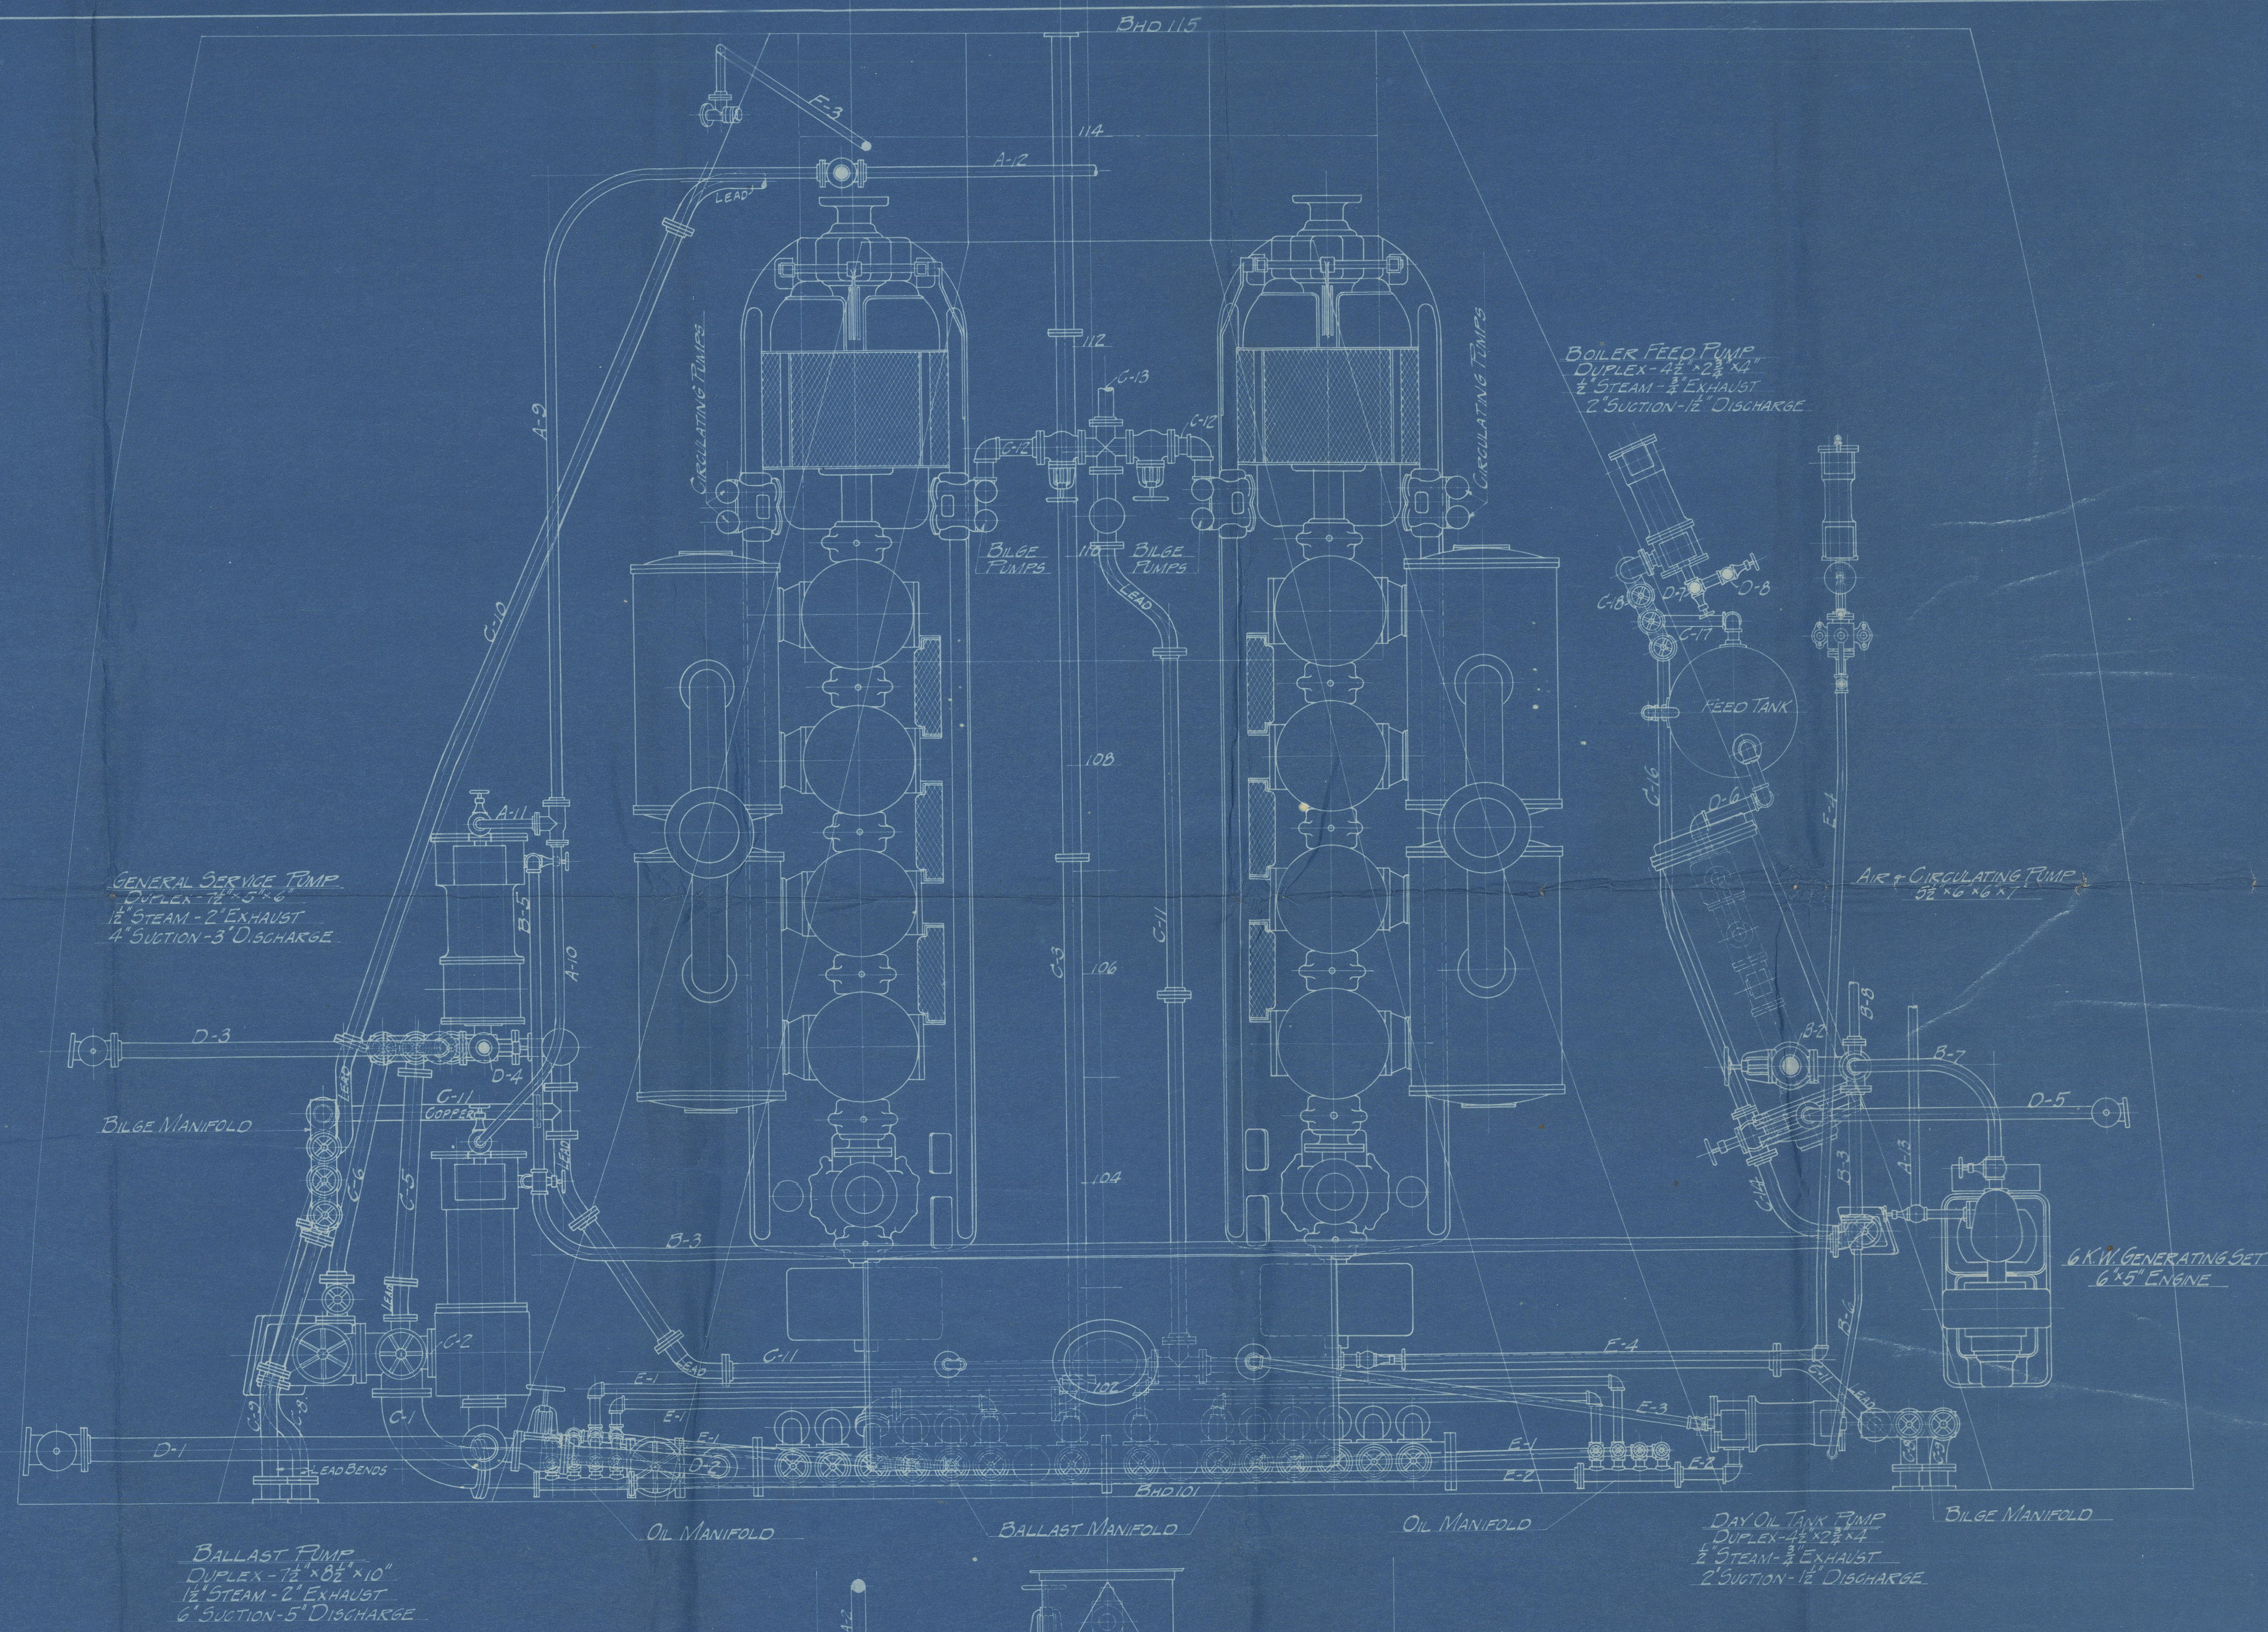

TITLE			
ARRANGEMENT OF MACHINERY & PIPING			
FOR			
TWIN SURE MOTOR DRIVEN CARGO VESSEL			
MANITOWOC SHIP BUILDING CO.			
MANITOWOC, WIS., U.S.A.			
SCALE	1/4"	1 FT.	HULL NO. 80+81
DRAWN	BY	DATE	DRAWING NO.
TRACED	ATM	APR 19, 1917	915
CHECKED			
APPROVED			

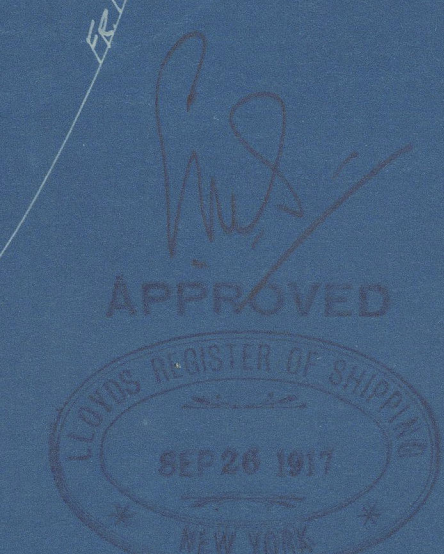

Manitowoc S. B. Co.

Bills 80 and 81.

General Arrangement
of Machinery.

H. R. McCLELLAND

"Ada" *for Surveyor*

Chicago

Oil Fuel Pumping
Augt.

#51

REMAIN
RECEIVED
JUN 1972
LONDON



© 2021

Lloyd's Register
Foundation

W521-0219