

MIDSHIP SECTION S S N^O 187-8.


TO CLASS 100A AT LLOYDS

FN 55.45 x 181.5 = 10064 PN.



R. Williamson & Son

Nos 187 & 188

Midship Section

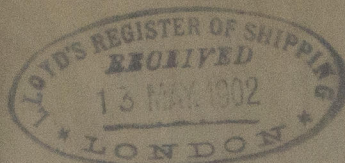





187¹⁸

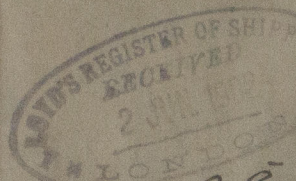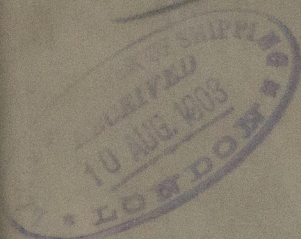

Pylades
Brow 1141

188. SS Vorada

Brow 1281

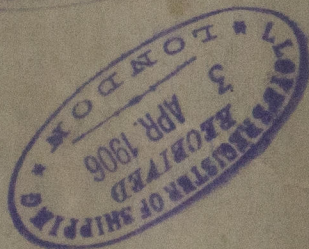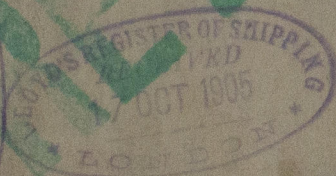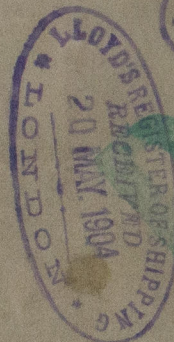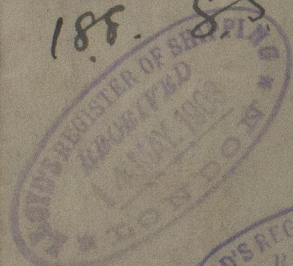

W523-0063



© 2020

Lloyd's Register
Foundation