

ACT. GES. NEPTUN ROSTOCK

S. S. N° 230

DIMENSIONS


LENGTH	213.0
BREADTH MOULDED	30.6
DEPTH	16.4
" " AS PER RULES	17.0
BREADTH TO LENGTH	6.98
DEPTH TO	12.52

SCALE 1/25

MATERIAL. SIEMENS. MARTIN STEEL.

NUMERALS.

HALF BREADTH MID.	15.25
DEPTH AS PER RULES	17.00
1/2 GIRTH	29.37
SMALL NUMERAL	61.62
	213
LARGE NUMERAL	13125.0

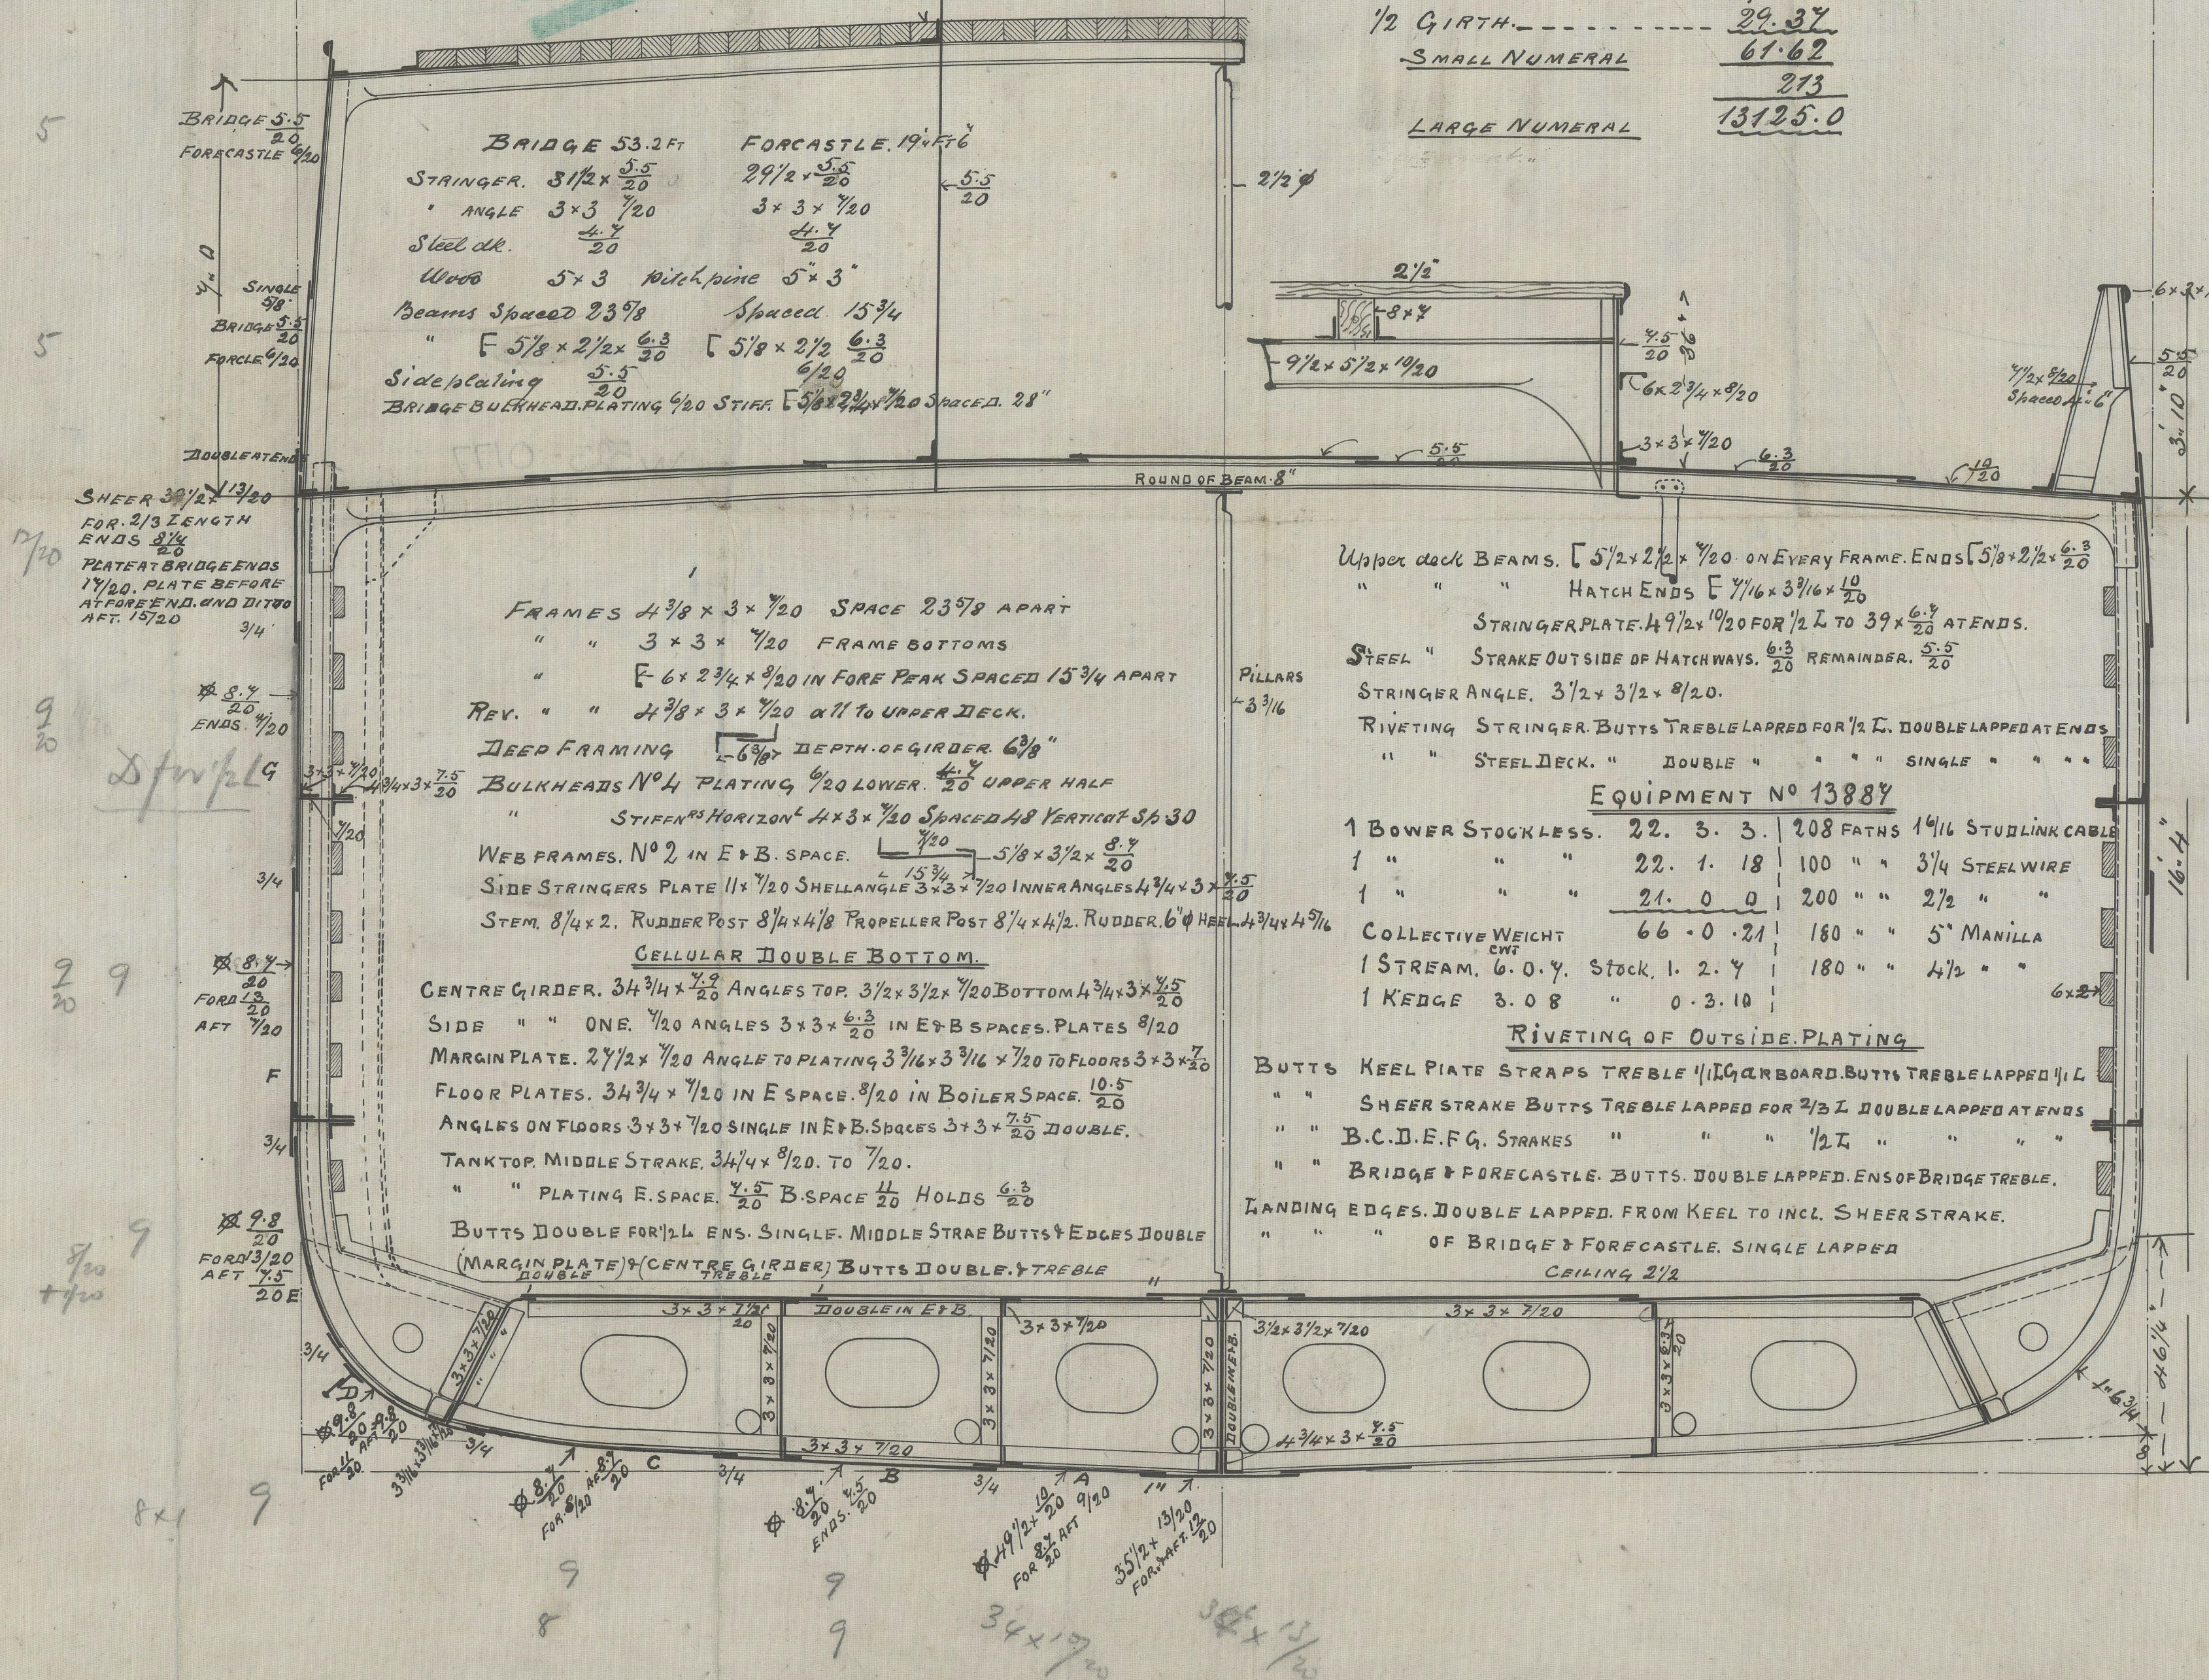

Midship section

$\frac{5}{8}$ Hansa

built by Act. Geo. Neptun
Postock

Ham. Kept N^o 8132

RETAIN

© 2020

Lloyd's Register
Foundation

W525-0177