


Superstructure, masts, funnels, deckhouses, casings, cargo and coaling hatchways, extent and thickness of sheathing on the freeboard deck, gangway, cargo and coaling ports and any other openings, etc., which would affect the seaworthiness of the ship are to be shown on the following sketches.

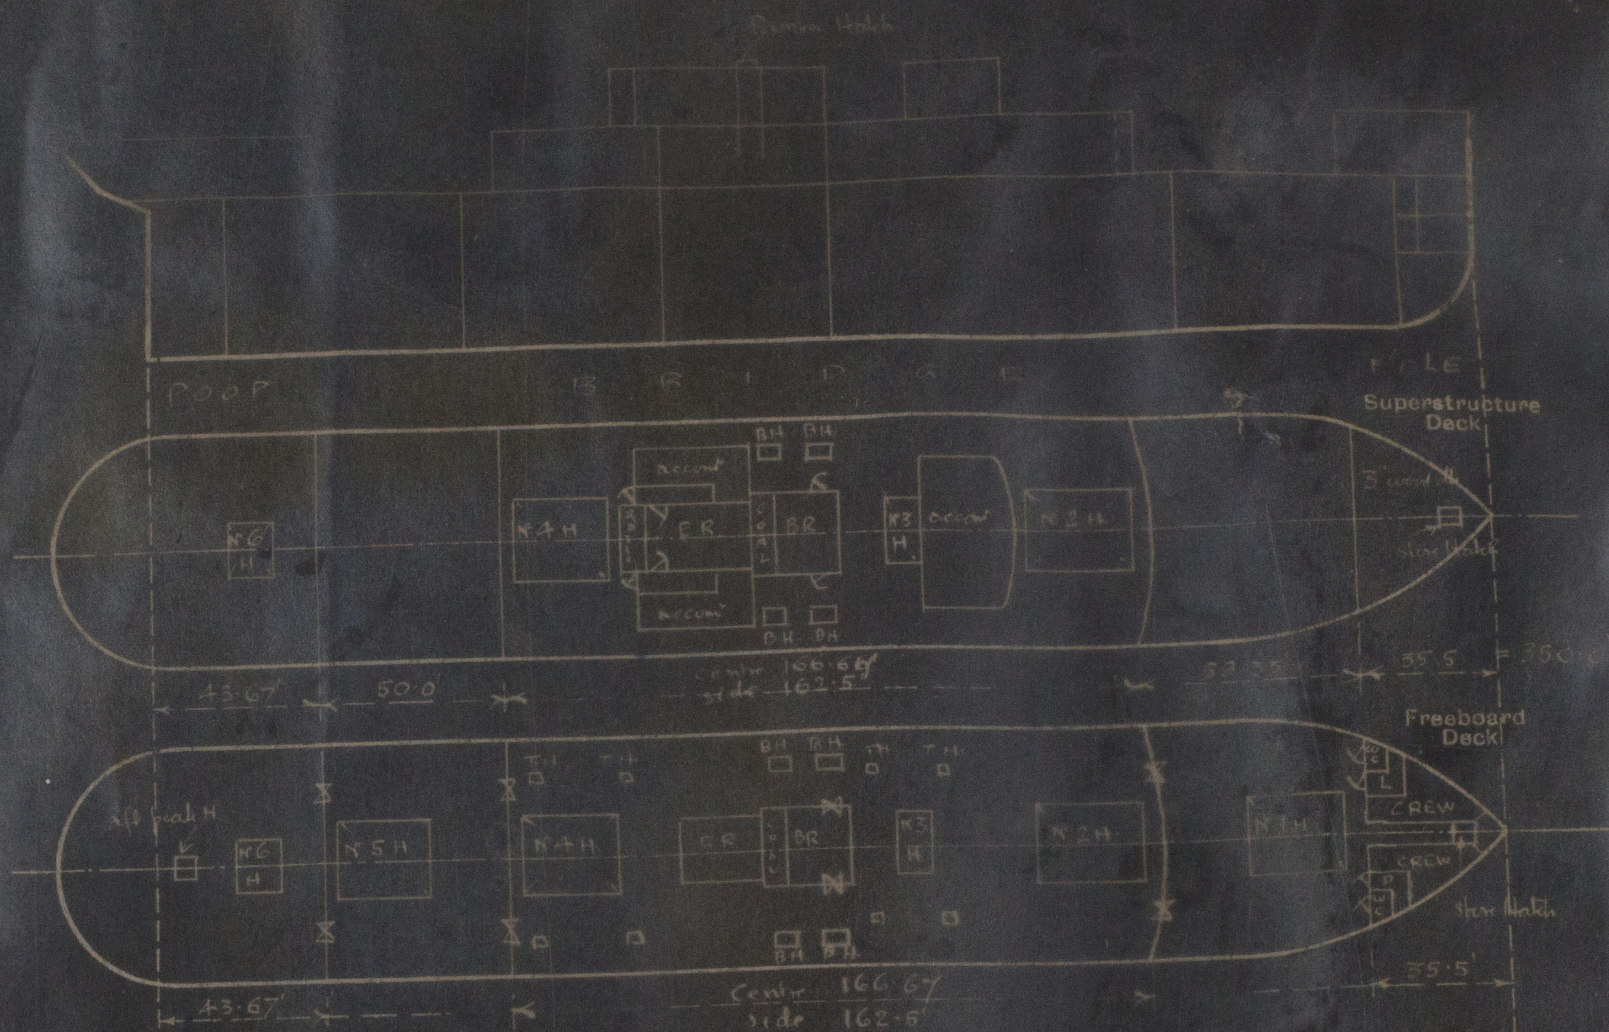

State any special features in the construction of the ship:—

Timber assignment not required

Vessel surveyed in Dry Dock whilst undergoing part Special Survey No 2.

This vessel has been sold. The new owner are as below.
It is stated that the vessel's name will remain as at present.
The new port of Registry is COLON.

22 feet Draft. Displacement 8789 Tons. Tons/mch 35.72
23 " " " 9220 " " " 36.04

Builder's name and yard number

Tyne I.S.B. Co. Ltd.

Names of sister ships

Owners

N.V. Stoomschip "HANNAH"

Dec E

11 : 18 : 0.

Received by me



© 2021

Lloyd's Register Foundation