


PRINCIPAL DIMENSIONS.
LENGTH B.P. 350'-0" BREADTH EX. 50'-0" DEPTH MLD 26'-0"
CLASS 100.A.1. AT LLOYDS.
 SCALE $\frac{1}{2}" = 1 FT$

DEPTH TO LENGTH U.D. 13.46
 " " " B.D. 10.44
 d = 22.58 UNDER 22

2.2.12
16.5.12
23.5.12
4.6.12
11.6.12

<u>SHEER.</u>	
FORWARD	10'-0"
AFT	5'-0"
1/8 L FORWARD	5'-5"
1/8 L AFT	2'-7 1/2"
APPROX UNDER DECK TONNAGE = 3440.	

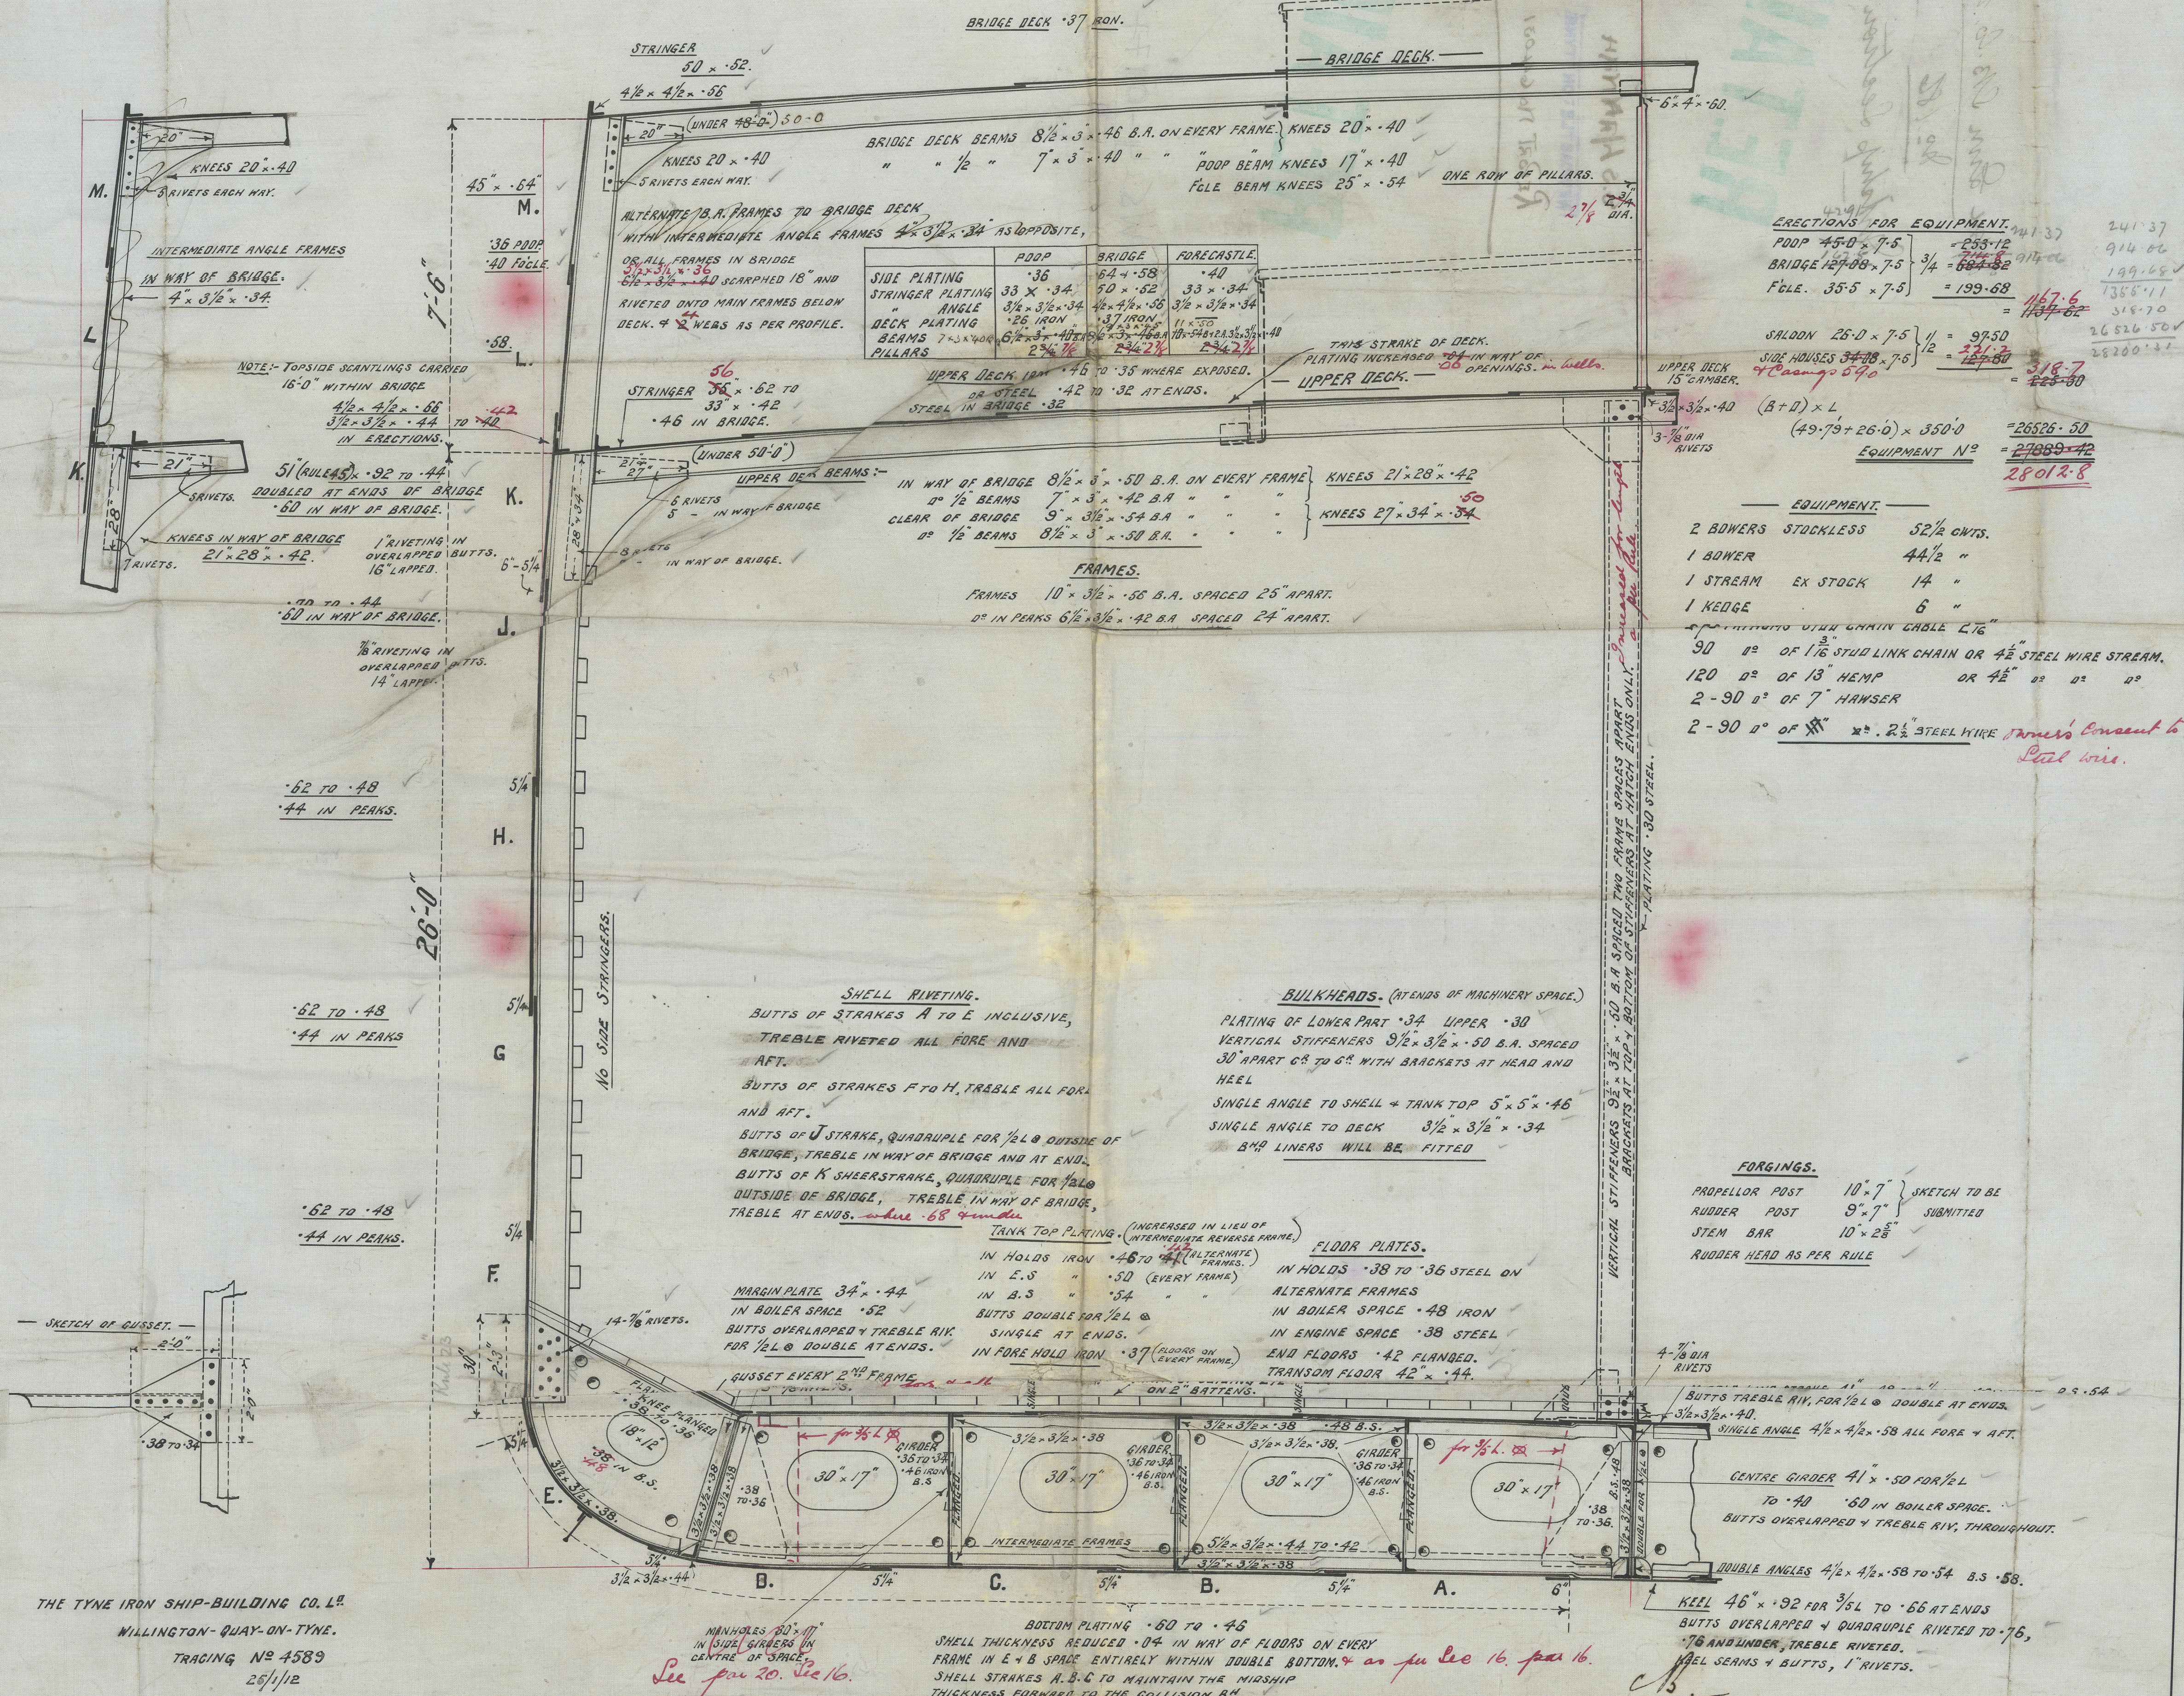

THE TYNE IRON SHIP-BUILDING CO. LD.
WILLINGTON-QUAY-ON-TYNE.
TRACING No 4589
25/1/12

WS 24-0177 © 2021
Lloyd's Register
Foundation

Lyme Ann St. Co. Ltd

No 186

Indship Section

RETAIN

S.S HANNAH

NEWCASTLE-ON-TYNE

REPORT NO 64031

RETAIN



© 2021

Lloyd's Register
Foundation

WS2

1177