

17 FEB 74

Index. No. **A-246**  
(For London Office only.)

# Lloyd's Register of Shipping.

## SURVEYS FOR FREEBOARD.

Computation of Freeboard for Steamer, Sailing Ship, Tanker  
having Part Loading Deck

(Type of Superstructures.)

Ship's Name <u>Delia</u>	Nationality and Port of Registry <u>British</u> <u>Malaya A. S.</u>	Official Number <u>145292</u>	Gross Tonnage <u>1267</u>	Date of Build <u>1927-8</u>
-----------------------------	---	----------------------------------	------------------------------	--------------------------------

Port of Survey Malaya A. S.  
Date of Survey July 21<sup>st</sup> to 27<sup>th</sup> 1927  
Name of Surveyor Malaya  
Particulars of Classification Part Loading Deck with Hatch

Moulded Dimensions: Length 225' Breadth 34' Depth 16' 5 1/2"  
Moulded displacement at moulded draught = 85 per cent. of moulded depth 2342 tons  
Coefficient of fineness for use with Tables .762

<p><b>Depth for Freeboard (D)</b></p> <p>Moulded depth ... <u>16.54</u></p> <p>Stringer plate ... <u>16.54</u></p> <p>Sheathing on exposed deck <math>T \left( \frac{L-S}{L} \right) = \checkmark</math></p> <p>Depth for Freeboard (D) = <u>16.58</u></p>	<p><b>Depth correction</b></p> <p>(a) Where D is greater than Table depth (D-Table depth) R = <math>(16.58 - 15.00) \times .731</math> <u>1.58</u> = <u>+ 2.73"</u></p> <p>(b) Where D is less than Table depth (if allowed) (Table depth - D) R = <u>✓</u></p> <p>If restricted by superstructures <u>✓</u></p>	<p><b>Round of Beam correction</b></p> <p>Moulded Breadth (B) <u>34.00</u></p> <p>Standard Round of Beam = <math>\frac{B \times 12}{50} =</math> <u>8.16"</u></p> <p>Ship's Round of Beam = <u>8.50"</u></p> <p>Difference <u>.34" excess</u></p> <p>Restricted to</p> <p>Correction = <math>\frac{\text{Diff.}}{4} \times \left( 1 - \frac{S_1}{L} \right) = \frac{.34}{4} \times (1 - 1) =</math> <u>Nil.</u></p>
--	--	---

**DEDUCTION FOR SUPERSTRUCTURES.**

	Mean Covered Length (S)	Equivalent Enclosed Length (S <sub>1</sub> )	Height	Height Correction	Effective Length (E)
Poop enclosed ...					
" overhang ...					
R.Q.D. enclosed ...	<u>80.50</u>	<u>80.50</u>	<u>3' 9"</u>	<u>3.75</u>	<u>78.75</u>
" overhang ...	<u>97.75</u>	<u>97.75</u>	<u>7' 0"</u>	<u>3.833</u>	<u>97.75</u>
Bridge enclosed ...	<u>27.50</u>	<u>27.50</u>	<u>7' 0"</u>	<u>3.833</u>	<u>27.50</u>
" overhang aft ...					
" overhang forward ...					
Fore enclosed ...	<u>19.25</u>	<u>19.25</u>	<u>3' 9"</u>	<u>3.75</u>	<u>12.03</u>
" overhang ...					
Tonnage opening aft ...					
" forward ...					
Total ...	<u>225.00</u>	<u>225.00</u>			<u>222.83</u>

Standard Height of Superstructure 6.00'

" " R.Q.D. 3.833

Deduction for complete superstructure 28.50'

Percentage covered  $\frac{S}{L} = 100\%$

" "  $\frac{S_1}{L} = 100\%$

" "  $\frac{E}{L} = \frac{96.03}{225} = 42.7\%$

Percentage from Table, Line A.  
(corrected for absence of fore-castle (if required)) 95.12

Percentage from Table, Line B.  
(corrected for absence of fore-castle (if required)) 78.82%

Interpolation for bridge less than 2L (if required)

Deduction =  $28.50 \times \frac{95.12}{78.82} =$  27.11

**SHEER CORRECTION.**

Station	Standard Ordinate	S	M	Product	Actual Ordinate	Effective Ordinate	S	M	Product
A.P. ...	<u>32.50</u>	<u>1</u>	<u>✓</u>	<u>32.50</u>	<u>34"</u>	<u>36.00</u>	<u>1</u>	<u>✓</u>	<u>36.00</u>
1/2 L from A.P. ...	<u>14.46</u>	<u>4</u>	<u>✓</u>	<u>57.84</u>	<u>15"</u>	<u>15.80</u>	<u>4</u>	<u>✓</u>	<u>63.20</u>
2/3 L " ...	<u>3.57</u>	<u>2</u>	<u>✓</u>	<u>7.14</u>	<u>2"</u>	<u>3.95</u>	<u>2</u>	<u>✓</u>	<u>7.90</u>
Amidships ...	<u>✓</u>	<u>4</u>	<u>✓</u>	<u>✓</u>	<u>✓</u>	<u>✓</u>	<u>4</u>	<u>✓</u>	<u>✓</u>
2/3 L from F.P. ...	<u>7.15</u>	<u>2</u>	<u>✓</u>	<u>14.30</u>	<u>16"</u>	<u>8.49</u>	<u>2</u>	<u>✓</u>	<u>16.98</u>
1/2 L " ...	<u>28.72</u>	<u>4</u>	<u>✓</u>	<u>115.68</u>	<u>35"</u>	<u>33.97</u>	<u>4</u>	<u>✓</u>	<u>135.88</u>
F.P. ...	<u>65.00</u>	<u>1</u>	<u>✓</u>	<u>65.00</u>	<u>75"</u>	<u>78.50</u>	<u>1</u>	<u>✓</u>	<u>78.50</u>
Total ...				<u>292.46</u>					<u>338.46</u>

Mean actual sheer aft = Excess

Mean standard sheer aft

Mean actual sheer forward = Excess

Mean standard sheer forward

Length of enclosed superstructure forward of amidships = C.S.S

" " aft of " = ✓

Correction =  $\frac{\text{Difference between sums of products}}{18} \left( \frac{.75 - S}{2L} \right) = \frac{46}{18} \left( \frac{.75 - .50}{2} \right) =$  -.64"

If limited on account of midship superstructure.

If limited to maximum allowance of 1 1/2 ins. per 100 ft.

<p><b>Deduction for Tropical Freeboard.</b></p> <p><b>Addition for Winter and Winter North Atlantic Freeboard</b></p> <p>Depth to Freeboard Deck = <u>Ft.</u></p> <p>Summer freeboard = <u>✓</u></p> <p>Moulded draught (d) = <u>✓</u></p> <p>Deduction for Tropical freeboard and addition for Winter freeboard = <math>\frac{d}{4}</math> inches = <u>✓</u></p> <p>Addition for Winter North Atlantic Freeboard (if required) = <u>✓</u></p>	<p><b>Deduction for Fresh Water.</b></p> <p>Displacement in salt water at summer load water line</p> <p><math>\Delta =</math></p> <p>Tons per inch immersion at summer load water line</p> <p><math>T =</math></p> <p>Deduction = <math>\frac{\Delta}{40 T}</math> inches = <u>✓</u></p>	<p><b>TABULAR FREEBOARD</b> corrected for Flush Deck (if required)</p> <p>Correction for coefficient <math>\frac{.762 + .68}{1.36} = \frac{1.442}{1.36} =</math> <u>✓</u></p> <table border="1"> <tr> <td></td> <td>+</td> <td>-</td> </tr> <tr> <td>Depth Correction ...</td> <td><u>2.73</u></td> <td><u>27.11</u></td> </tr> <tr> <td>Deduction for superstructures ...</td> <td><u>28.76</u></td> <td><u>✓</u></td> </tr> <tr> <td>Sheer correction ...</td> <td><u>-.64</u></td> <td><u>✓</u></td> </tr> <tr> <td>Round of Beam correction ...</td> <td><u>✓</u></td> <td><u>✓</u></td> </tr> <tr> <td>Correction for Thickness of Deck amidships</td> <td><u>84.00</u></td> <td><u>27.75</u></td> </tr> <tr> <td>Other corrections, scantlings, etc. ...</td> <td><u>86.73</u></td> <td><u>28.80</u></td> </tr> <tr> <td>Summer Freeboard =</td> <td><u>84.11</u></td> <td><u>88.19</u></td> </tr>

**SUMMER FREEBOARD amidships from Centre of Disc to top of Deck Line, Steel Deck:**

Tropical Fresh Water Line above Centre of Disc	...
Fresh Water Line	"
Tropical Line	"
Winter Line below	"
Winter North Atlantic Line	"

Tropical Fresh Water Freeboard	...
Fresh Water	"
Tropical	"
Winter	"
Winter North Atlantic	"

© 2020

Existing freeboards

WS25-0038

Lloyd's Register Foundation

## PARTICULARS OF PROTECTION TO OPENINGS, ETC.

HATCHWAYS ON FREEBOARD AND SUPERSTRUCTURE DECKS									
Description of Hatchway			No 1	No 2	No 3	No 4	Coal Hatch		
Dimensions of Hatchway			15'6" x 14'3"	21' x 16'	19' x 16'	19' x 16'	11'6" x 3'4"		
COAMINGS	{	Height above Deck	30"	32"	32"	As No 3	60"		
		Thickness { Sides	3/8"	7/16"	7/16"		3/8"		
		Ends	3/8"	7/16"	7/16"		3/8"		
		Stiffeners	7 x 3 1/2 channel	7 x 3 1/2 channel	7 x 3 1/2 channel				
Brackets, Stays									
HATCH BEAMS	{	Number	7 1/4"	8"	9 1/2"	As No 3			
		Spacing	7 1/4"	8"	9 1/2"				
		Scantling and Sketch	9" built for with 3 1/2 x 3 x 3/8 angles	3 1/2 x 7 1/16 plate	3 1/2 x 3 x 3/8 angles				
		Bearing Surface	8 3/4" x	6"	6"				
FORE AND AFTERS	{	Number	3	3	3	As No 3			
		Spacing	48"	48"	48"				
		Unsupported Lengths	7'9"	7'9"	7'9"				
		Scantling* and Sketch	2 built for with 7 x 5 and 1-6 x 6 wood with 6 x 3 T for attached	2 built for with 7 x 5 and 1-6 x 6 wood with 6 x 3 T for attached	2 built for with 7 x 5 and 1-6 x 6 wood with 6 x 3 T for attached				
Bearing Surface	8 3/4" x	8 3/4" x	8 3/4" x						
HATCH COVERS	{	Material	Wood	Wood	Wood	As No 3	Wood		
		Thickness	2 1/2"	2 1/2"	2 1/2"		2 1/2"		
		How fitted	Shrinkfit	Shrinkfit	Shrinkfit		Shrinkfit		
		Bearing Surface	2"	2"	2"		2"		
Spacing of Cleats			24"	24"	24"	24"	24"		
Number of Tarpaulins			3	3	3	3	3		
*Are wood fore and afters steel shod at all bearing surfaces?									
Are battens and wedges efficient and in good condition?									
Are tarpaulins in good condition and in accordance with rule requirements?									
Are lashings provided in accordance with rule requirements?									

Particulars of fiddley, funnel and ventilator coamings :—

2 ventilators, coverings 12", dia 20" fitted with canvas covers ✓  
 2 " " 28", " 18" " " ✓  
 Panel covering 12", " 72" " " ✓  
 Lidly " 35x35 3/4, plating 5/16", height 5'4" with ringed covers & castings ✓

Particulars of Flush Bunker Scuttles:—

Particulars of Companionways :—

On present Leek, 4'9" x 3' casing 3' x 3'  $\frac{1}{2}$ , platy  $\frac{1}{4}$ , opening 42" x 31", sill 11 $\frac{1}{2}$ " -  
fitted with hand half doors at off side, with sliding lock. -

Particulars of Ventilators in exposed positions on freeboard and superstructure decks :—

2 - Cravings 18", dia 9" fitted with canvas cover ✓  
6 - " 48" " 13" " " " " ✓  
(adequately supported) 2 - " 80" " 13" " " " " ✓  
3 fiddly gratings, fitted with <sup>bringed</sup> actual plates and bolts ✓

Specially  
Su. 10/10/10

Particulars of Air Pipes in exposed positions on freeboard, raised quarter, or superstructure decks :—

2 - 27" high with forelocks and ceases covers  
1 - 18" " " " " " " "  
1 - 19" " " " " " " "

Particulars of Gangway Cargo and Coaling Ports:—

## Particulars of Scuppers and Sanitary Discharge Pipes

all open scapports  
2 existing discharge pipes above parking deck and discharging below

Particulars of Side Scuttles :

6 in. pressure, 8" dia., and fitted with headlights.

Particulars of Guard Rails :—

From amidships to fore end of masting deck and on forecable  
Height 40", stanchions 54" apart and 3 rails 12" apart.

Particulars of Gangways, Lifelines, etc. :—

~~to be fitted~~

## Particulars of Freeing Arrangements

	Length of Bulwark	Height of Bulwark	Size of Freeing Ports	Number each side	Area each side	Rule area each side
After Well ... ..	84'	46"	$30'' \times 20''$ 36 x 18	2 } 2 }	$17\frac{1}{4} \text{ ft.}$ 4	$16.80 \text{ ft.}$ 17
Forward Well ... ..	19'	46"	$36'' \times 18''$	2	9.	$8.5''$

State position of each freeing port ... .. } After Well:—From head, No. 1 to center of port 9'-0", No. 2-2'-4"  
(F. and A. position and height above deck edge) Forward Well:—From off end, No. 1 to center of port 9'-1", No. 2-1'-3"  
State whether the freeing ports are fitted with shutters, bars or rails, and give material of each. } 12" alone deck edge.

Additional area where sheer is less than standard.

1st 9'-7", to 2-24'-4" } 12" above deck edge.  
 2nd 31", to 2-13'9" }  
 Filled with saving shavings

2 ports on P.G.D. with 2 longitudinal beams  
 and transversals 15 ft apart and 4' outside of ports


## Particulars of Superstructures, Trunks, Casings, Deckhouses

	Coaming	Plating	Stiffeners	Spacing	End Attachments of Stiffeners	Size of Openings	Height of Sills	Height of Casings
Poop Bulkhead ... ..	✓							
Raised Quarter Deck Bulkhead ...	✓							
Bridge, After Bulkhead ... ..	$4 \times 3\frac{1}{2} \times 7/16$	$5/16$	$3\frac{1}{2} \times 3\frac{1}{2} \times 3/8$	30"	✓	$18 \times 18$	11	38"
Bridge, Forward Bulkhead ... ..	$3 \times 3 \times 3/8$	$5/16$	$4 - 2\frac{1}{2} \times 3\frac{1}{2} \text{ plates } \times 3 \times 3\frac{1}{2} \text{ L}$ and $5\frac{1}{2} \times 3 \times 3/8 \text{ B.A.}$	30"	$18 \times 18 \times 3/8 \text{ L plates}$	✓	✓	38"
Forecastle Bulkhead ... ..	$3 \times 3 \times 5/16$	$5/16$	$3 \times 2\frac{1}{2} \times 1/4$	30	✓	✓	✓	42"
Trunk, Aft ... ..								
Trunk, Forward ... ..								
Exposed Machinery Casings on Free- board or Raised Quarter Decks ...								
Exposed Machinery Casings on Super- structure Decks ... ..	$3 \times 3 \times 3/8$	.25	$3 \times 3 \times 3/8 \text{ L plates}$ $3 \times 3 \times 3/8 \text{ narrow flange}$	30	✓	$48 \times 23$	17	7'
Machinery Casings within Superstruc- tures not fitted with Class I Closing Appliances ... ..								
Deckhouses on Flush Deck Ships ...								

## Particulars of Closing Appliances (state if capable of being manipulated from both sides).

Poop Bulkhead ... ..	✓	
Raised Quarter Deck Bulkhead ... ..	✓	<i>No openings.</i>
Bridge, After Bulkhead ... ..	✓	<i>Plated <del>Forward</del> fitted with through bolts and nuts permanently bolted, bolts spaced 4" apart.</i>
Bridge, Forward Bulkhead ... ..	✓	<i>No openings.</i>
<i>Raised Deck Forward</i> ... ..	✓	<i>No openings</i>
Forecastle Bulkhead ... ..	✓	<i>No openings</i>
Exposed Machinery Casings on Freeboard or Raised Quarter Decks ... ..	✓	
Exposed Machinery Casings on Superstructure Decks ... ..	✓	
Machinery Casings within Superstructures with Class I Closing Appliances ... ..	✓	<i>1 hinged steel door at aft end of E.R., fitted with ordinary bolt manipulated with wires, and 6 daylight lids 30-34" hinged steel door on main</i>
Deckhouses on Flush Deck Ships ... ..	✓	

Superstructure bulkheads, trunks, deckhouses, casings, cargo and coaling hatchways, extent and thickness of sheathing on the freeboard deck, gangway, cargo and coaling ports, and any other openings, etc., which would affect the seaworthiness of the ship are to be shewn on the following sketches:—

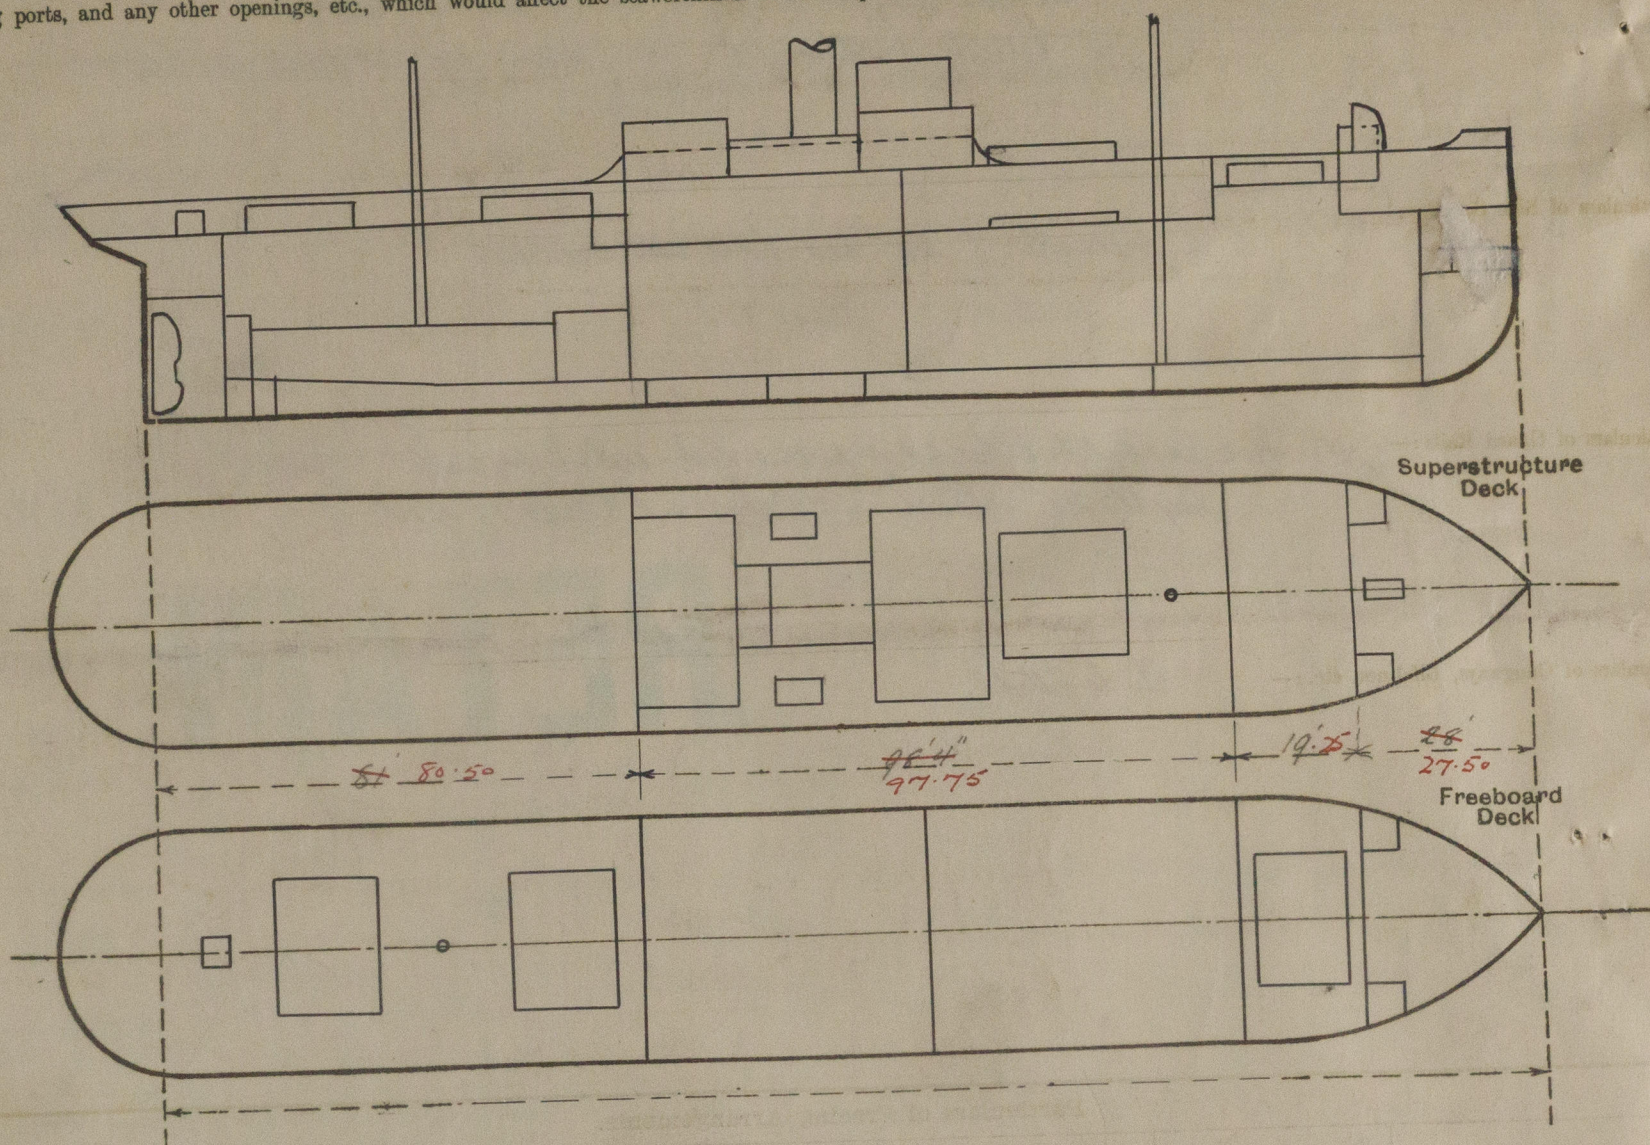

State any special features in the construction of the ship:—

*The survey was held at Halifax N.S. the vessel lying in the Marine Railway and afloat, and the Owners request the Certificate completed under the 1906 Rules.*

Builder's name and yard number

*Messrs Wood, Skinner & Co. Ltd. Newcastle*

Names of sister ships

Owners

*Delia Shipping Co. Ltd. (F. H. Warren.)*

Fee £

*£ 40.00*

Received by me



© 2020

Lloyd's Register Foundation