


all plates, rivets + stays of steel.
Tubes + uptake of iron.

MAIN BOILER

J. T. Eltringham N^o 1452

Blyth S. B. Co. S. S. N^o 121

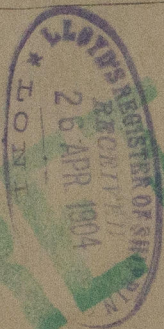

LLOYD'S TEST

N^o 6844

360 lbs.

E. J. S. 26.8.04

J. P. Gammee

Newcastle Report

N^o 47727

J. P. Gammee

WS25-0135



© 2020

Lloyd's Register
Foundation