


— PROFILE . S.S. N^o. 121. —

— LENGTH B.P. 178' BREADTH EXT. 26' 6" DEPTH MLD. 13' 9" —


— SCALE 1/8" = 1 FT. —

7. 4. 04
14. 4. 04
29. 4. 04
4. 5. 04

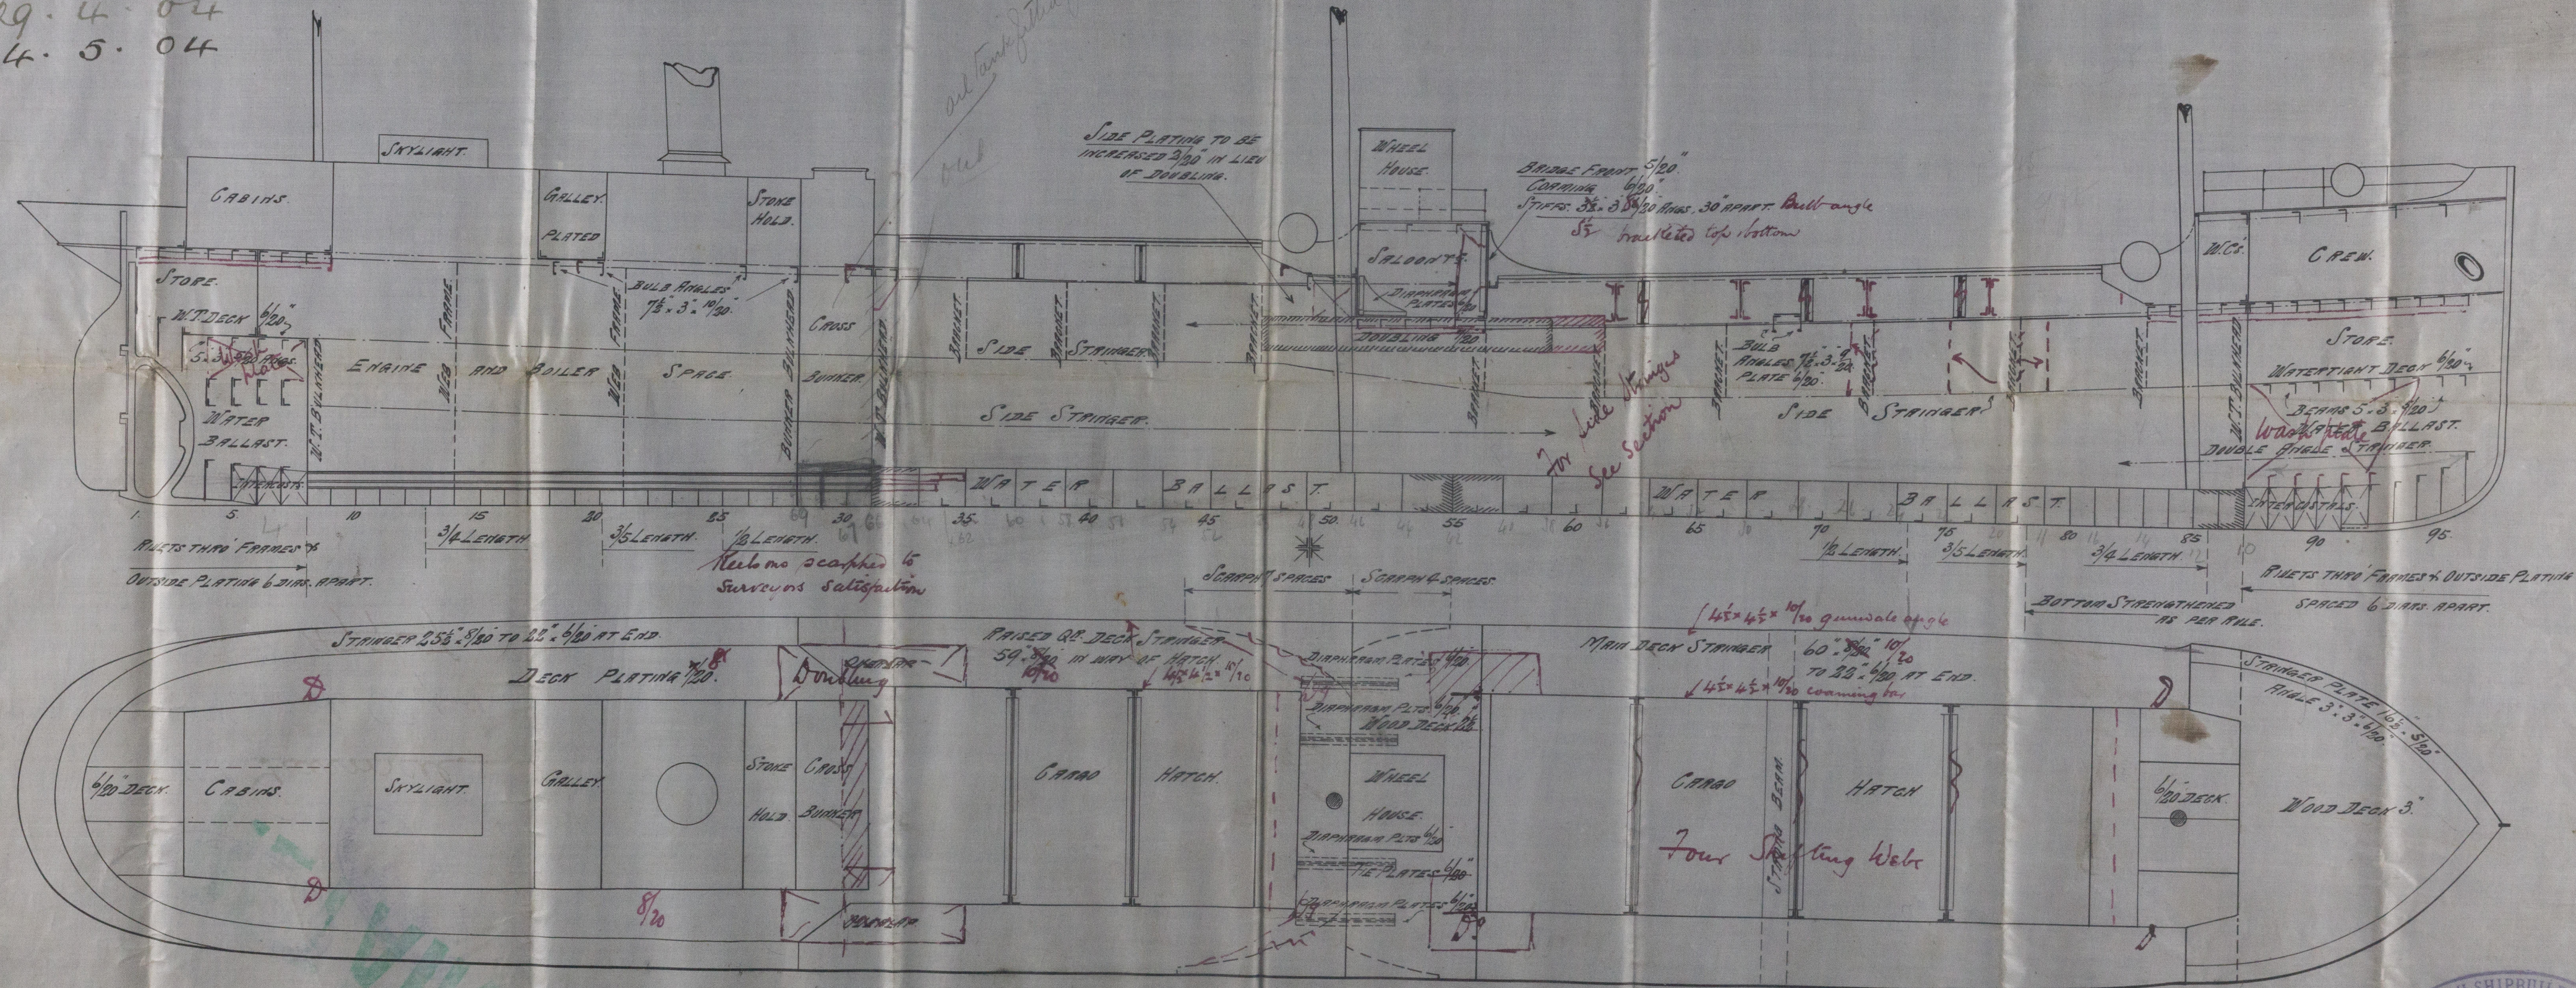

NOTE: FRAMES HAVE BEEN INCREASED IN DEPTH 1" IN WAY OF CARGO HATCH AT RAISED QUARTER DECK, AND 1" IN DEPTH & 1/2" IN THICKNESS IN WAY OF MAIN DECK HATCH. (SEE MIDSHIP SECTION.)

C.B.
7. 4. 04

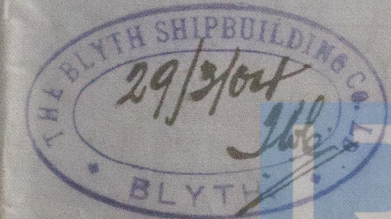

WS2S-032

S. S. GRASMERE

Blyth SBCos

357 121

Profile

J. J. Grasmere

Newcastle Report

47727

LR

© 2020

Lloyd's Register
Foundation

WS25-0137