





S.S.N°392.

Also #397 appo 27/10/00


10-8-00
27-10-00 (P 397)
22-2-01
24-3-01

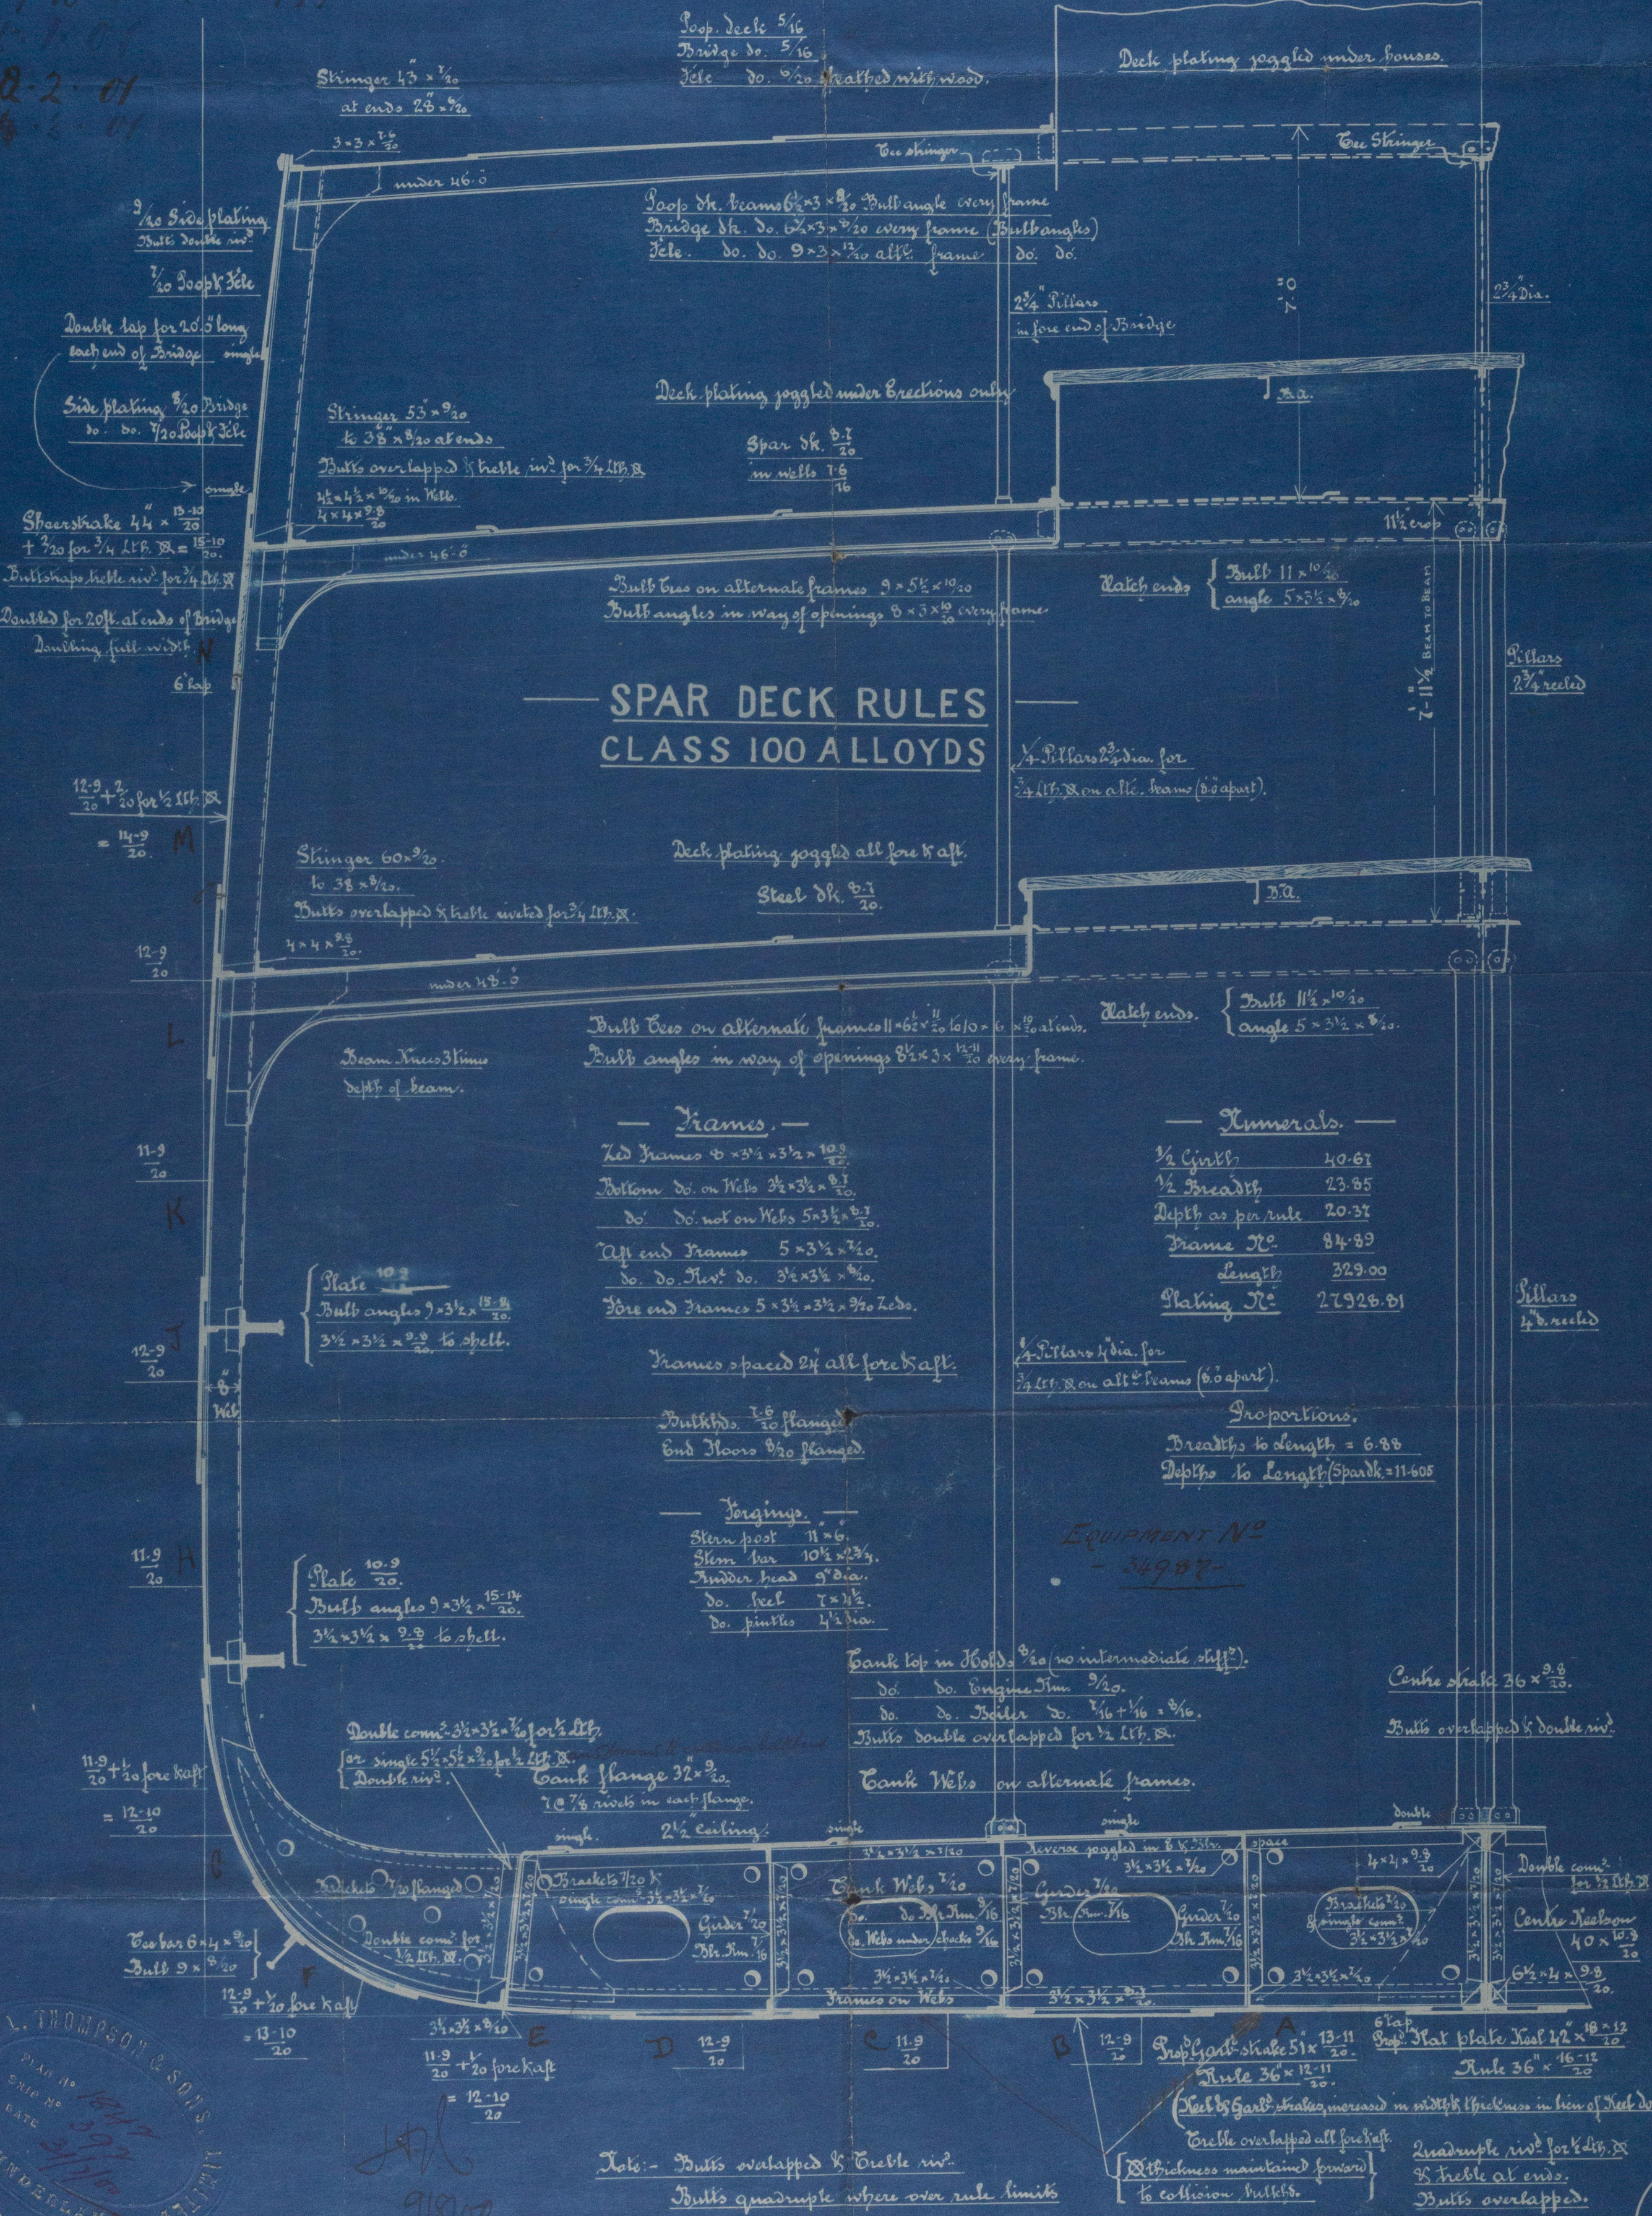

Midship Section
J F Thompson
Nos 392 + 397

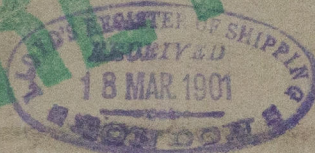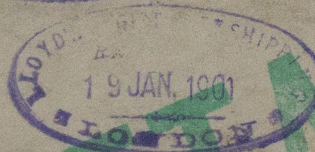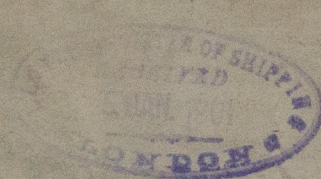

S.S. 'Corby'
Sunderland. No 20744

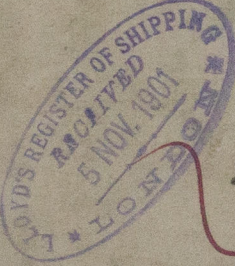

Cancelled
18. 11. 00

WS25-0304