


SCALE $\frac{1}{8}" = 1'$




T

392

Profile 392 ³⁹⁷
24239

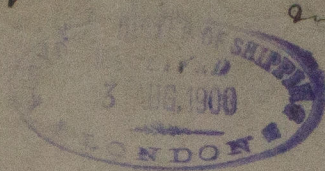


J J Thompson

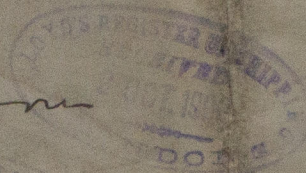


S. J. Corby

Sunderland. No. 20744

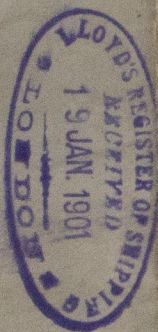

Cancelled
18.10.00

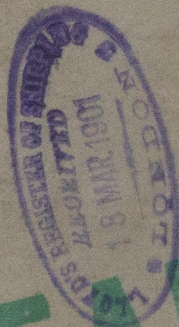

RETAIN

268
392

WS2S-030S



© 2020

Lloyd's Register
Foundation