



29.4.12
9.5.12

MIDSHIP SECTION

STEEL SCREW TRAWLER


N° 539.

DIM^s 130' B.P. x 23'0" EX x 13'6" MLD

SCALE 1/2" = ONE FOOT

TO CLASS 100 A1 FOR FISHING PURPOSES. DECK PLATED OVER IN WAY
OF MACHINERY SPACE ENGINE & BOILER CASING AS PREVIOUSLY APPROVED

PLAN No. 1510
FOR ENCLOSURE TO
Messrs. Lloyd's Register
FROM
COCHRANE & SONS
SHIPBUILDERS SE
DATE 20/4/12 RR

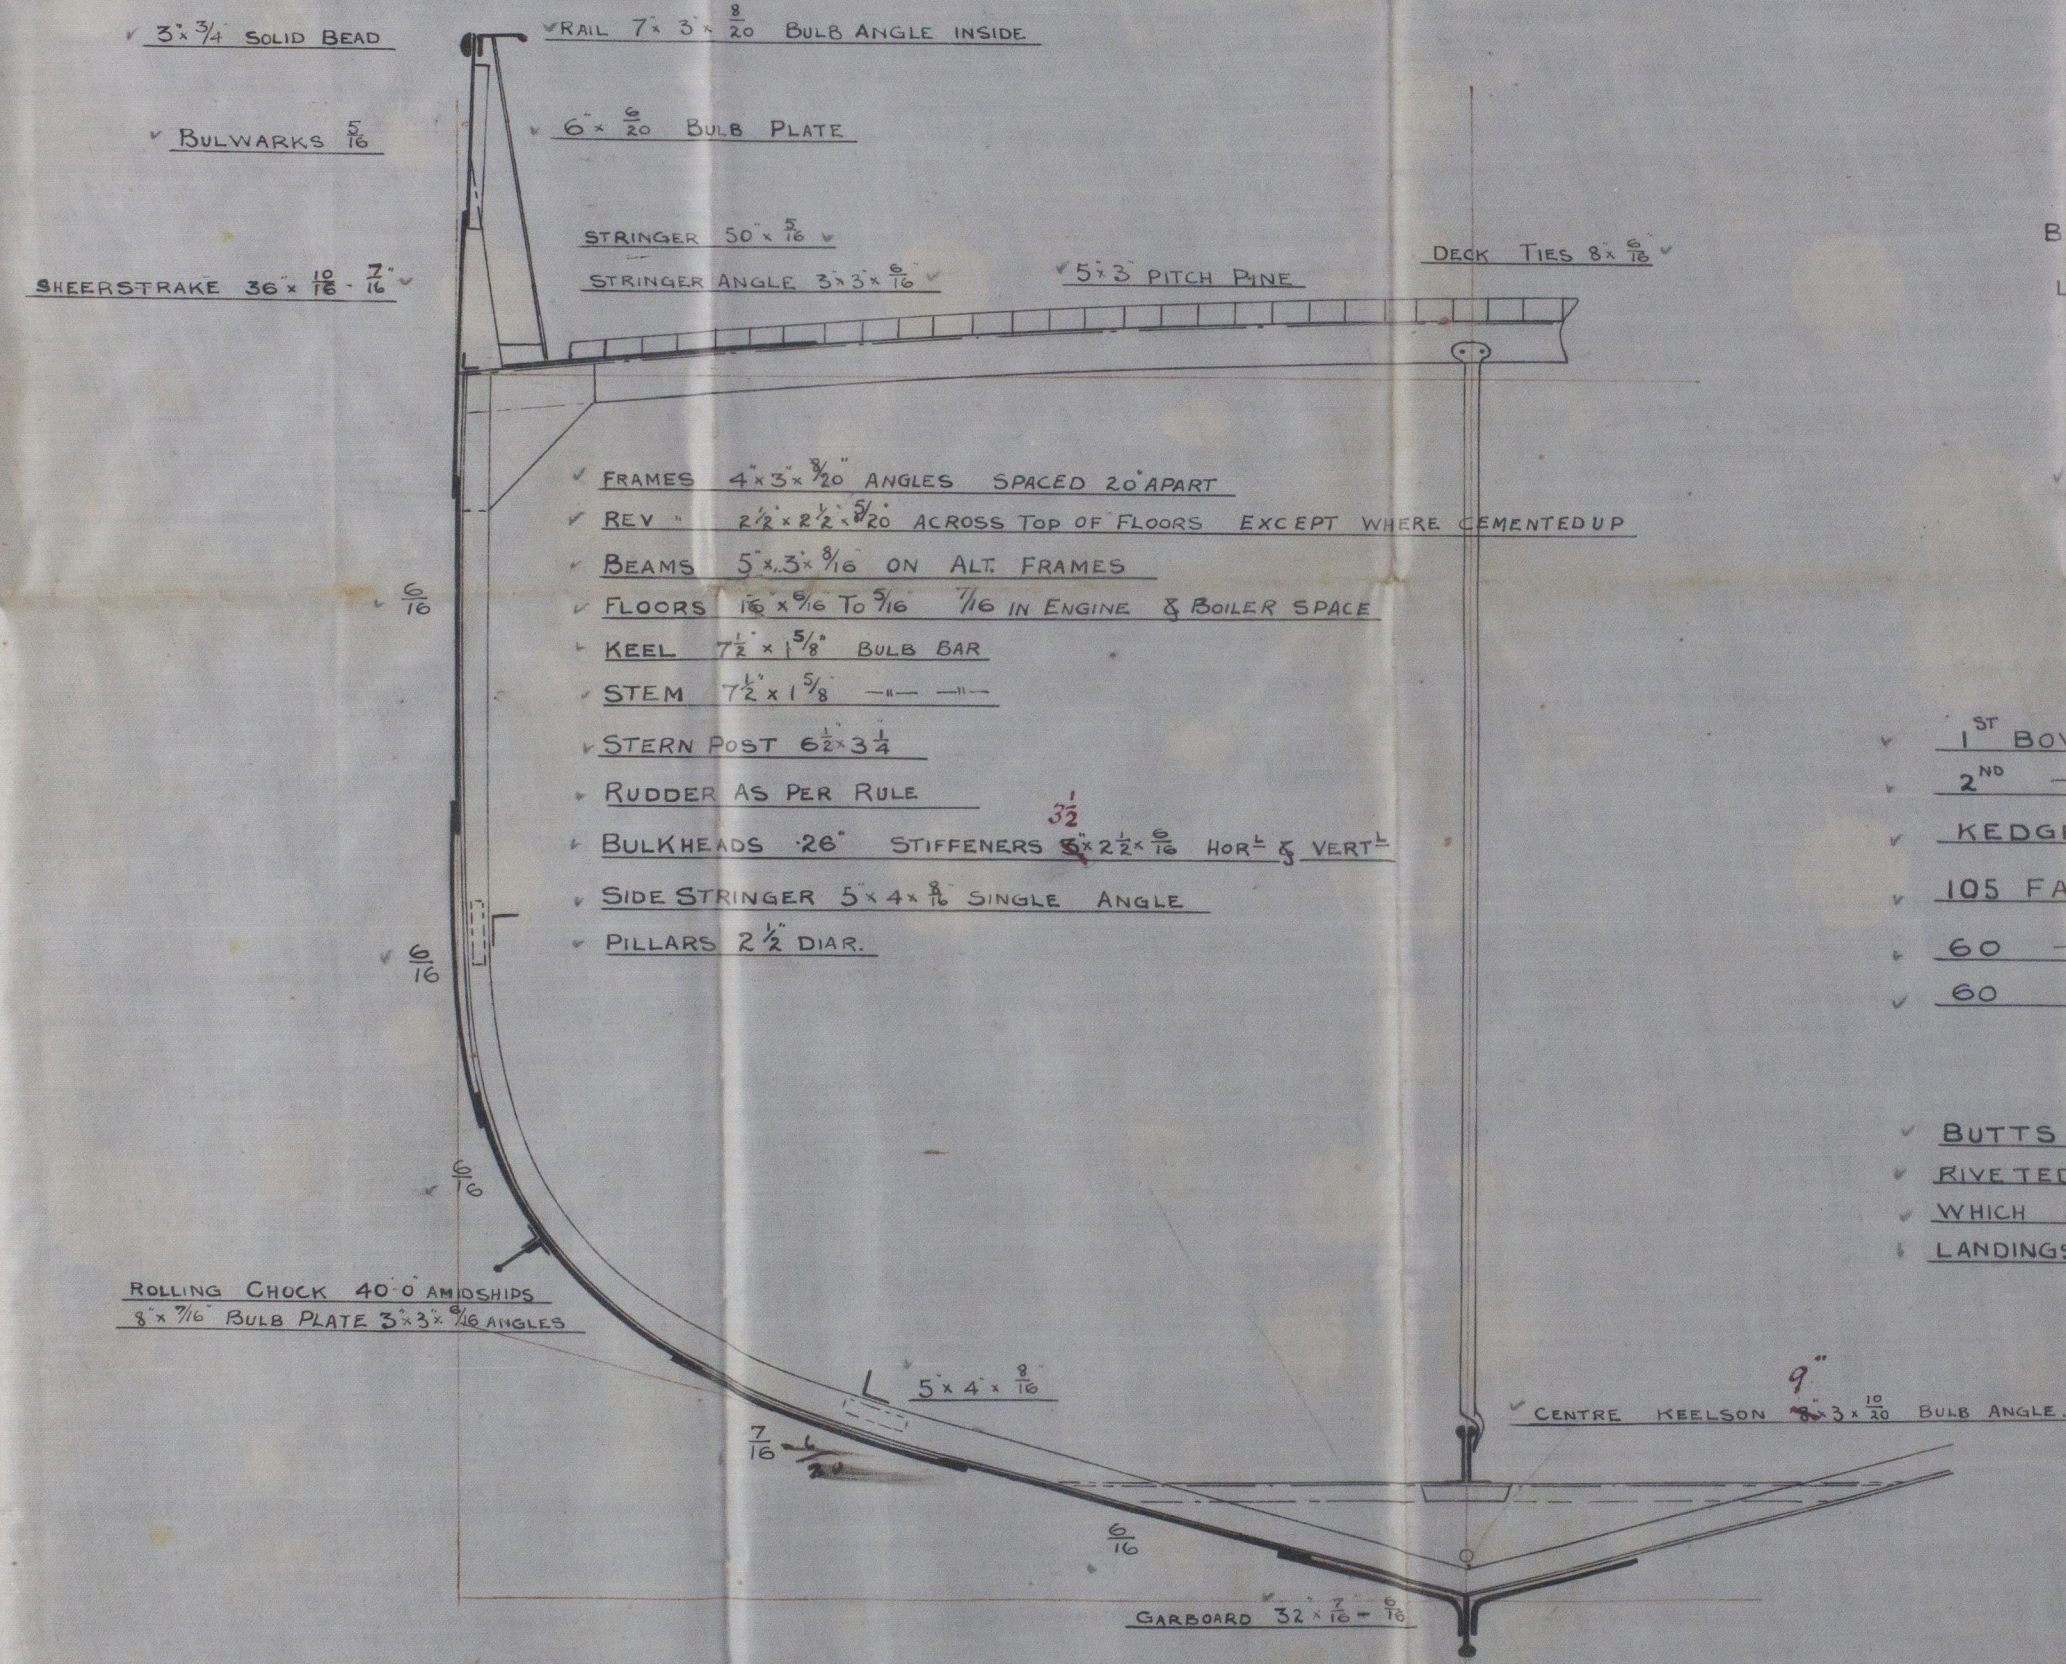

NUMERALS

B + D = 36.5 36.39
L x (B + D) = 4745 4729

PROPORTIONS

L/D = 9.629
L/B = 5.652

EQUIPMENT

1 ST BOWER ANCHOR	5 3/4 CWTs EX STOCK
2 ND " "	5 1/4 " " " "
KEDGE	3 " " " "
105 FATHOMS	1 1/2 CABLE
60 " "	6 HAWSER
60 " "	5 WARP

RIVETING

- BUTTS OF SHELL PLATING LAPPED & DOUBLE
- RIVETED EXCEPT GARBOARD & SHEERSTRAKE
- WHICH ARE TO BE STRAPPED & DOUBLE RIVETED
- LANDINGS DOUBLE RIVETED. BULWARKS SINGLE RIVETED

ABW
27.4.12

29.4.12
9.5.12

5 x 37.86
4734.40

Cochran & Sons.

No 539.

Midship Section.

3/4 Landed.

Hull Report No 25641

RETAIN



© 2020

Lloyd's Register
Foundation

W526-0286