


**Nº 203.**  
**INBOARD PROFILE**  
**ALTERATION.**  
**SCALE 1/8" TO ONE FOOT.**



DRAWN BY \_\_\_\_\_  
 TRACED BY \_\_\_\_\_  
 CHECKED BY \_\_\_\_\_  
 APPROVED BY \_\_\_\_\_  
 DRAWN IN \_\_\_\_\_  
 DATE \_\_\_\_\_

05884  
 Lloyd's Re  
 Foundation  
 W527-0232

 


203


Shunyo Maru

Allered Profile

Nagasaki Rept-N:743

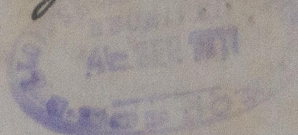

RETAIN

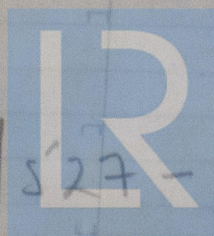

© 2020

W 527 -

0232

Lloyd's Register  
Foundation