
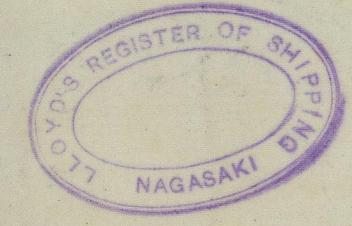


203
Main & Lower Deck Plans
Alteration
Scale 1/8 to one foot

Nº 203.
MAIN & LOWER DECK PLANS.
ALTERATION.
SCALE 1/8 TO ONE FOOT.

 

203

Shingo Maru
Altered Main & Lower Dks
Kagasaki Rept-Nº 743



DETAIN

18. MEB

18. MEB

28. 1. 54



© 2020

Lloyd's Register
Foundation

WS27-0234