


SKALA 1:96

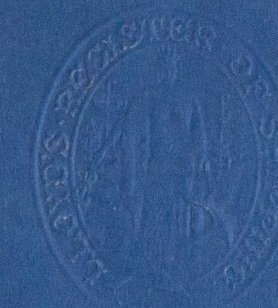

H.J.
1-5-23

S/S "STURE"

LENGTH OVER ALL	AFTER LENGTHENING	124' 3"
LENGTH BETWEEN PER	AFTER LENGTHENING	121' 2"
LENGTH MELLAN STAVAR	EFTER FÖRÄNGH.	121' 2"
BREADTH ON DECK		22' 5"
BREDD PÅ SPANT		22' 5"
MOULDED DEPTH		12' 0"
MÅLLAT DJUP		12' 0"
LENGTHENING	FRAME SPACES	22' 0"
FÖRÄNGHNING	12 SFT. DIST.	22' 0"

ERIKSSON & SÖN VERKSTÄD A.B.
GÖTEBORGS

26-1-23






24-8-258

RETAIN

Longitudinal Plan.

S/S "Sture"

Gothenburg Report № 5347

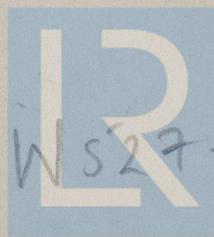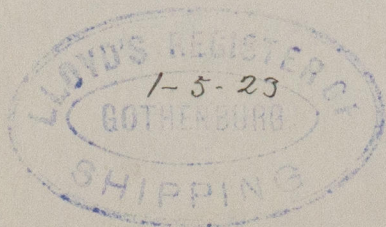

© 2020

WS27-0258
Lloyd's Register
Foundation