


<u>CLASS LLOYD 100 A.I. STEEL</u>		
<i>Length over all</i>		
LÄNGD ÖVER ALLT	104'-3"	ENG M
<i>between stem and stem post</i>		
MELLAN STÄVAR	50'-2"	.
<i>Shoulder breadth</i>		
STORSTA BREDD PÅ SPT.	22'-5"	.
<i>Shoulder length</i>		
MALLAT DJUP	12'-0"	.
$L \times (B+D) = 3443 \quad B+D \cdot 34.42 \quad \frac{L}{D} = 8.26$		

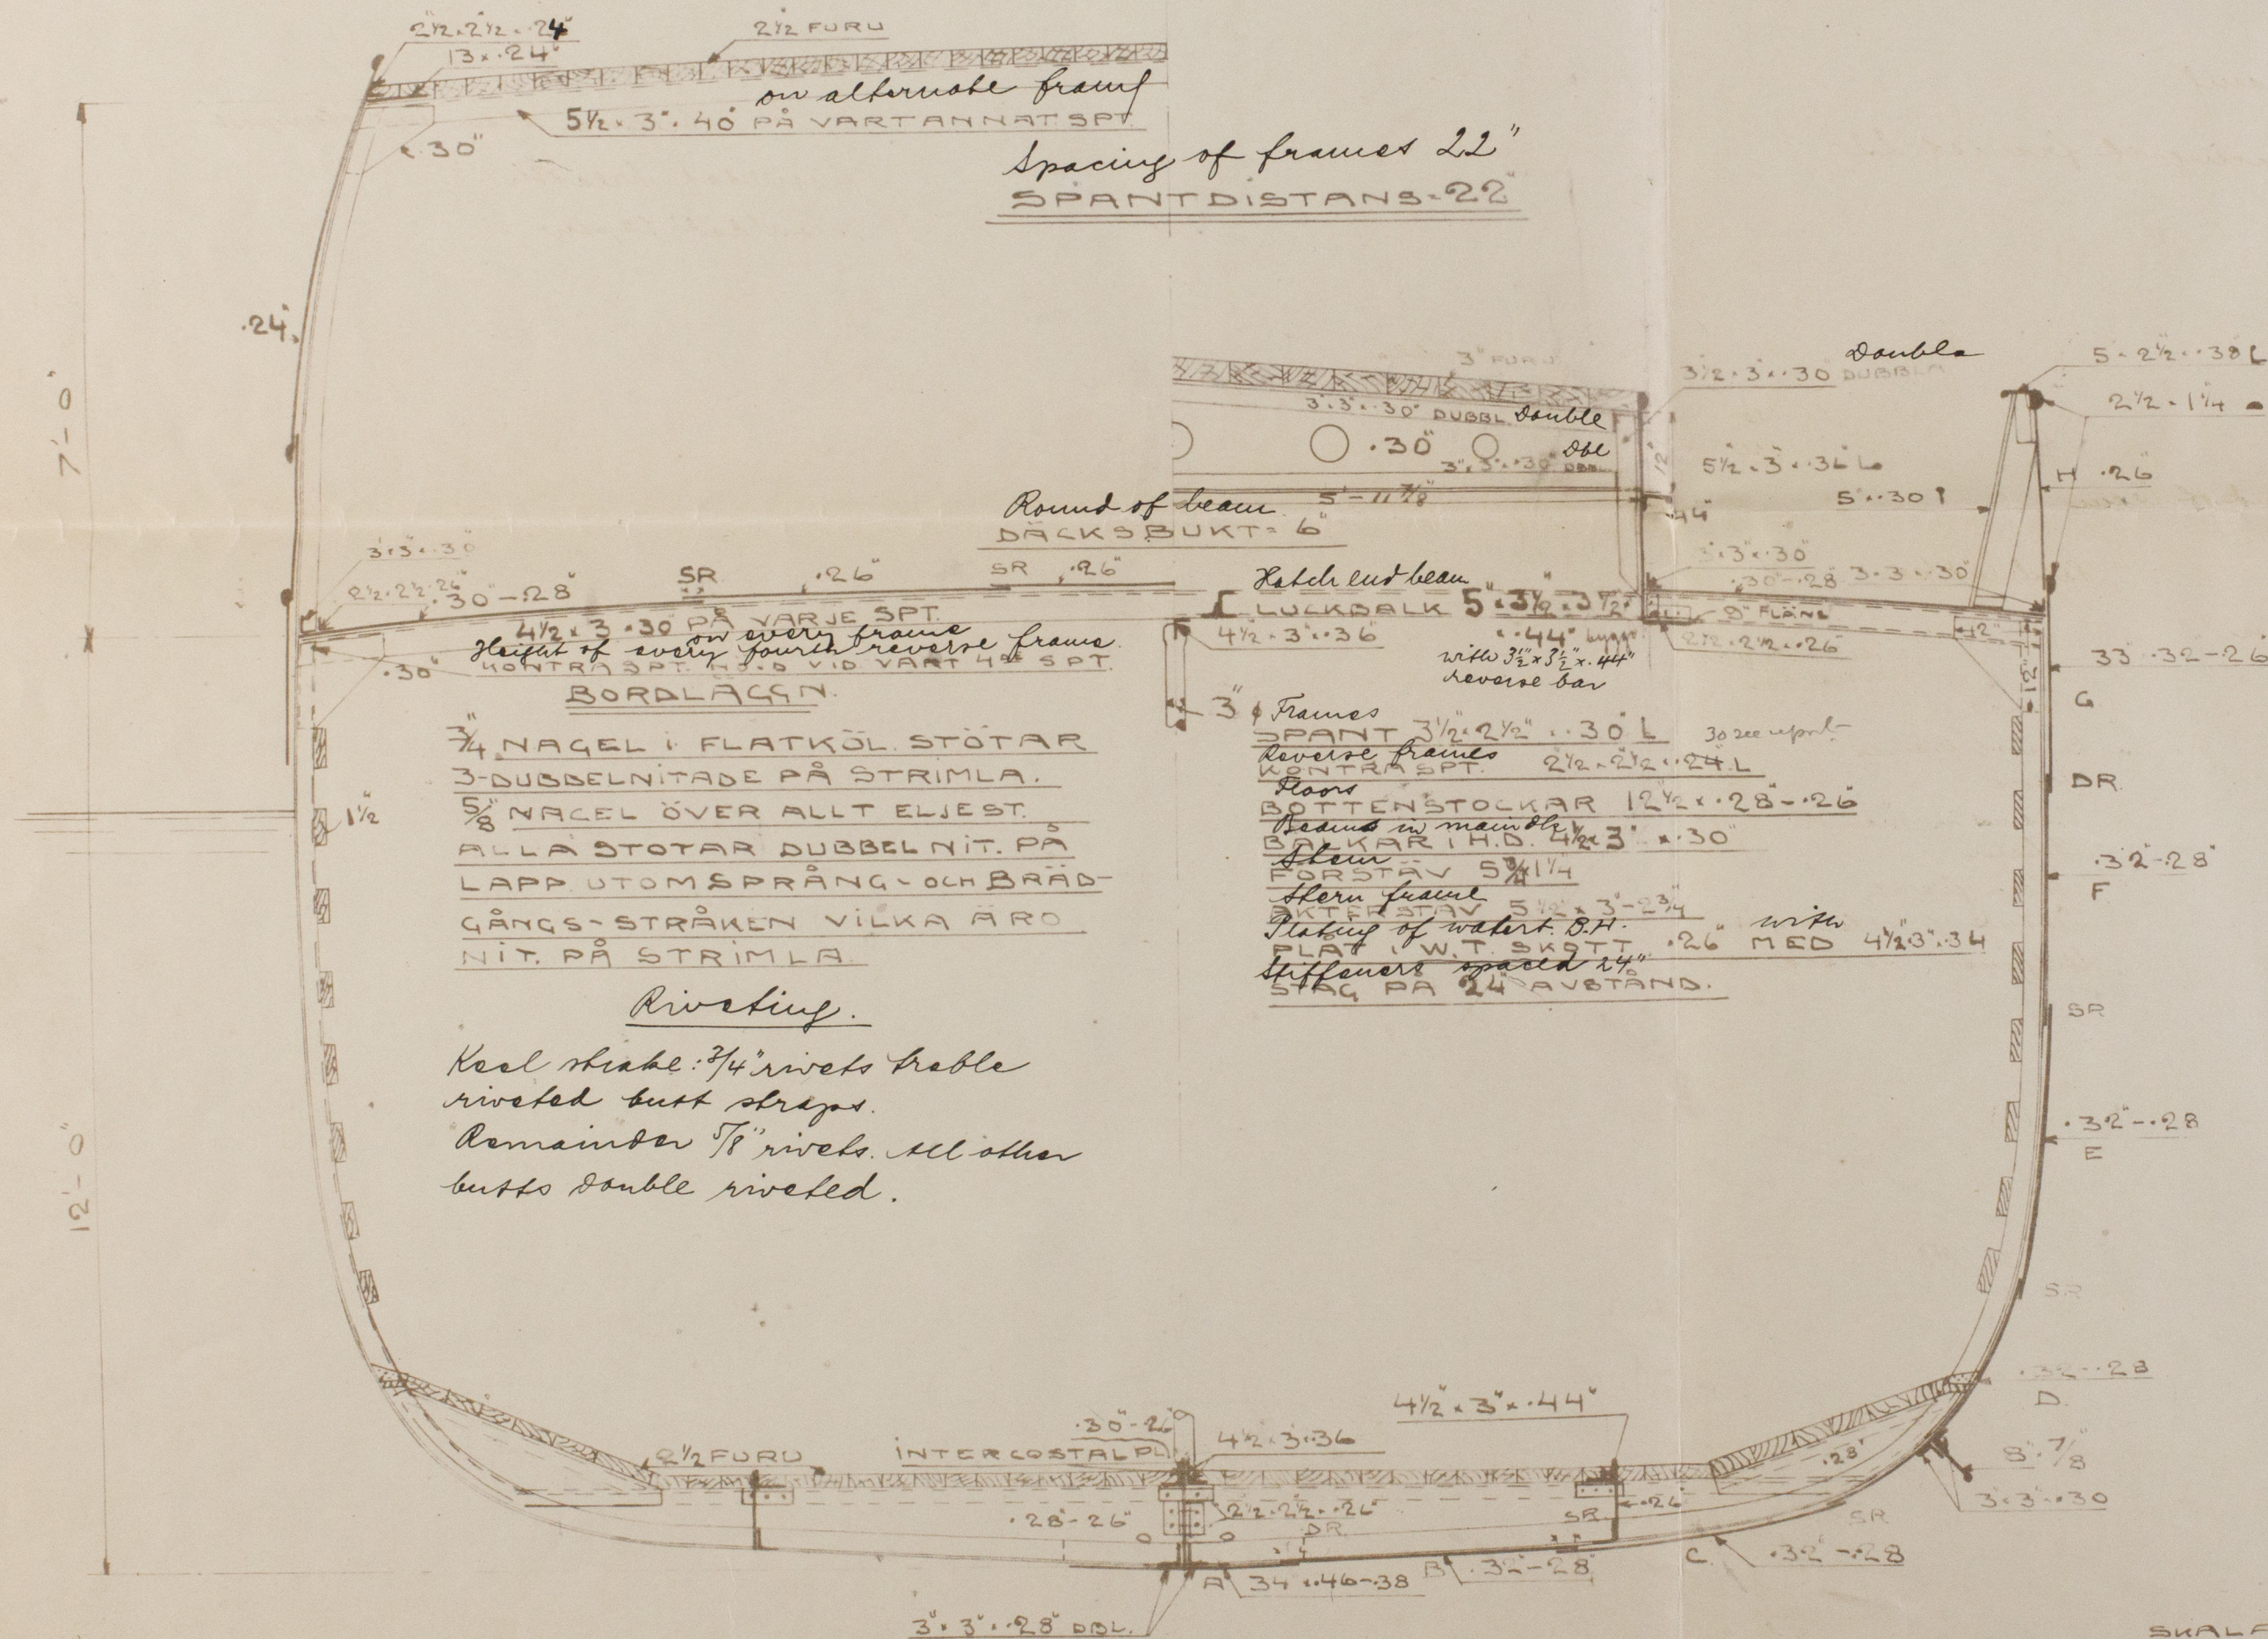

2	STOWERS ANCHORS EACH	4 1/4	CWTEX. STOCK
1	STREAM	1 1/4	" " " "
1	KEDGE	1/2	" " " "
120 FATHOMS	1 1/2" STUD CHAIN CABLE		
45	" 9 1/16	STREAM CHAIN OR 2"	STEEL WIRE
75	" 6"	HEMP	
90	" 4"	HAWSER	

S. P. Sure

Göteborg First Entry Report N^o 3074


Thorsköfs Mek. Verkstads (P. Larsson)
S. P. N^o 198.

Plan of vessel as built.
m/s



RETAIN

WS27-0301

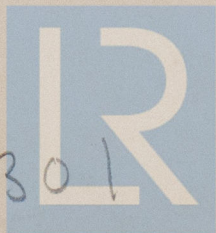

© 2020

Lloyd's Register
Foundation