
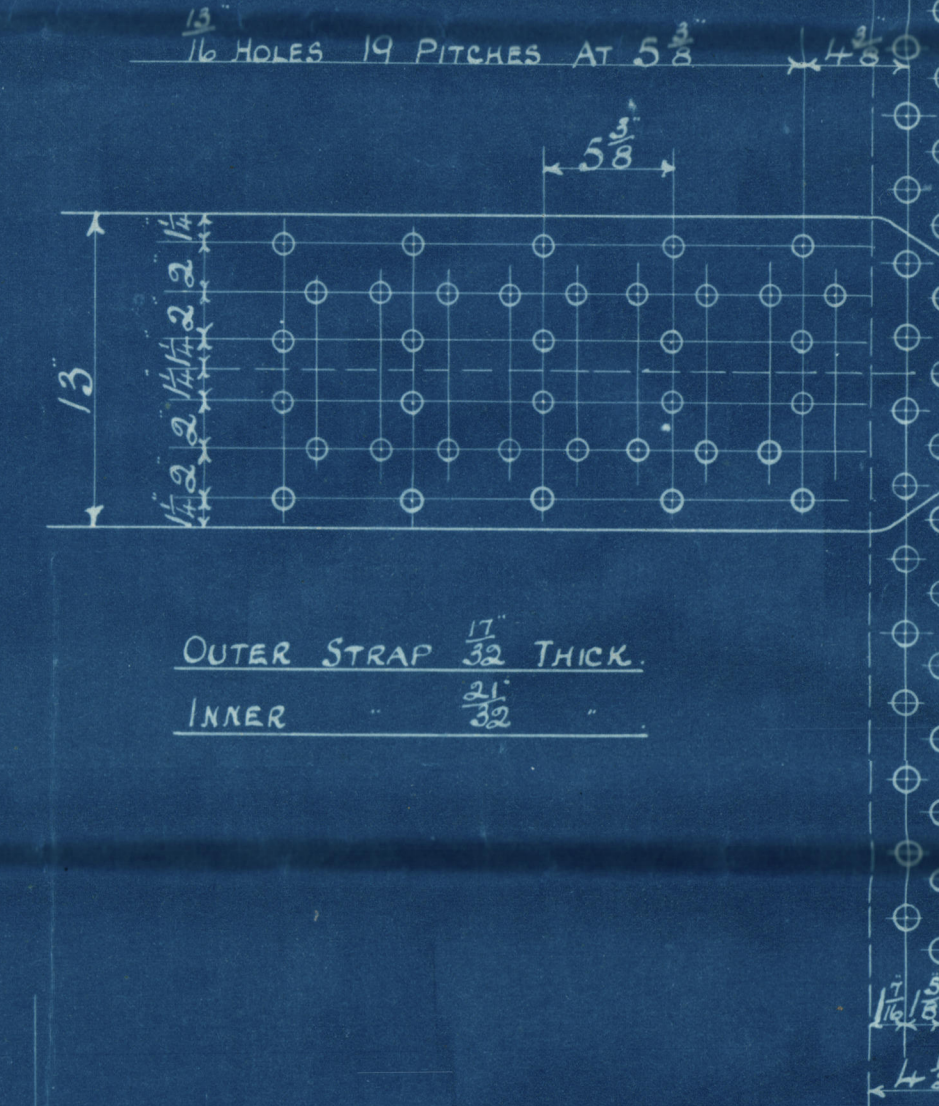


# STEEL BOILER 12-0 DIA 10-6 LONG 120 LBS W.P. LLOYDS

5653/4


## SPECIFICATION OF MATERIALS

SHELL STRAPS CIRDERS & MAINSTAYS 28 TO 32 TONS.  
BALANCE OF PLATES RIVETS & SCREW STAYS 26 30


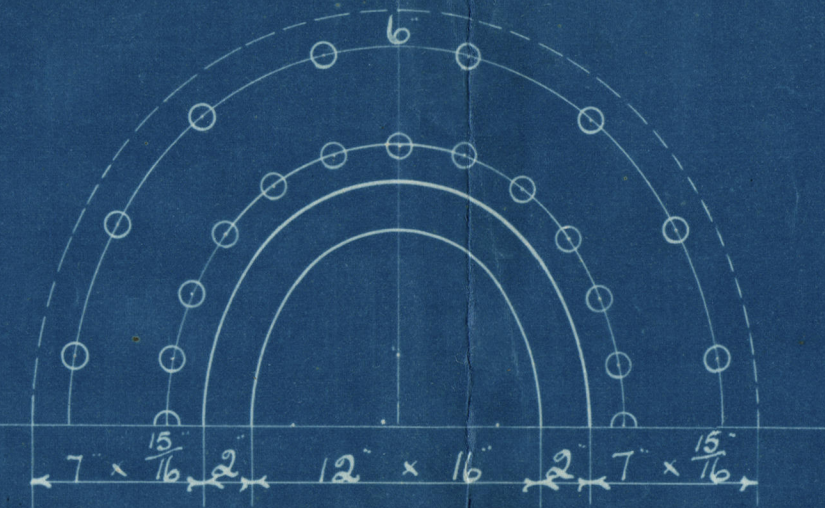


COMBUSTION CHAMBER SCREW STAYS  
SCREWED 9 TPI NUTTED AT ENDS.

AT BACK MARK 10 DIA  
AT BACK MARK 10 1/2 DIA  
AT SIDES & IN CIRDERS 10 1/2

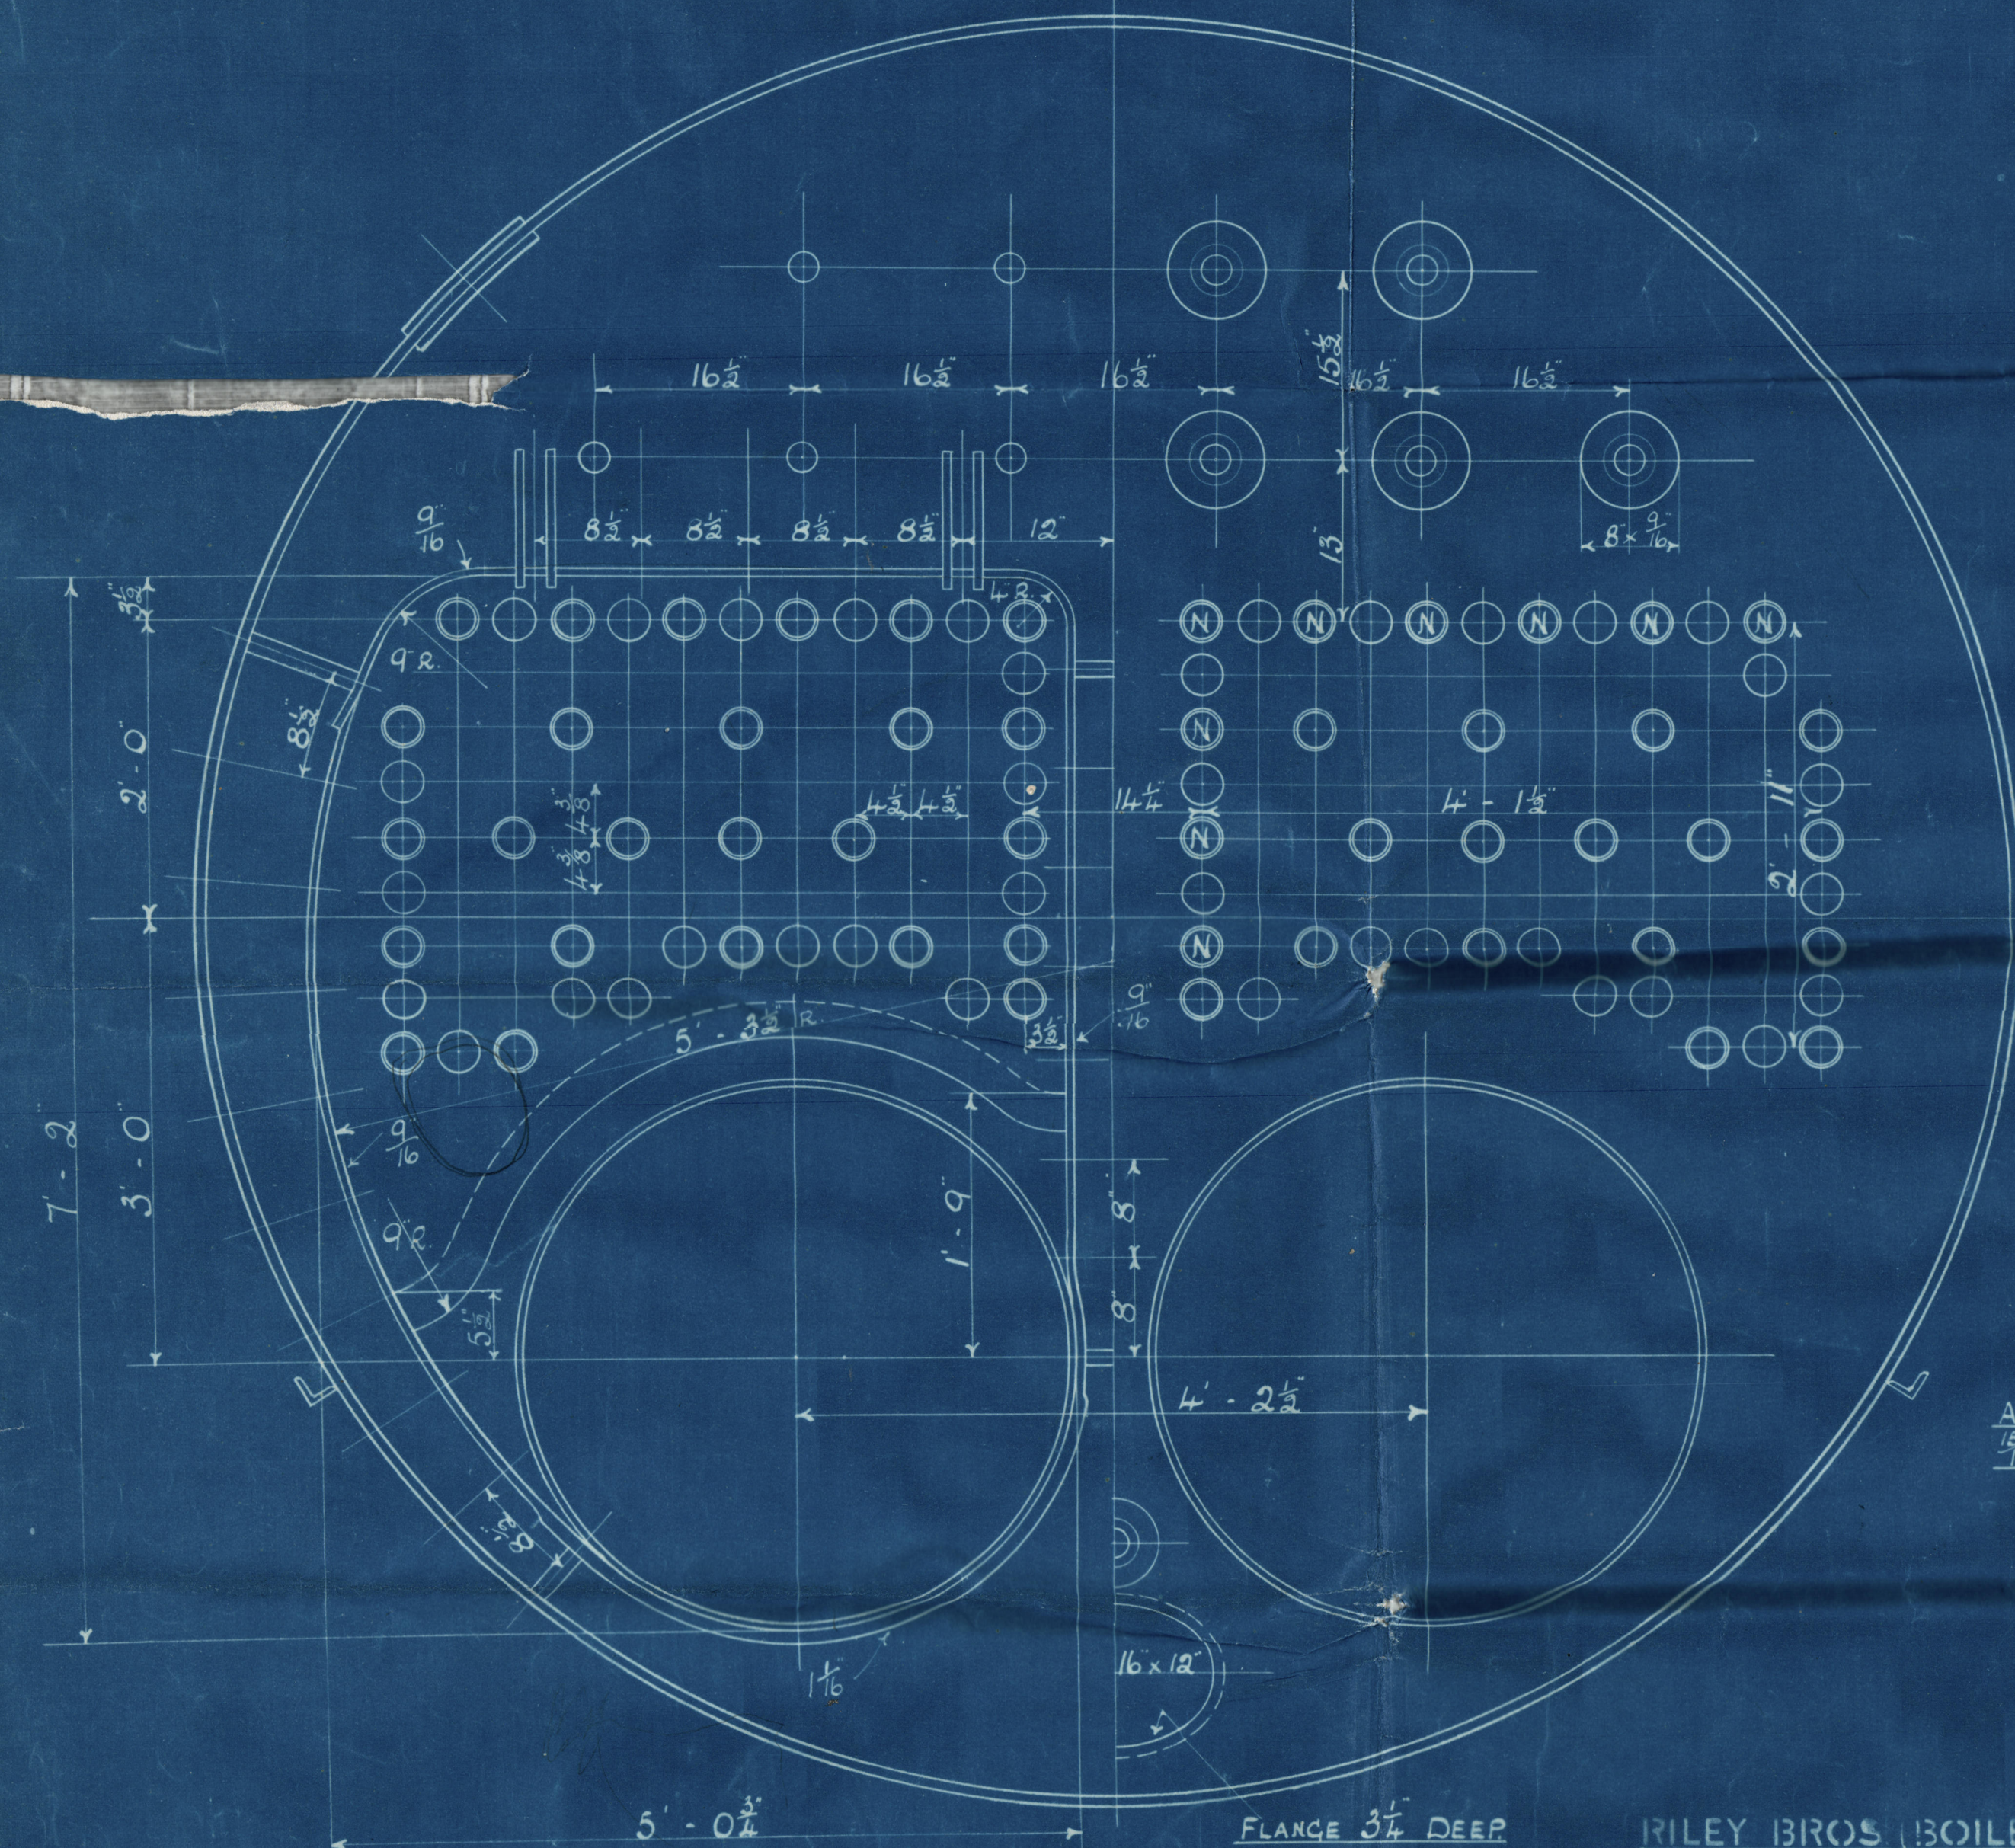

ALL INTERNAL RIVETING.  
16 HOLES 2 1/2 PITCH.

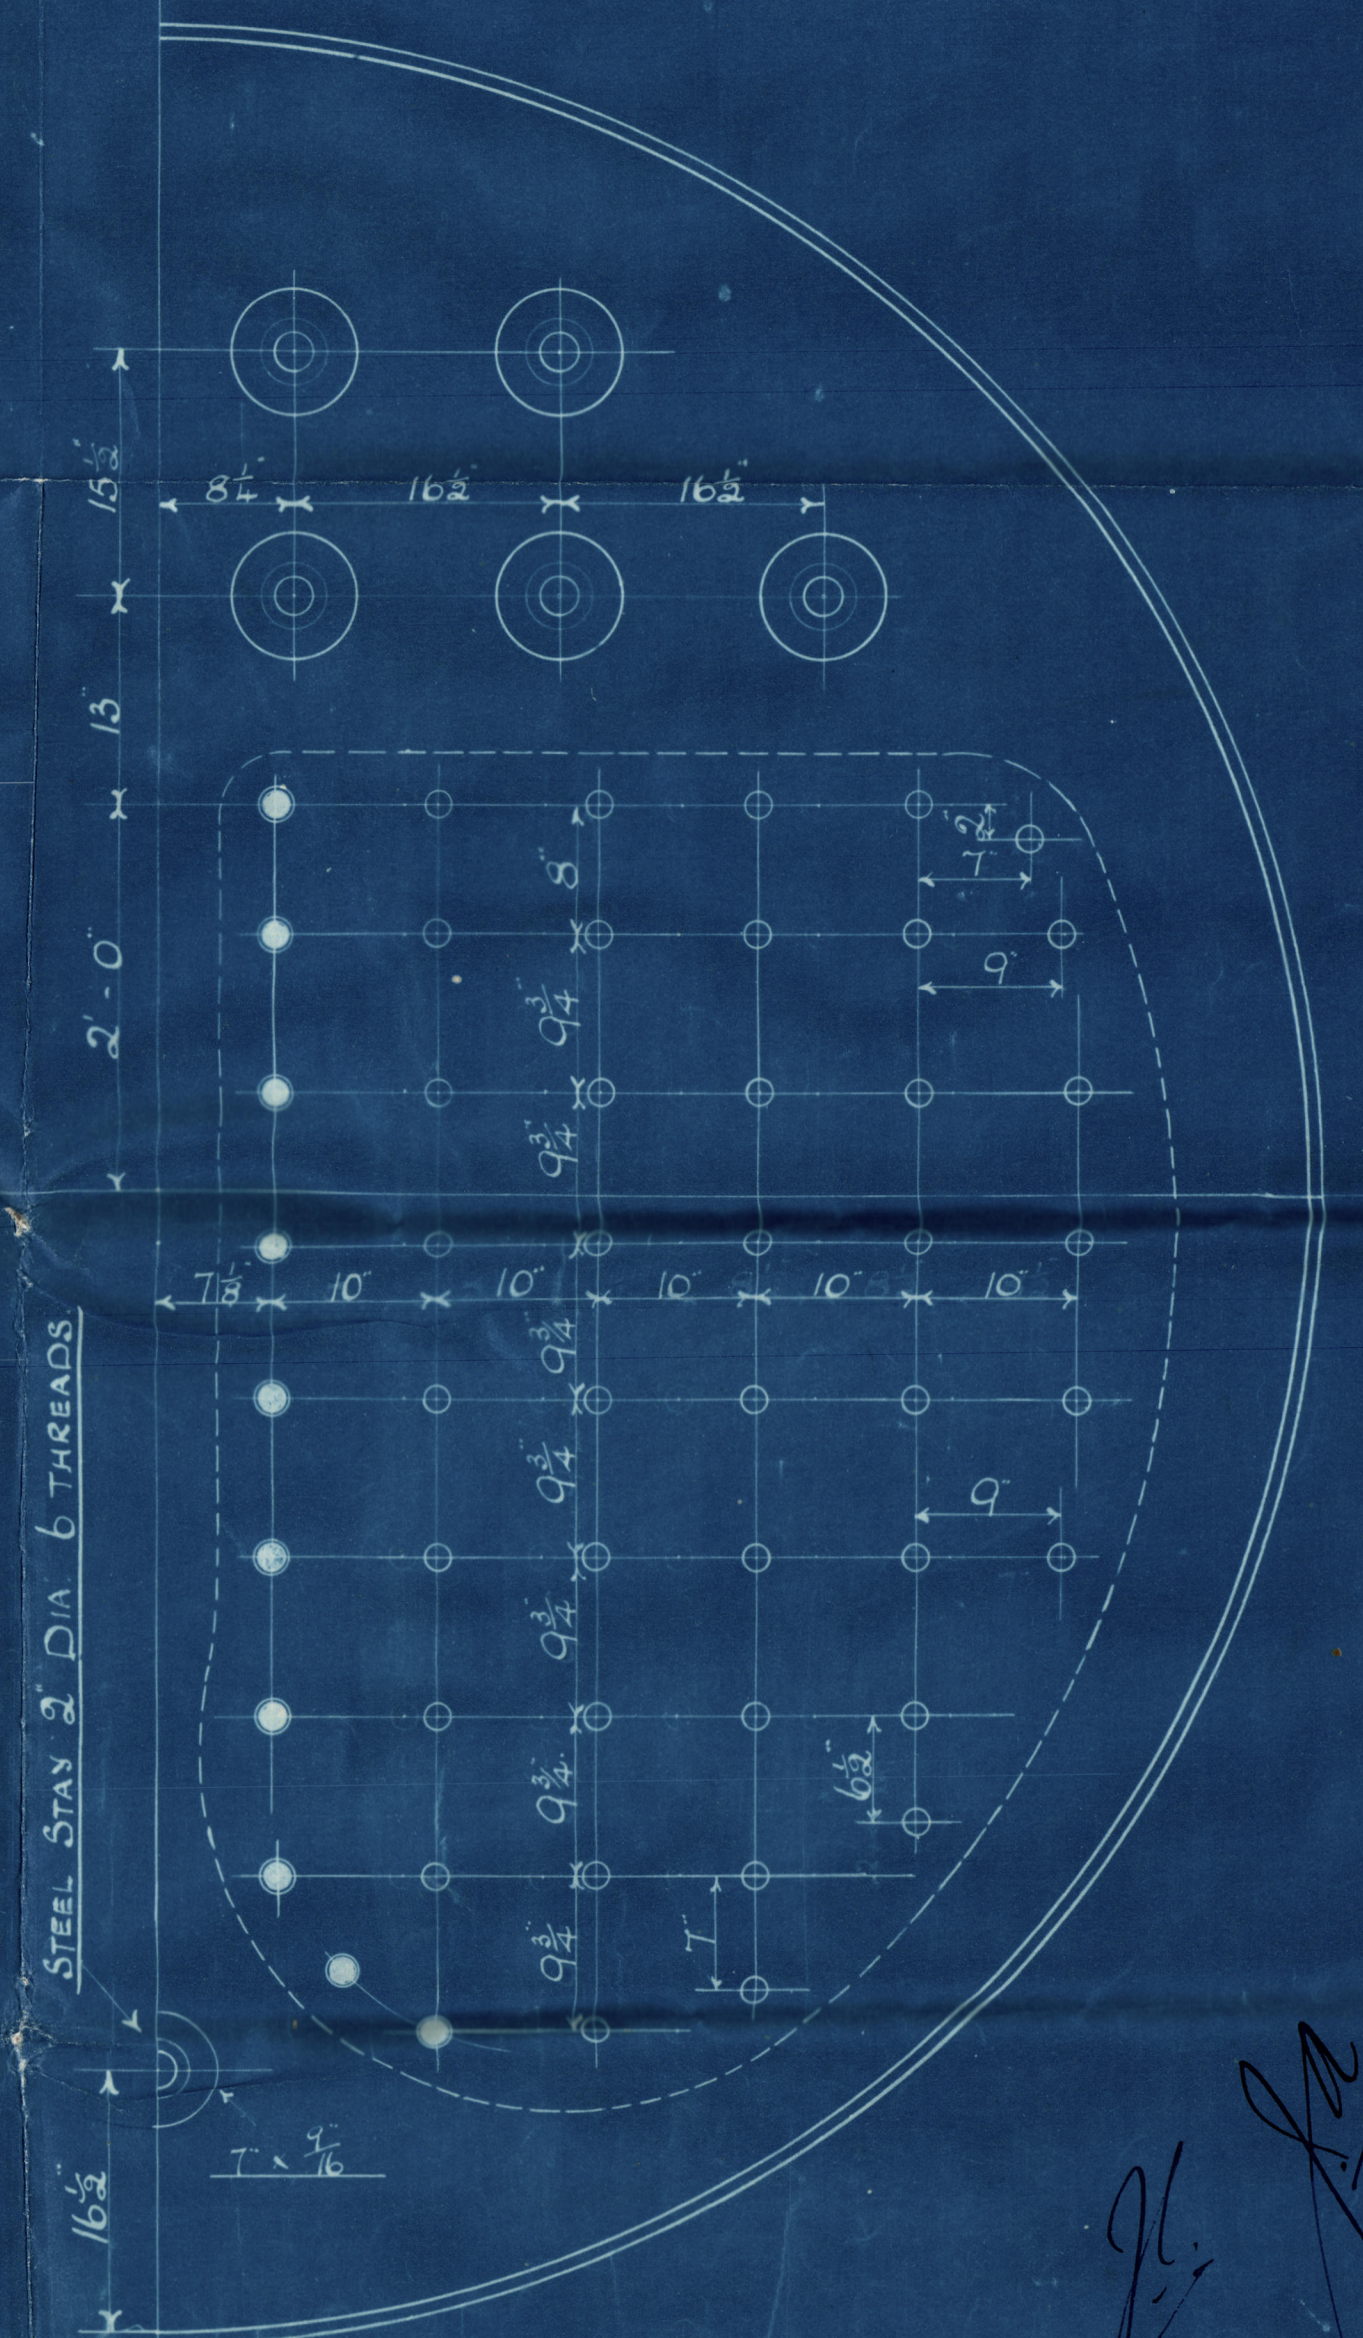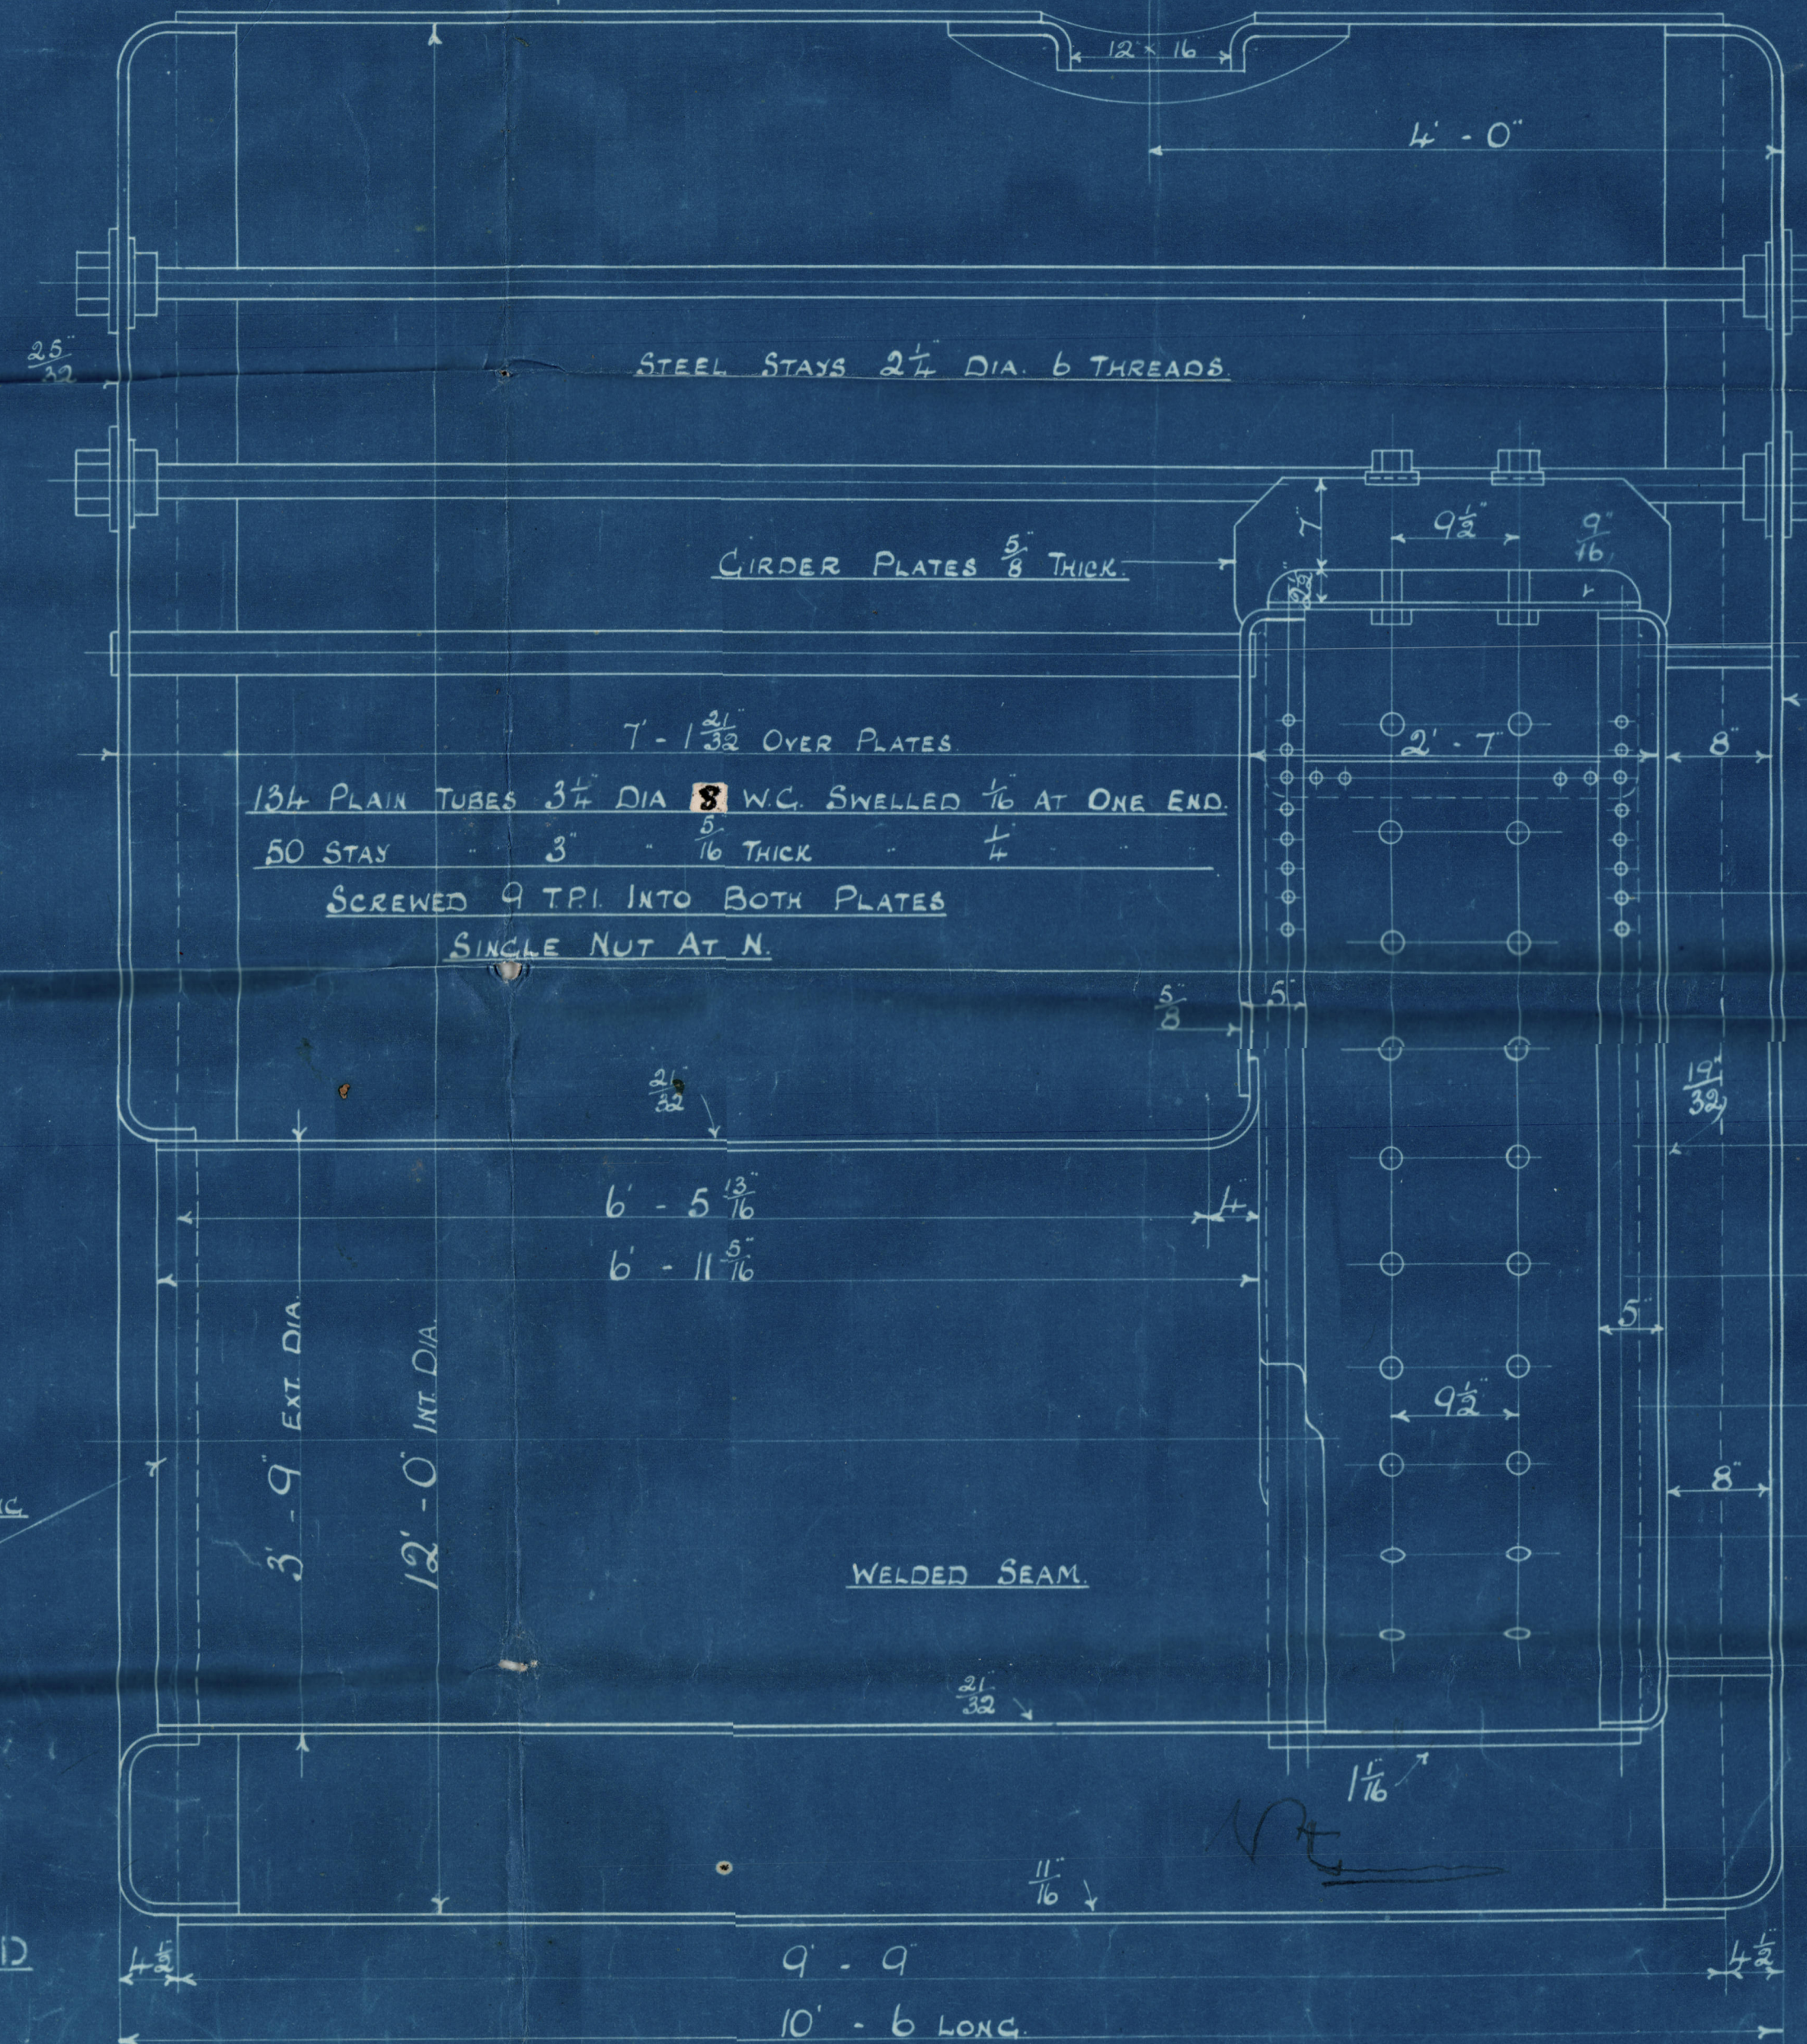

HEATING SURFACE 1330 sq ft  
GRATE AREA (5'-6" FIREBARS) 40 sq ft



*Anglo Peruvian*  
NEWCASTLE ON TYNE.

Report No. 80550.

262<sup>nd</sup>

*"Anglo Australian"*  
NEWCASTLE ON TYNE.

Report No. 81329

Rileys 5653 44  
12'-0" x 10'-6" x 120 lbs  
700  
Messrs Short Bros  
Sunderland

Duplicates of Bolemakas  
No 5597 Rlt No 12423  
with ~~exception~~ of plain  
lithes which are measured  
to 8 W.G. from 10 W.C.

5653  
No. 6508  
LLOYD'S TEST.  
220 lbs.  
W.F. 120"  
5-5-26. W.H.R.

RETAIN

No. \_\_\_\_\_  
LLOYD'S TEST.  
\_\_\_\_\_ lbs.  
\_\_\_\_\_  
\_\_\_\_\_



© 2021

W528-0326

Lloyd's Register  
Foundation





© 2021

Lloyd's Register  
Foundation

*Lloyd's*