

Lloyd's Register of British and Foreign Shipping.

(Report on Vessel No. _____ Port _____)

No. 6102A SHIP FORGINGS OR CASTINGS.



The words FORGINGS or CASTINGS, IRON or STEEL, should be struck out as may be required.

I have to report that the undermentioned Iron or Steel Forgings or Castings, manufactured by The Milton Forge Co. of Hartlepool for the Vessel No. 422, being built by Messrs. Popner & Sons of Stockton, have been inspected by me as set forth below and found to be, so far as can be seen, Sound.

Mark on Forgings.

Lloyd's
No. 6102A
F.C.

Mark on Rudder


Lloyd's
No 6102 A
F.C.

Frank Cook
J. Bennett
West Hartlepool


Sunderland

	STERN FRAME.	RUDDER FRAME.	STEM.
Material*	<u>Scrap Iron</u>	<u>Scrap Iron</u>	<u>Scrap Iron</u>
How made	<u>Forged</u>	<u>Forged & built</u>	<u>Forged</u>
Dimensions	<u>12" x 6 3/16"</u>	<u>9 1/2 to 7 1/4 dia</u>	<u>11" x 2 7/8"</u>
Progress on Inspection	<u>Forged & annealed</u>	<u>Forged & machined</u>	<u>Forged</u>
Date when Inspected	<u>11/4/05 to 19/5/05 27/6/05 to 17/8/05 4/3/05.</u>		

SKETCHES OF FRAMES SHOWING POSITION AND DESCRIPTION OF WELDS OF FORGINGS, OR PARTICULARS OF TESTS APPLIED TO CASTINGS.

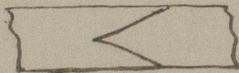

Welds

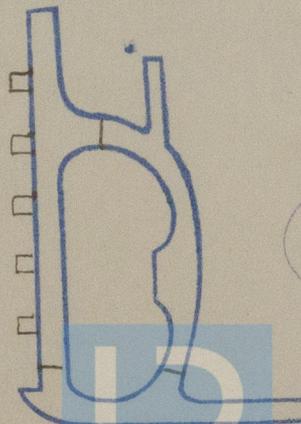

© 2021

Fee (if any chargeable) £ _____

To be paid at _____

* If of Iron, state whether scrap or puddled Iron.