

57/10/25

PROFILE AND DECK PLAN

Nº 992

DIMNS - 175' 0" BP x 29' 0" ML x 15' 0" ML

SCALE 1/8" INCH

TO CLASS + 100 A1 STEAM TRAWLER

PILLARING THROUGHOUT TO SURVEYORS SATISFACTION

PLAN No. 4485

FOR ENCLOSURE TO

Measure the Surveyors Lloyd's Register


HULL

FROM

COCHRANE & SONS, LTD.

SHIPBUILDERS, SELBY.


DATE 22/10/25

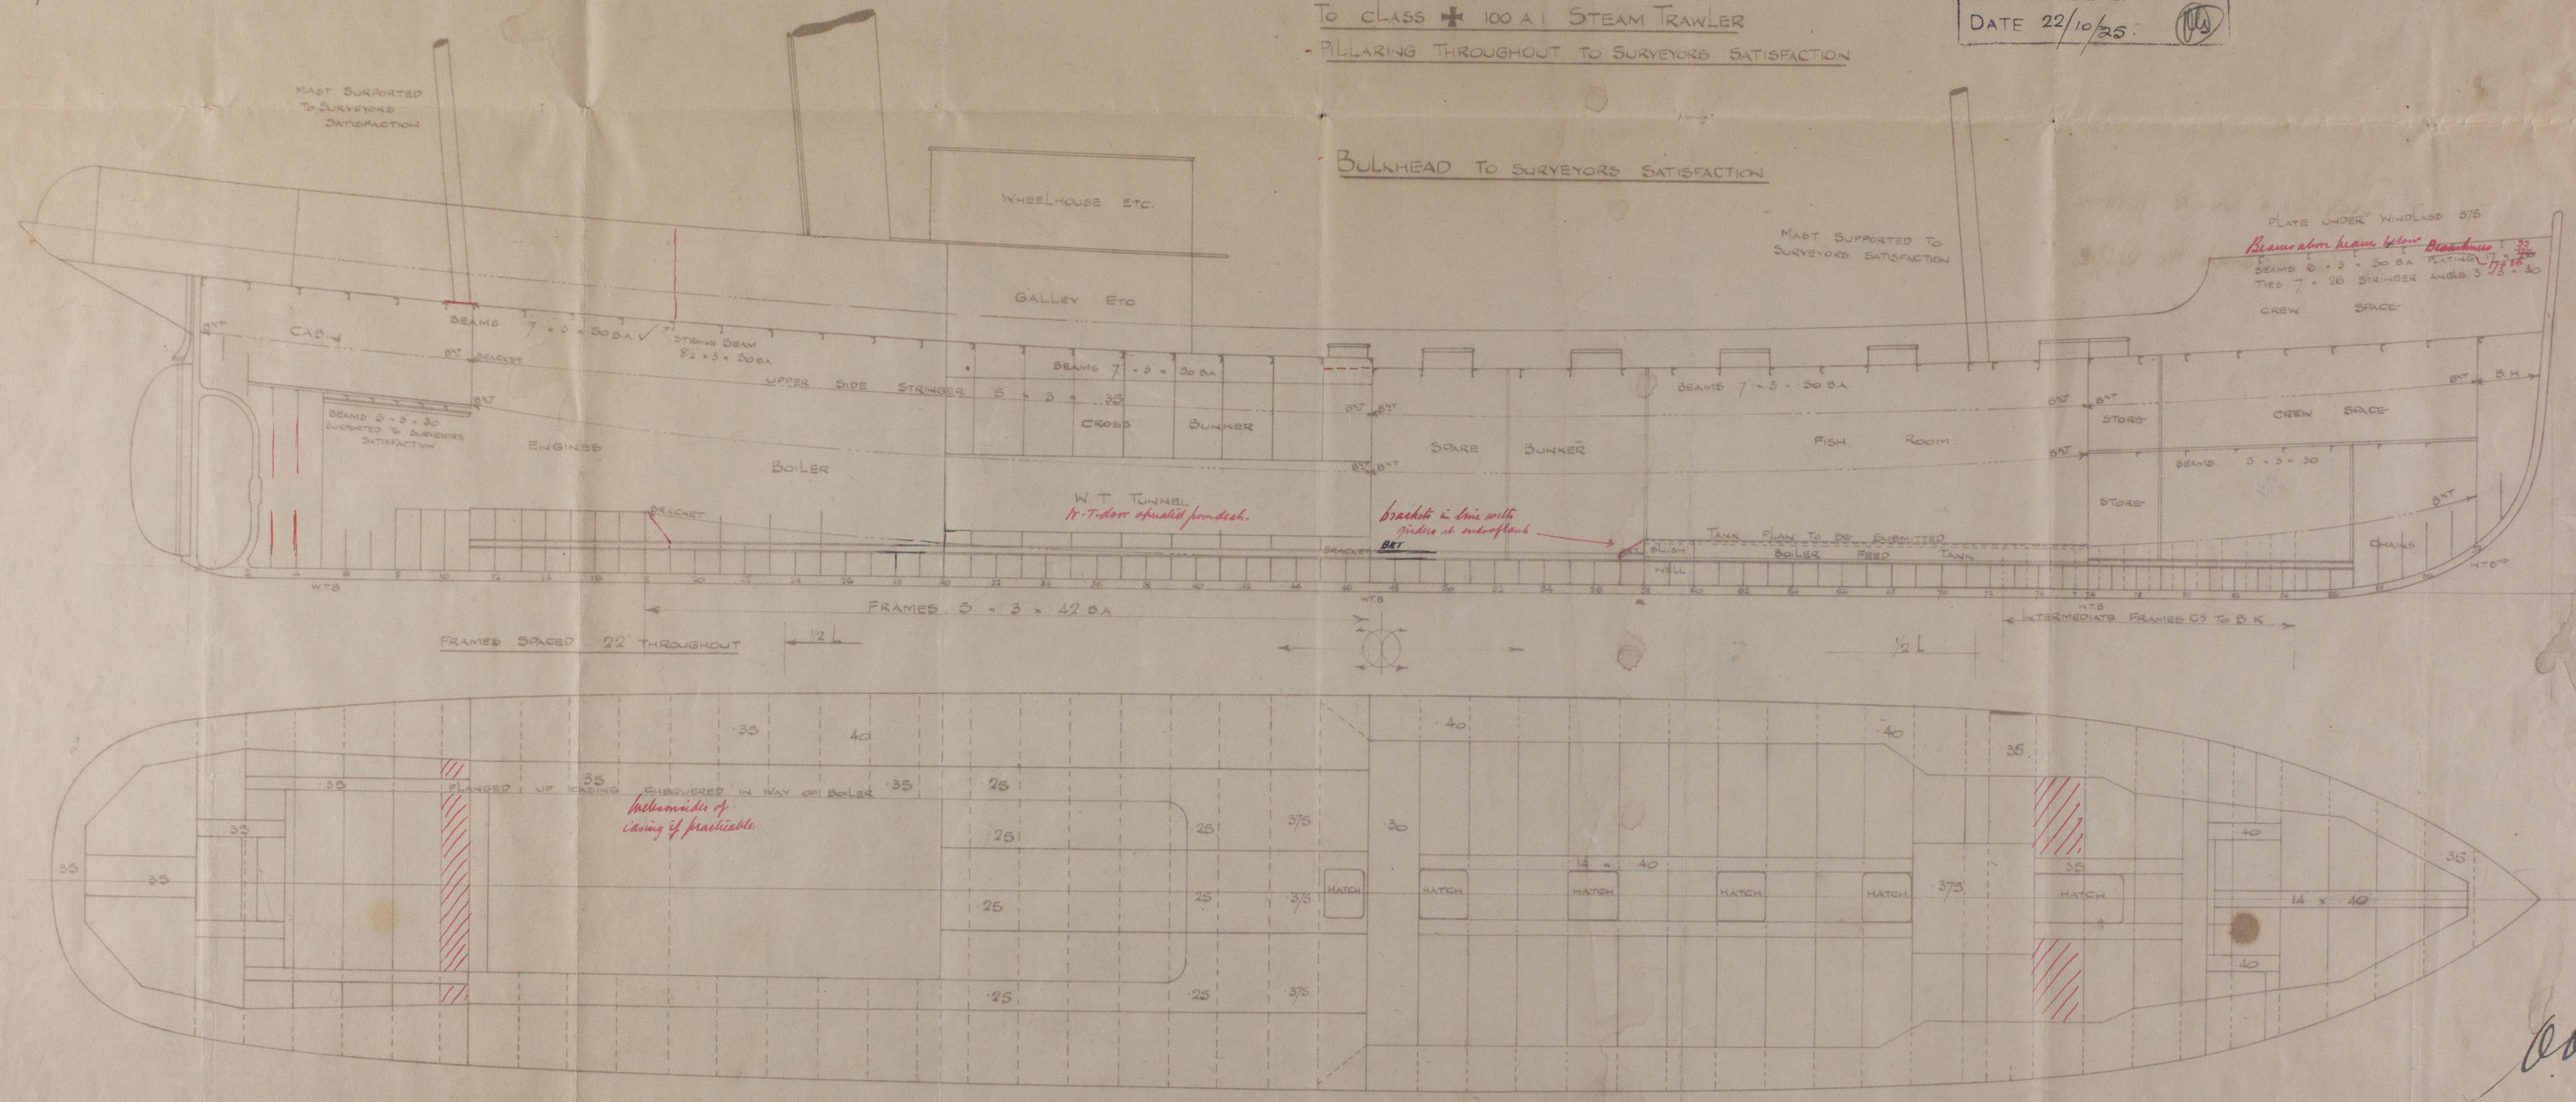

27.10.25

Profile & Deck plans
of Roachman's No. 992.
Hull First E. Report
No 36913

S.T. "Neptunia"

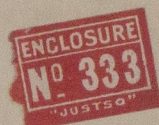

RETAIN

WS29-0084



© 2020

Lloyd's Register
Foundation