


6.7.01  
9.7.01  
11.7.01  
22.7.01  
15.9.01

BEAMS MARKED A BULBS  $10\frac{1}{2} \times \frac{15}{16}$ , SINGLE ANGLE  $5\frac{1}{2} \times 3\frac{1}{2} \times \frac{12}{16}$   
 B  $12 \times \frac{11}{16}$ , 4 ANGLES  $6 \times 4 \times \frac{9}{16}$  WITH LARGE GUSSETS.  
 C  $\frac{3}{4}$  L BEAMS BULBS  $10\frac{1}{2} \times \frac{15}{16}$  DOUBLE ANGLES  $3\frac{1}{2} \times 3\frac{1}{2} \times \frac{9}{16}$ .  
 D BULBS  $9 \times \frac{9}{16}$ , SINGLE ANGLE  $5\frac{1}{2} \times 3 \times \frac{11}{16}$   
 E  $9 \times \frac{9}{16}$ , DOUBLE ANGLES  $3\frac{1}{2} \times 3\frac{1}{2} \times \frac{7}{16}$

# PROFILE S.S.N<sup>o</sup> 649.

SCALE  $\frac{1}{8}$  = ONE FOOT.

QUARTER PILLARS MARKED THUS QP  
PORTABLE PP

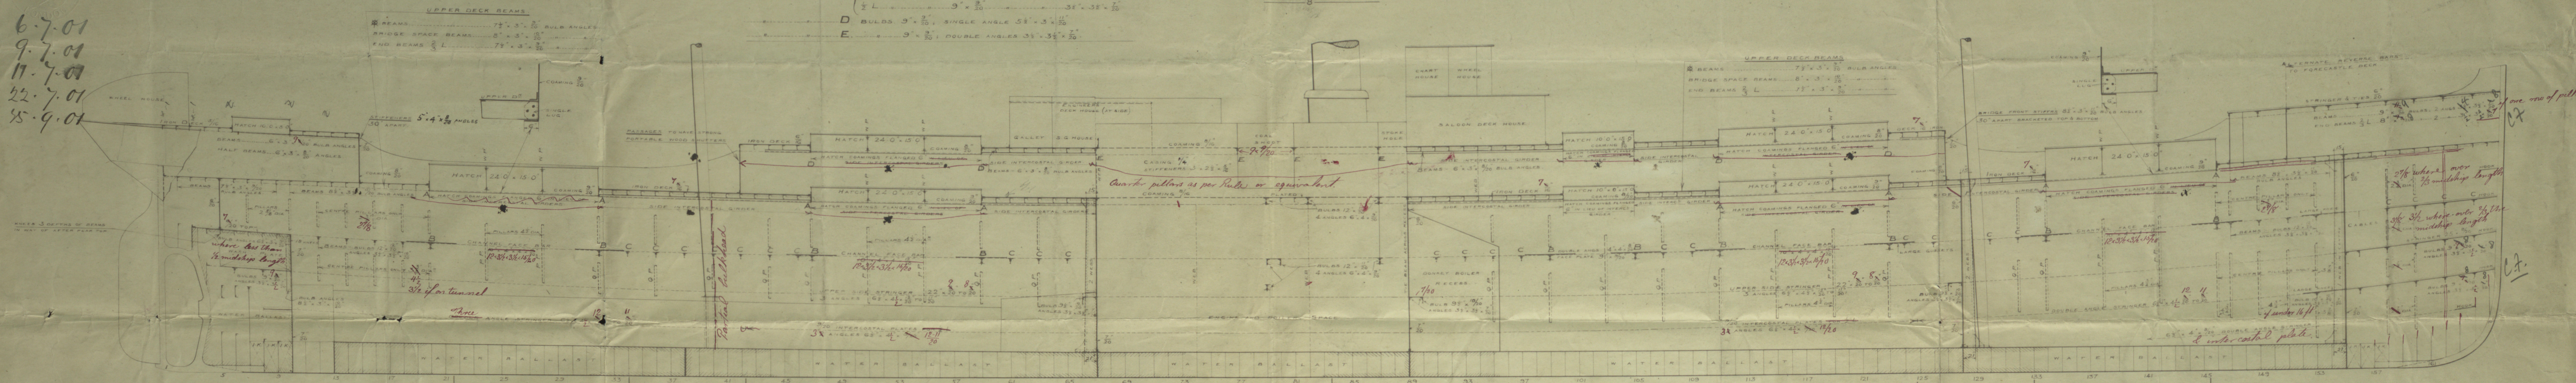

649.

649.

Builder proposed to flange side coamings 6" under the beams in lieu of side intercostal girders in way of hatchways approved per Sec<sup>r</sup> letter 11.25.9.01.

W. GRAY & CO. LIMITED  
WEST HARTLEPOOL





D. Gray H<sup>2</sup>

h<sup>2</sup> 649

Profile

"Marie H. Michalinos"

Hpl. Report no. 11751

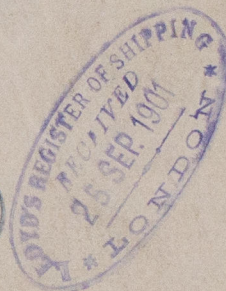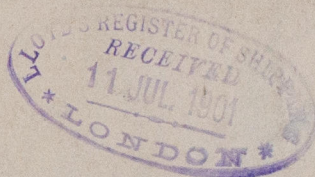

RETAIN



© 2020

Lloyd's Register  
Foundation

W529-9187