


27.4.14

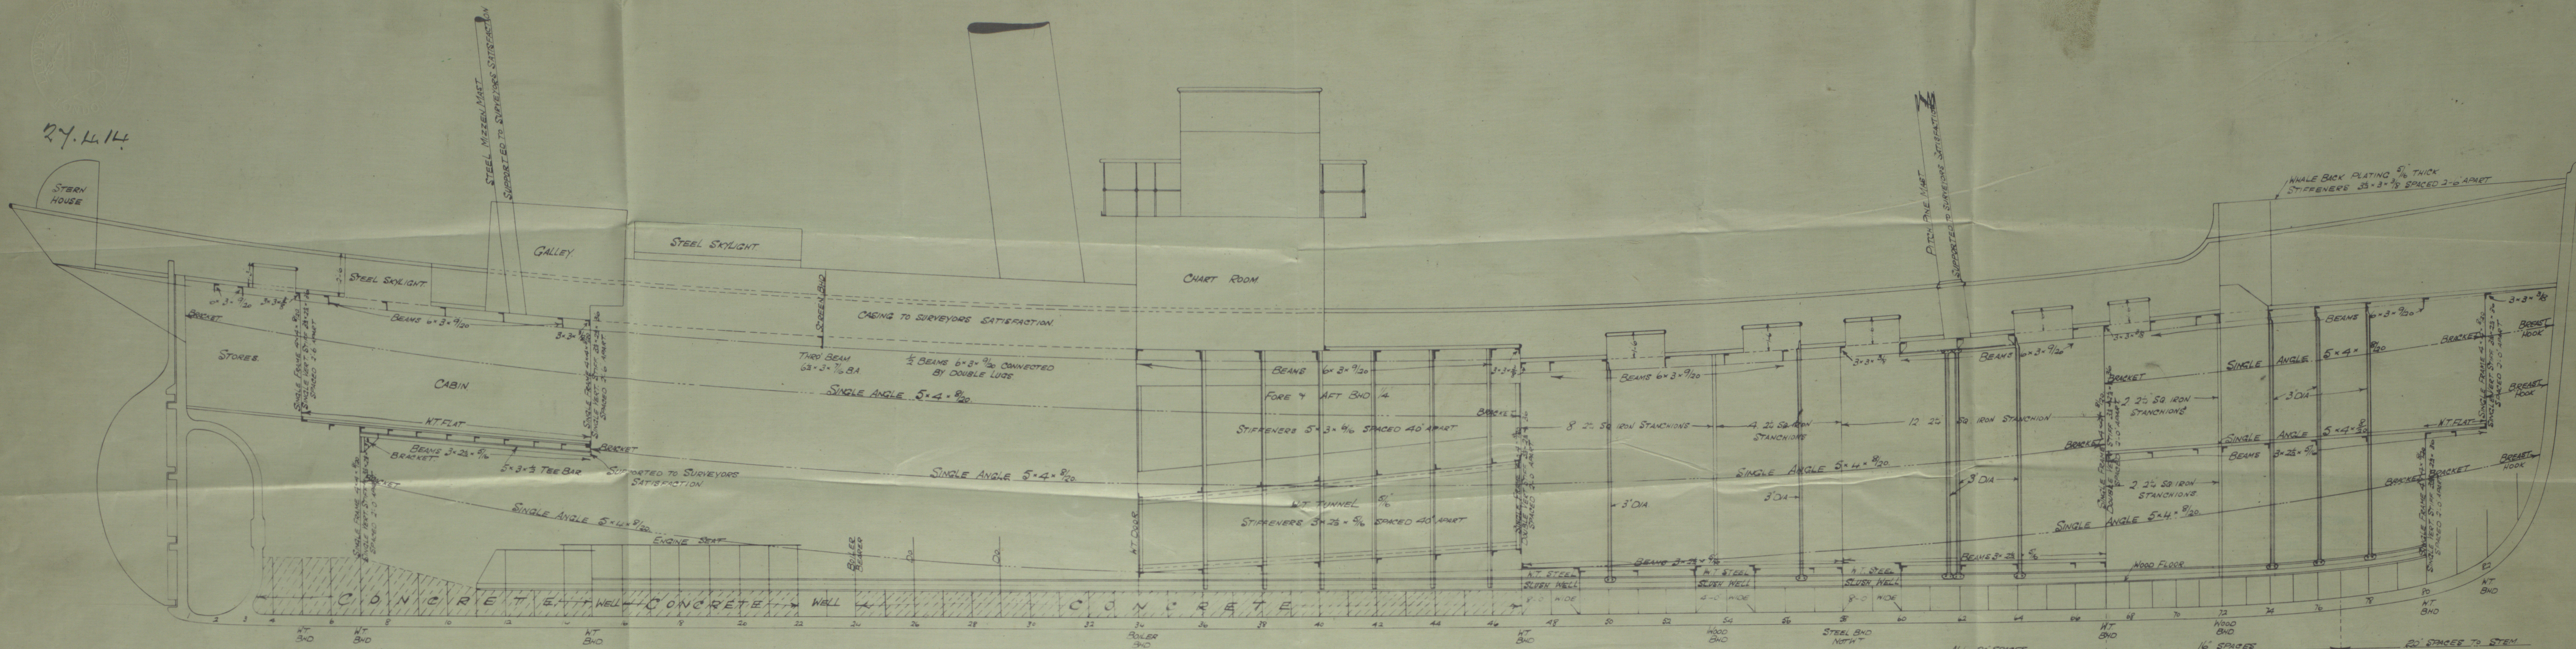

# BEAM ARRANGEMENT.


DIMENSIONS - 137' 0" BP x 23' 9" EA x 13' 7" MD  
SCALE 1/4" = 1 FOOT

PILLARING THROUGHOUT TO SURVEYORS SATISFACTION

Nº 312.

SUBMITTED TO LLOYDS 1914  
APPROVED BY LLOYDS 1914

COOK, WELTON & GEMMELL LTD  
SHIPBUILDERS  
BEVERLEY

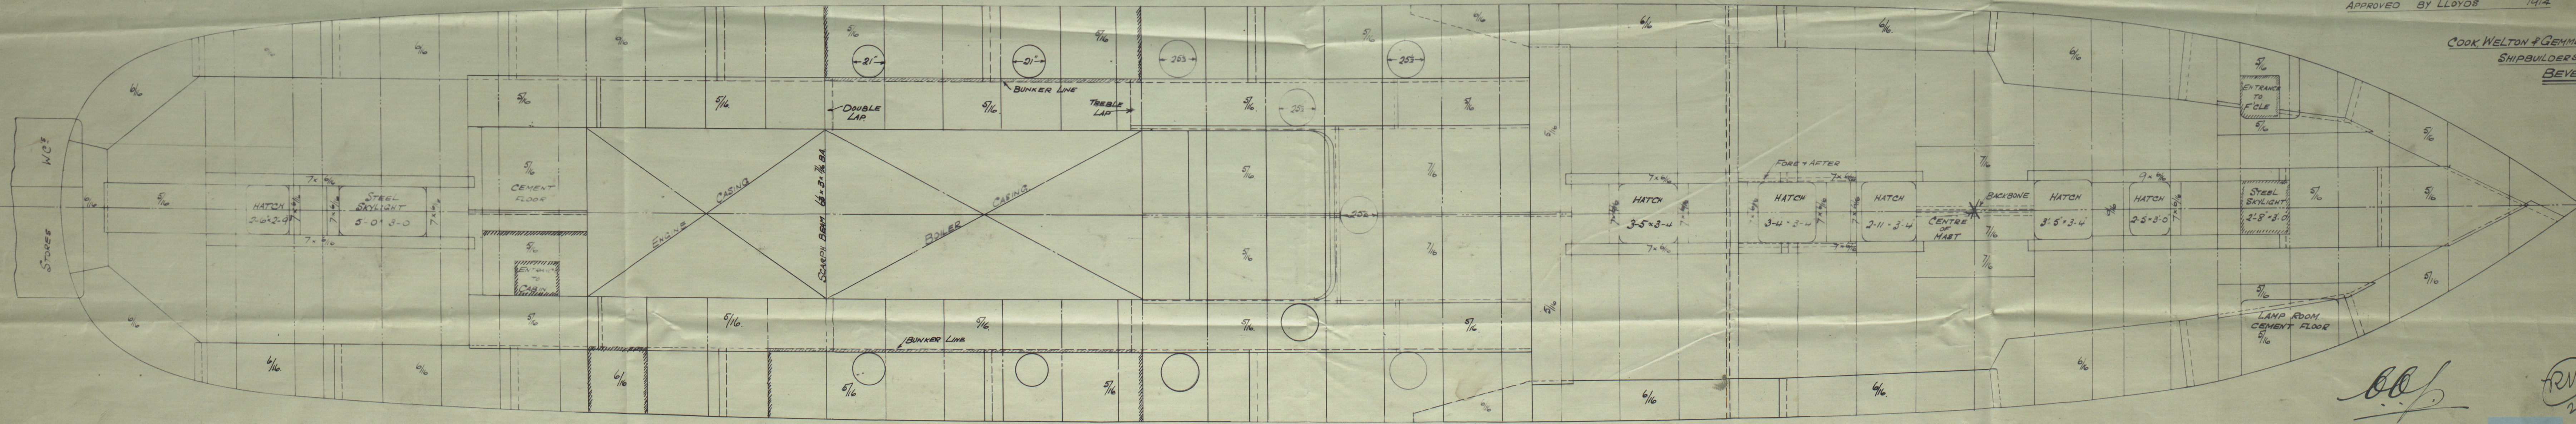

27.4.14

27.4.14


Lloyd's Register  
Foundation

W529-0165



Cook, Melton & Gemmels  
No 312


Profile & Deck Plans

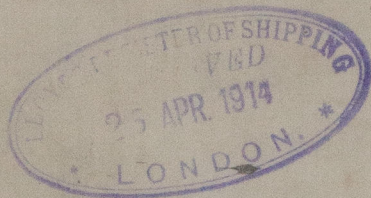


S.S. "Seaward" No Hull Rpt No  
28572

RETAIN

W 529-0165

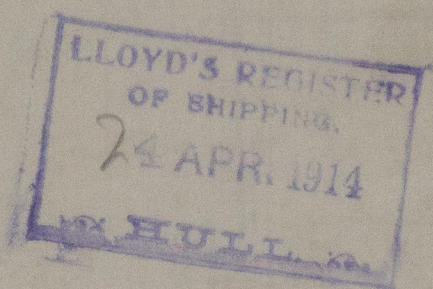

W 529-0165

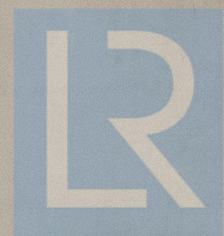

© 2020

Lloyd's Register  
Foundation