

6.1.12
12.11.12

S.S. No. 225


SCALE 1/2" = 1 FOOT
TO BE CLASSED '100 A.I. AT LLOYD'S' AND BE BUILT UNDER SPECIAL SURVEY.

FORECASTLE DECK 33' 6" 0" x 7' 0" ABOVE MAIN D⁵
BRIDGE HOUSE 11' 0" x 8' 0"
RAISED OR D⁵ 12' 0" x 4' 0"

BRIDGE STRINGER ANGLE 3" x 3" x 28'
SIDE PLATING 28'
FORECASTLE STRINGER ANGLE 3" x 3" x 28'
SIDE PLATING 28'

DIMENSIONS
199' x 30' x 13' 7" M²

199' 0" x 30' 0" x 13' 7" M² TO MAIN DECK 17' 7" M² TO Q³ DECK
B = 30' 0"
D = 13' 58" = 14' 66" D.I.N.L.
43' 58" = TRANS N²
199
8672 = LONG N²

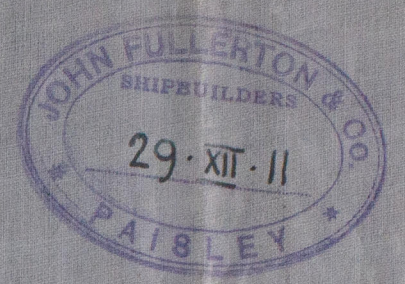


LONG N² 8672
Q³ DECK 484
BRIDGE HOUSE 44
FORECASTLE 162.75
CASINGS 203.46
EQUIPMENT No. 9566/21

MAIN AND QUARTER DECK BEAMS OF 5 1/2" x 3" x 34" ANGLES ON EVERY FRAME (CARLINGS 5" x 3" x 34")
FORECASTLE 5" x 3" x 34"
BRIDGE 5" x 3" x 34" ALT. (Deckhouse only)
FORE PEAK BEAMS OF 4" x 2 1/2" x 30" EVERY

alternative arrangement
3 Strakes increased 1/4" in lieu
of Side Stringers

EQUIPMENT No. 9566/21
2 BOWER ANCHORS 19 DWT STOCKLESS
1 BOWER ANCHOR 16 1/2"
1 STREAM 5 1/2" EX. STOCK
1 KEDGE 2 1/2"
210 FATHOMS 1 1/2" STUD CHAIN CABLE (BS 212)
60 3/4" STEEL WIRE
90 3"
90 6" HAWSER
90 5" WARD

RIVETING
STRAP BUTTS OF GARBOARD STRAKE FOR 1/2 L, LAP BUTTS OF SHELL, EXCEPT F STRAKE, FOR 1/2 L LAP BUTTS OF C³ GIRDER IN DOUBLE BOTTOM, LAP BUTTS OF DECK STRINGER PLATES FOR 1/2 L, LAP BUTT OF BOSS P² TO BE TREBLE RIVETED.
LAP BUTTS OF G STRAKE TO BE QUADRUPLE RIVETED FOR 1/2 L
KEEL, STEM, STERNPOST, LAP BUTTS OF SHELL BEFORE & ABAFT 1/2 L
LAP BUTTS OF DECK STRINGER BEFORE AND ABAFT 1/2 L, DECK TIES, LANDINGS OF SHELL, EXCEPT LOWER EDGE OF E STRAKE, LAP BUTTS OF DECK PLATING FOR 1/2 L, BULKHEAD PLATING TO FLOOR PLATING.
LAP BUTTS OF TANK TOP PLATING FOR 1/2 L, ALL TO BE DOUBLE RIVETED.
LAP BUTTS OF D⁵ PLATING AT ENDS, OF TANK TOP PLATING AT END LOWER LANDING OF E STRAKE TO BE SINGLE RIVETED.

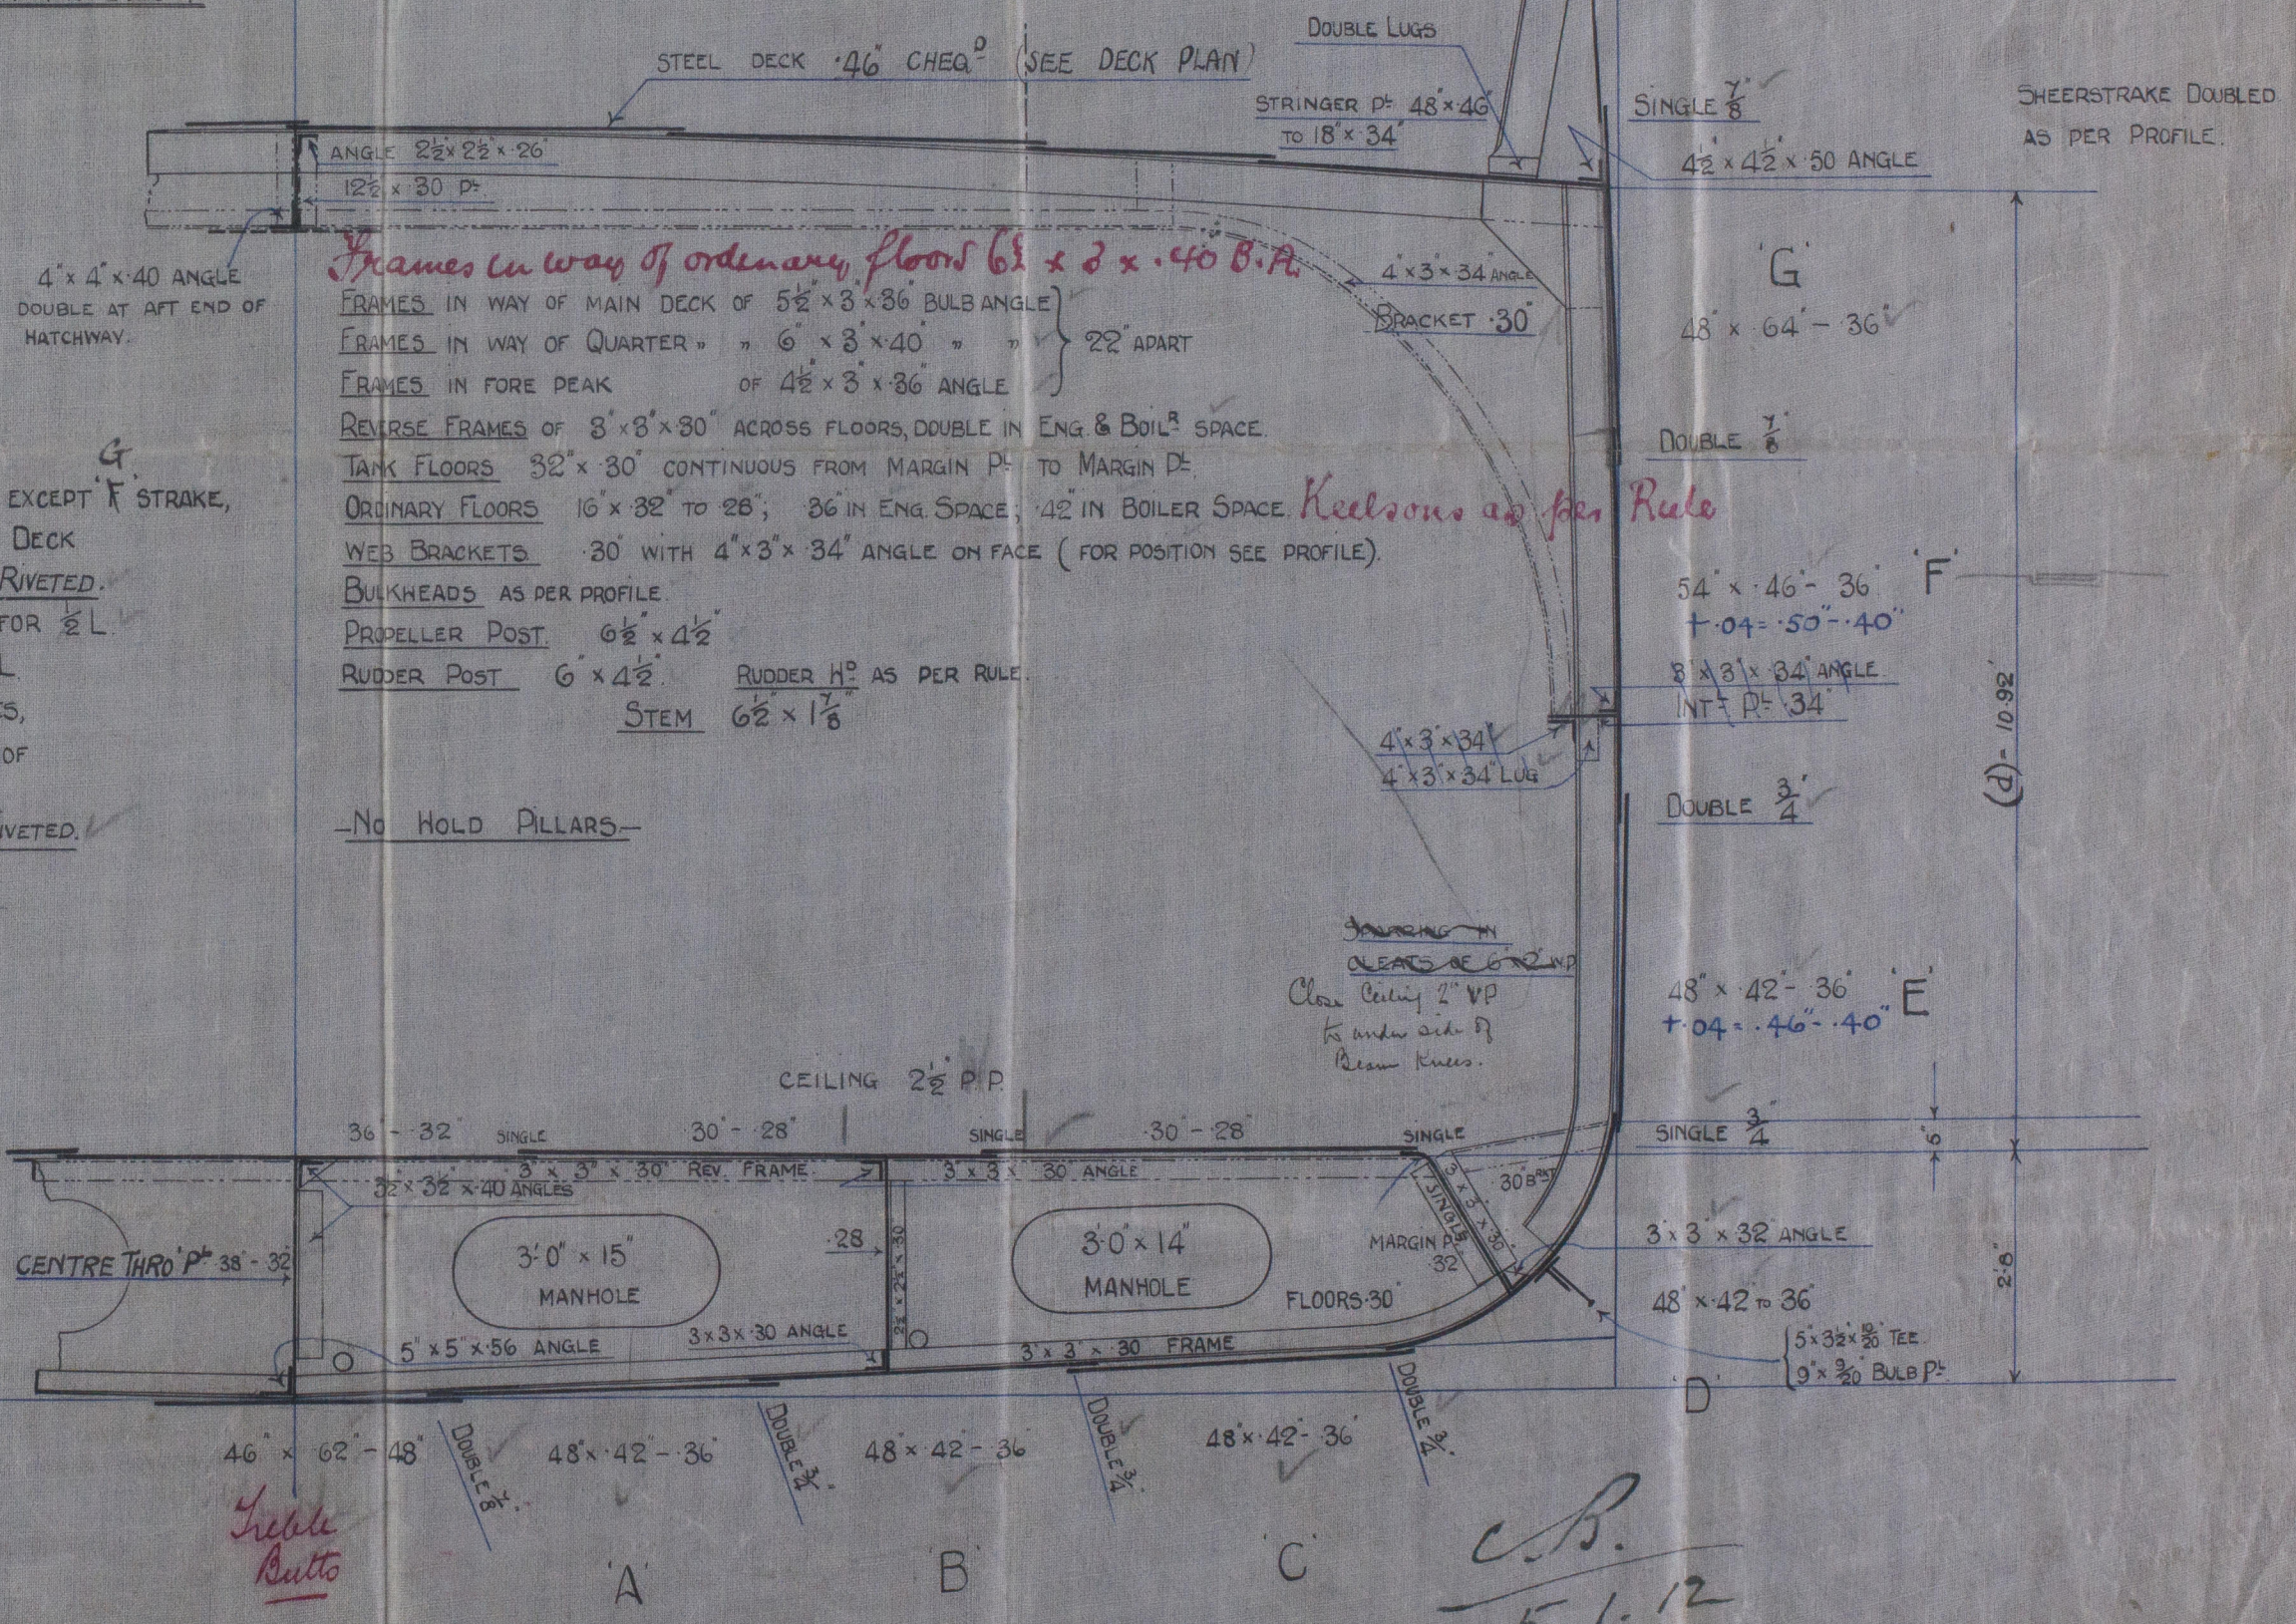

See "Clydebank"

Sh Rpt No 29406

W
Fiddlers No 225

Midship, Acton







GLASGOW REPORT No. 32144.

W529-0213



© 2020

Lloyd's Register
Foundation