


6.1.12  
12.11.12


# PROFILE & DECK PLAN S.S. N° 225

SCALE 1/4" = ONE FOOT

Masts Supported to Surveyors Satisfaction

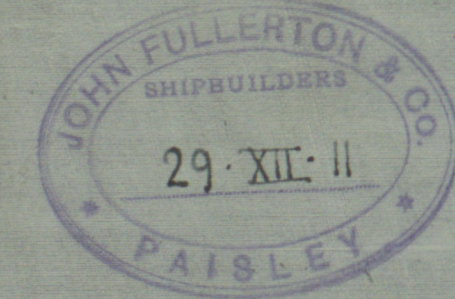

SECT. IN WAY OF HATCH

 


S.S. Blarney.  
ex "Bambrook Castle"

re-liveries  
15/7/31.  
New!

Hatchways closed.  
Sh. plated over.  
Platform fitted in hold.  
to be carrying out. altered.  
Cattle stalls fitted in hold.

Bottom strengthened forward as per Rule  
+ to Surveyors Satisfaction

 

C.B.  
5.1.12.

W529-0214



GLASGOW REPORT No. 32144

© 2020  
W529-0214  
Lloyd's Register  
Foundation