


28-4-16.
20-5-16.


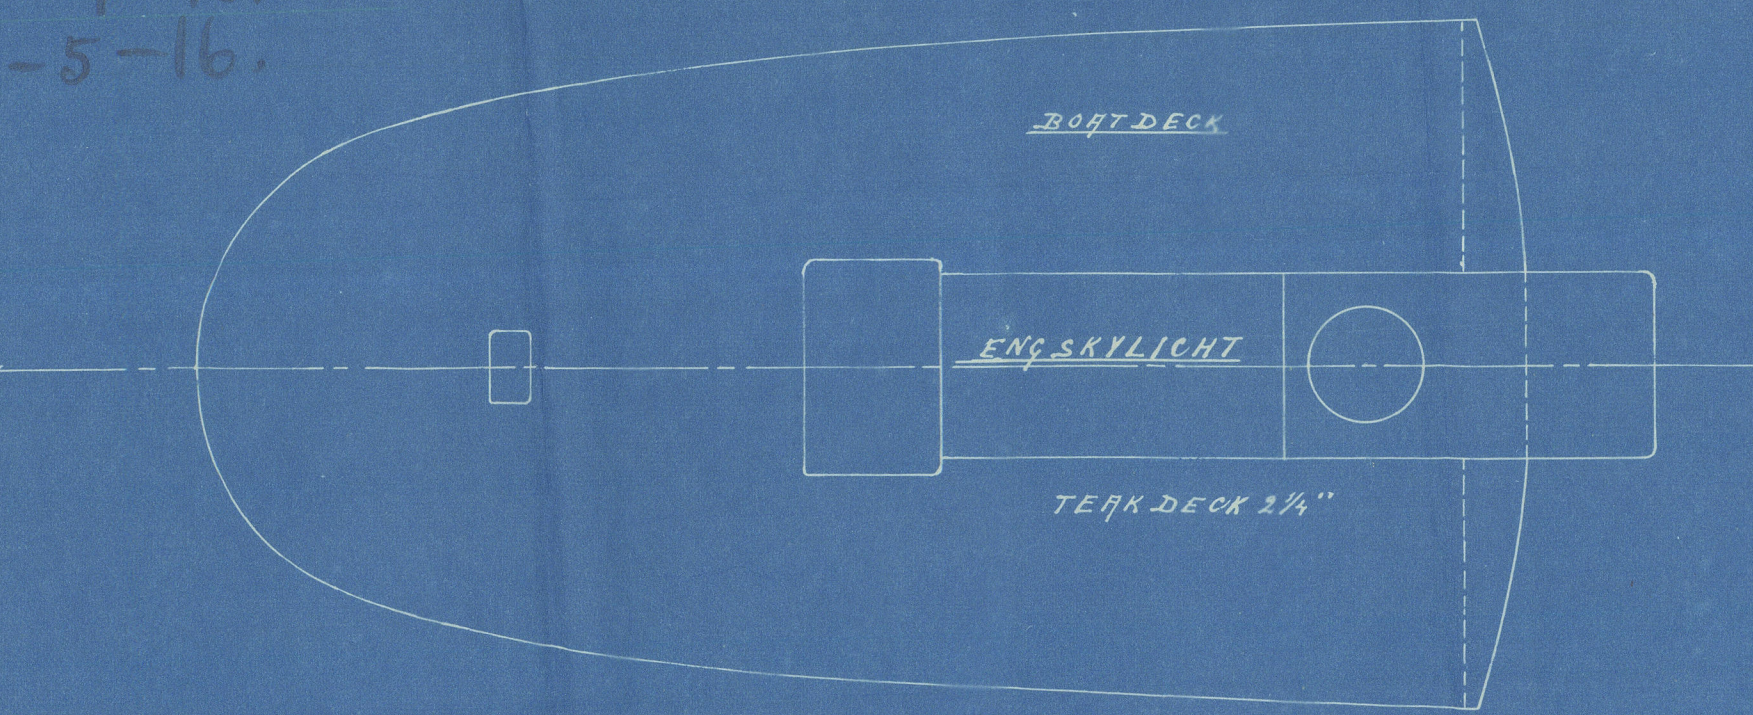


ALTERATION TWIN SCREW MOTORLIGHTER N^o 24.


180'0" x 30'0" x 13'0"

Scale 1/8" = 1'-0"


Stringers: 1 1/2" x 26"
" Angle 3" x 3" x 26"
Deck Beams: 5" x 3" x 34" = 4 1/2" x 3" x 30" = 4 1/2" x 3" x 30" at ends.
Frames in Fore Castle Angle 4 1/2" x 3" x 34"
Fore. Side Pl. 26"
Bracket 12" x 30"
Bulwark Strip 2 1/2" x 26"

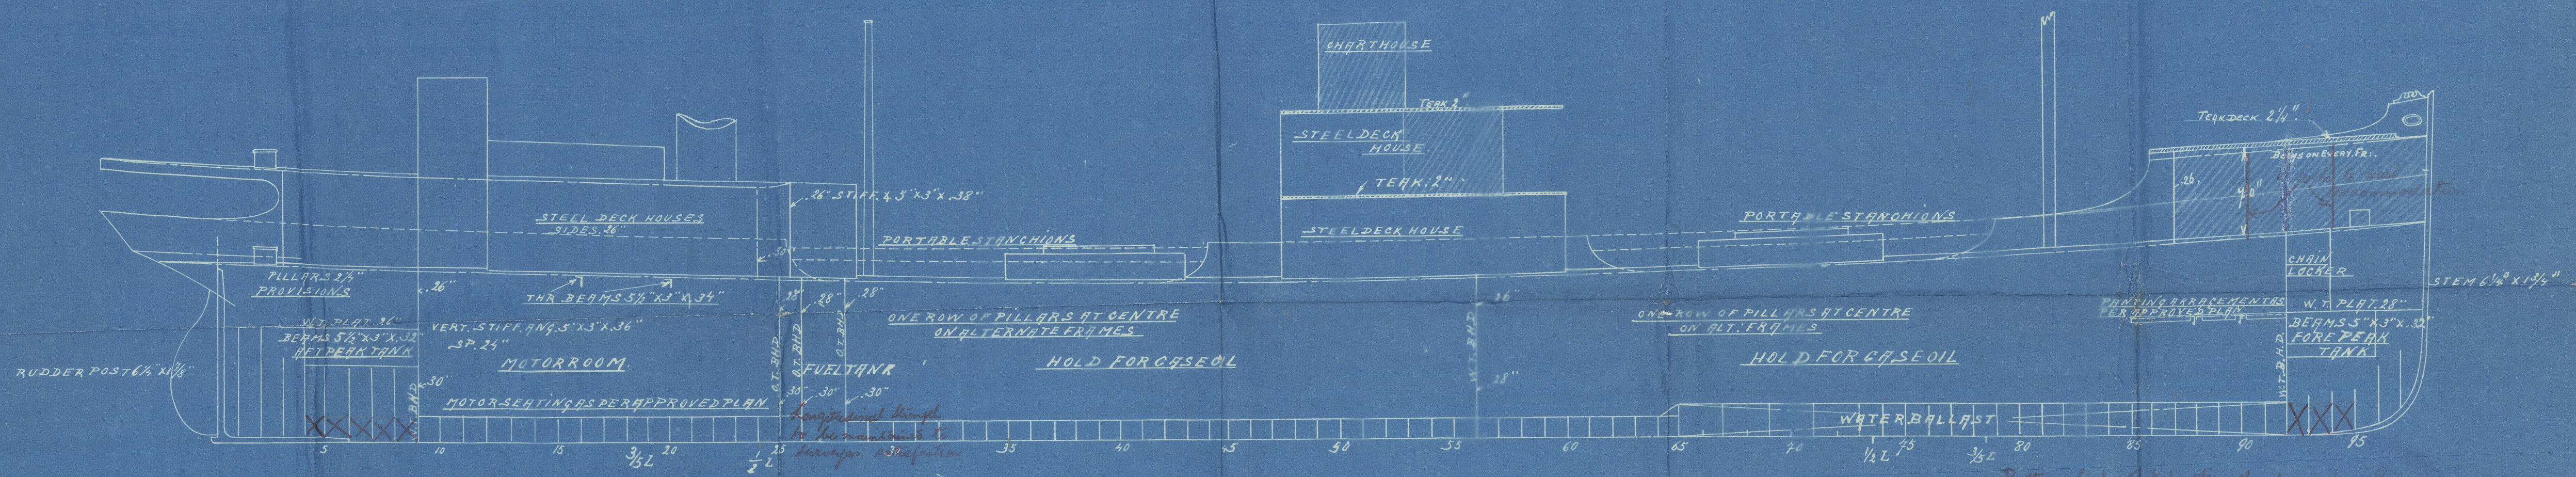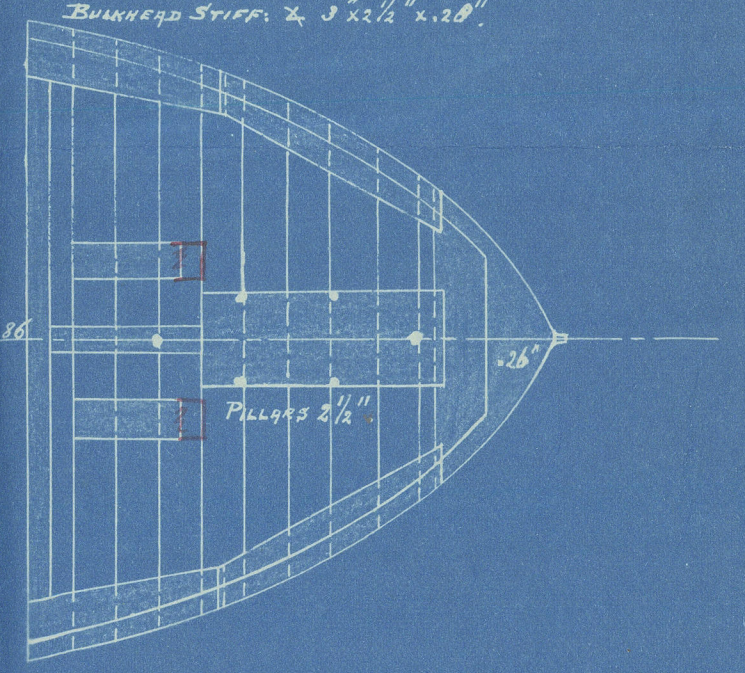


Bottom for S.L. strengthened as per Rules
Sketch to be submitted

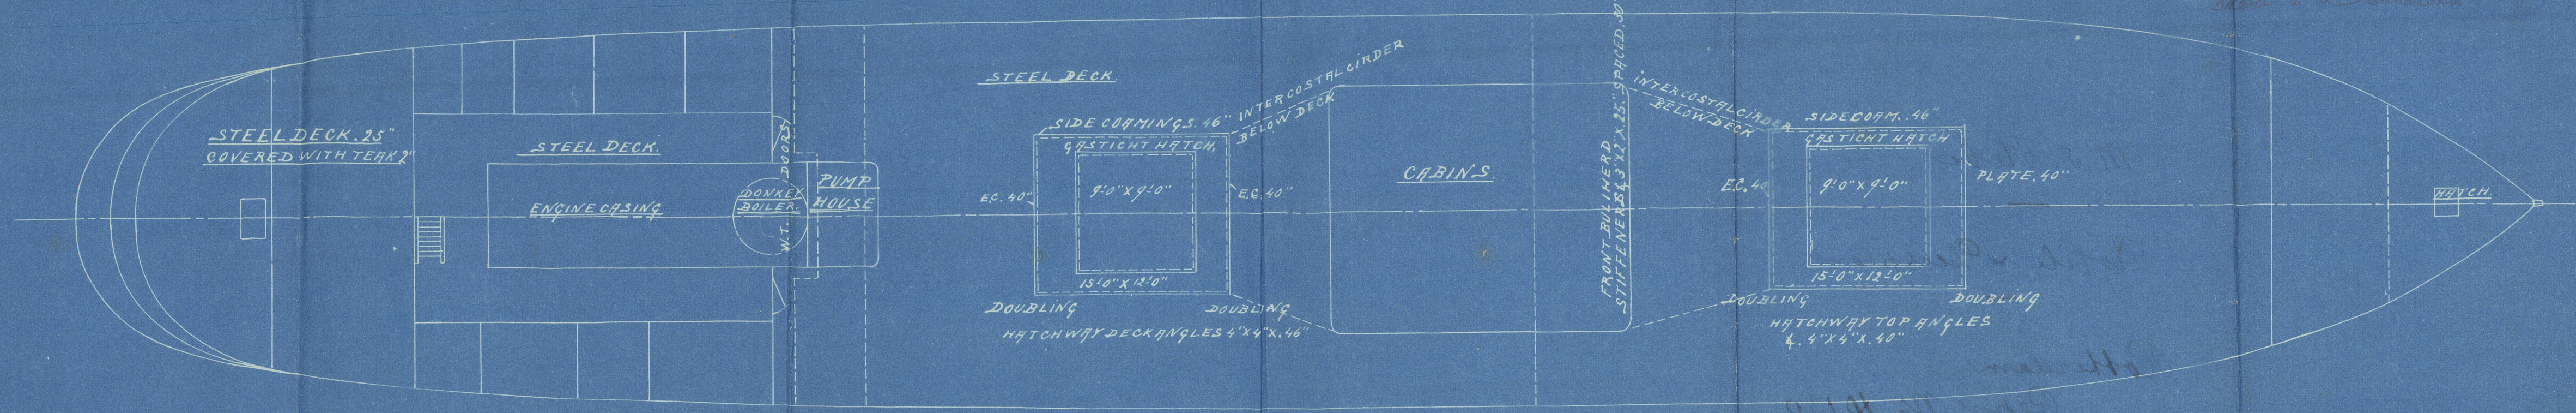

N.V. SCHEEPSWERF
"DORDRECHT"
N^o 1805
8-4-16

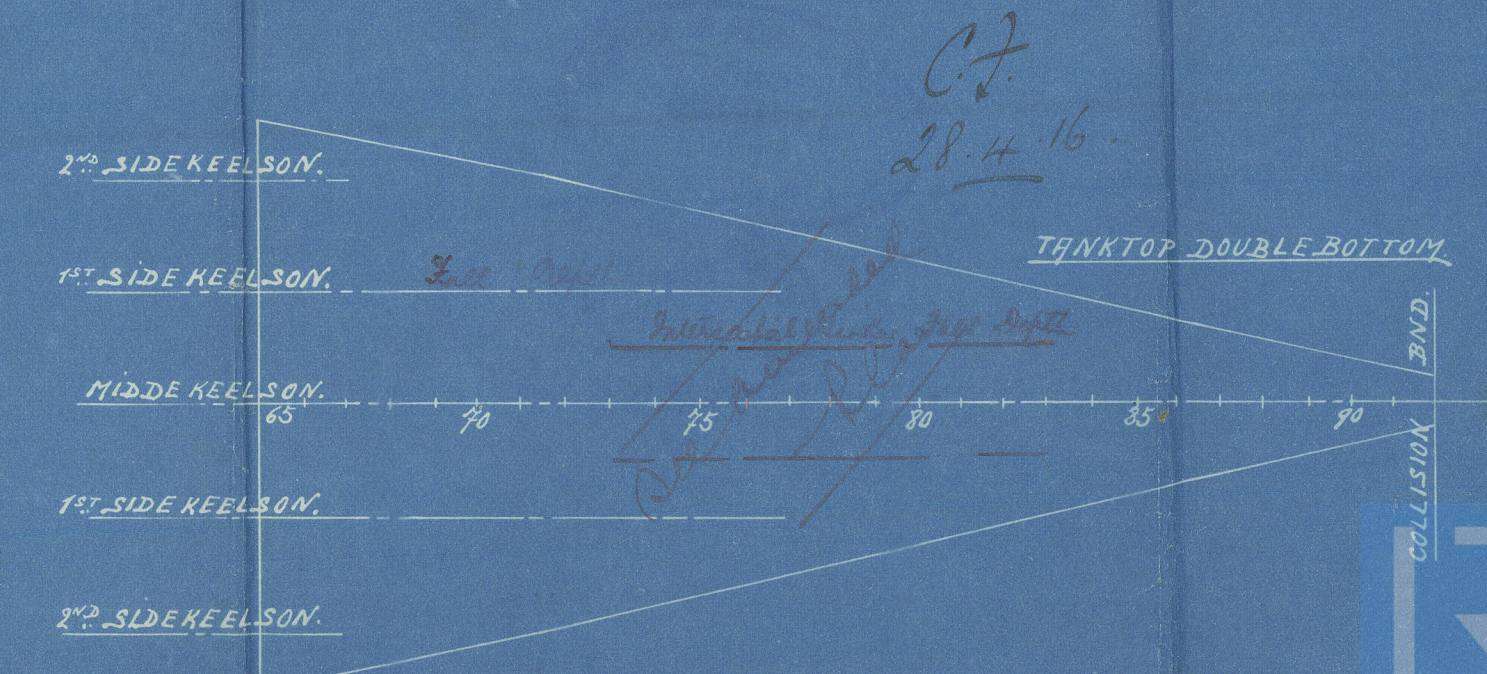

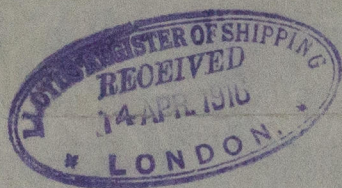


M.S. Hebe

Profile & Deckplan.

Rotterdam

Report No. 10130

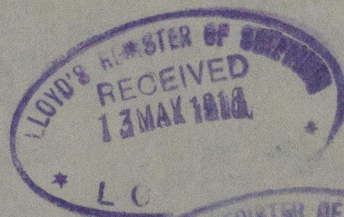

RETAIN

© 2021



Lloyd's Register
Foundation

W530-0076