


10-12-00
35-1-01

PROFILE

SCALE $\frac{1}{8}'' = 1 \text{ FOOT}$

DIMENSIONS 360' x 48' x 30'-11" D.M.

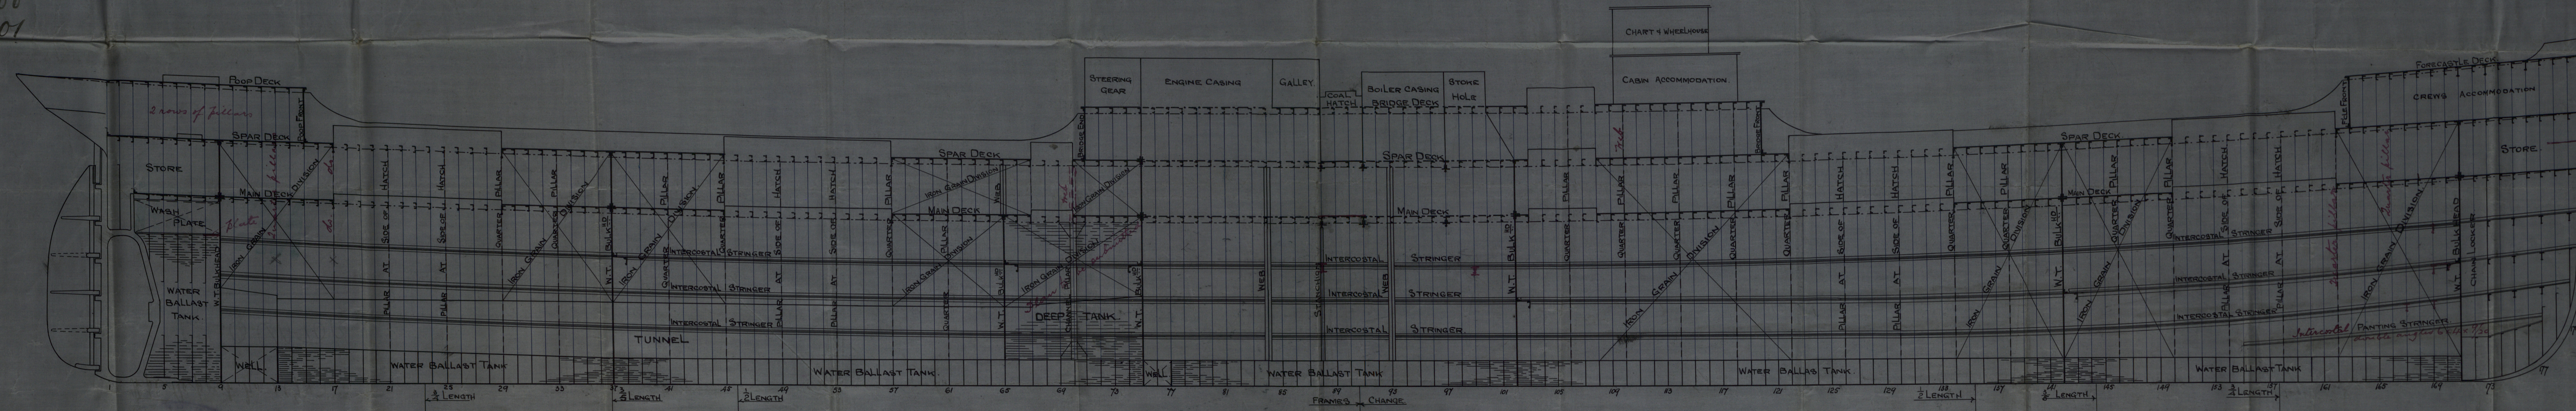

No 257-9

FURNESS, WITBY & CO. LIMITED
SHIPBUILDERS & REPAIRERS,
WEST HARTLEPOOL.

FURNESS, WITBY & CO. LIMITED
SHIPBUILDERS & ENGINEERS,
WEST HARTLEPOOL.

No 257



W531-0053
Foundation

Messrs Tunnell & Co.
No. 257-9.

Profile

No. 257 "Manchester Exchange"

Hpl. Report No. 11708

No. 259 "Manchester Market"

Hpl. Report No. 11747

EQUATOR



© 2019

Lloyd's Register
Foundation