
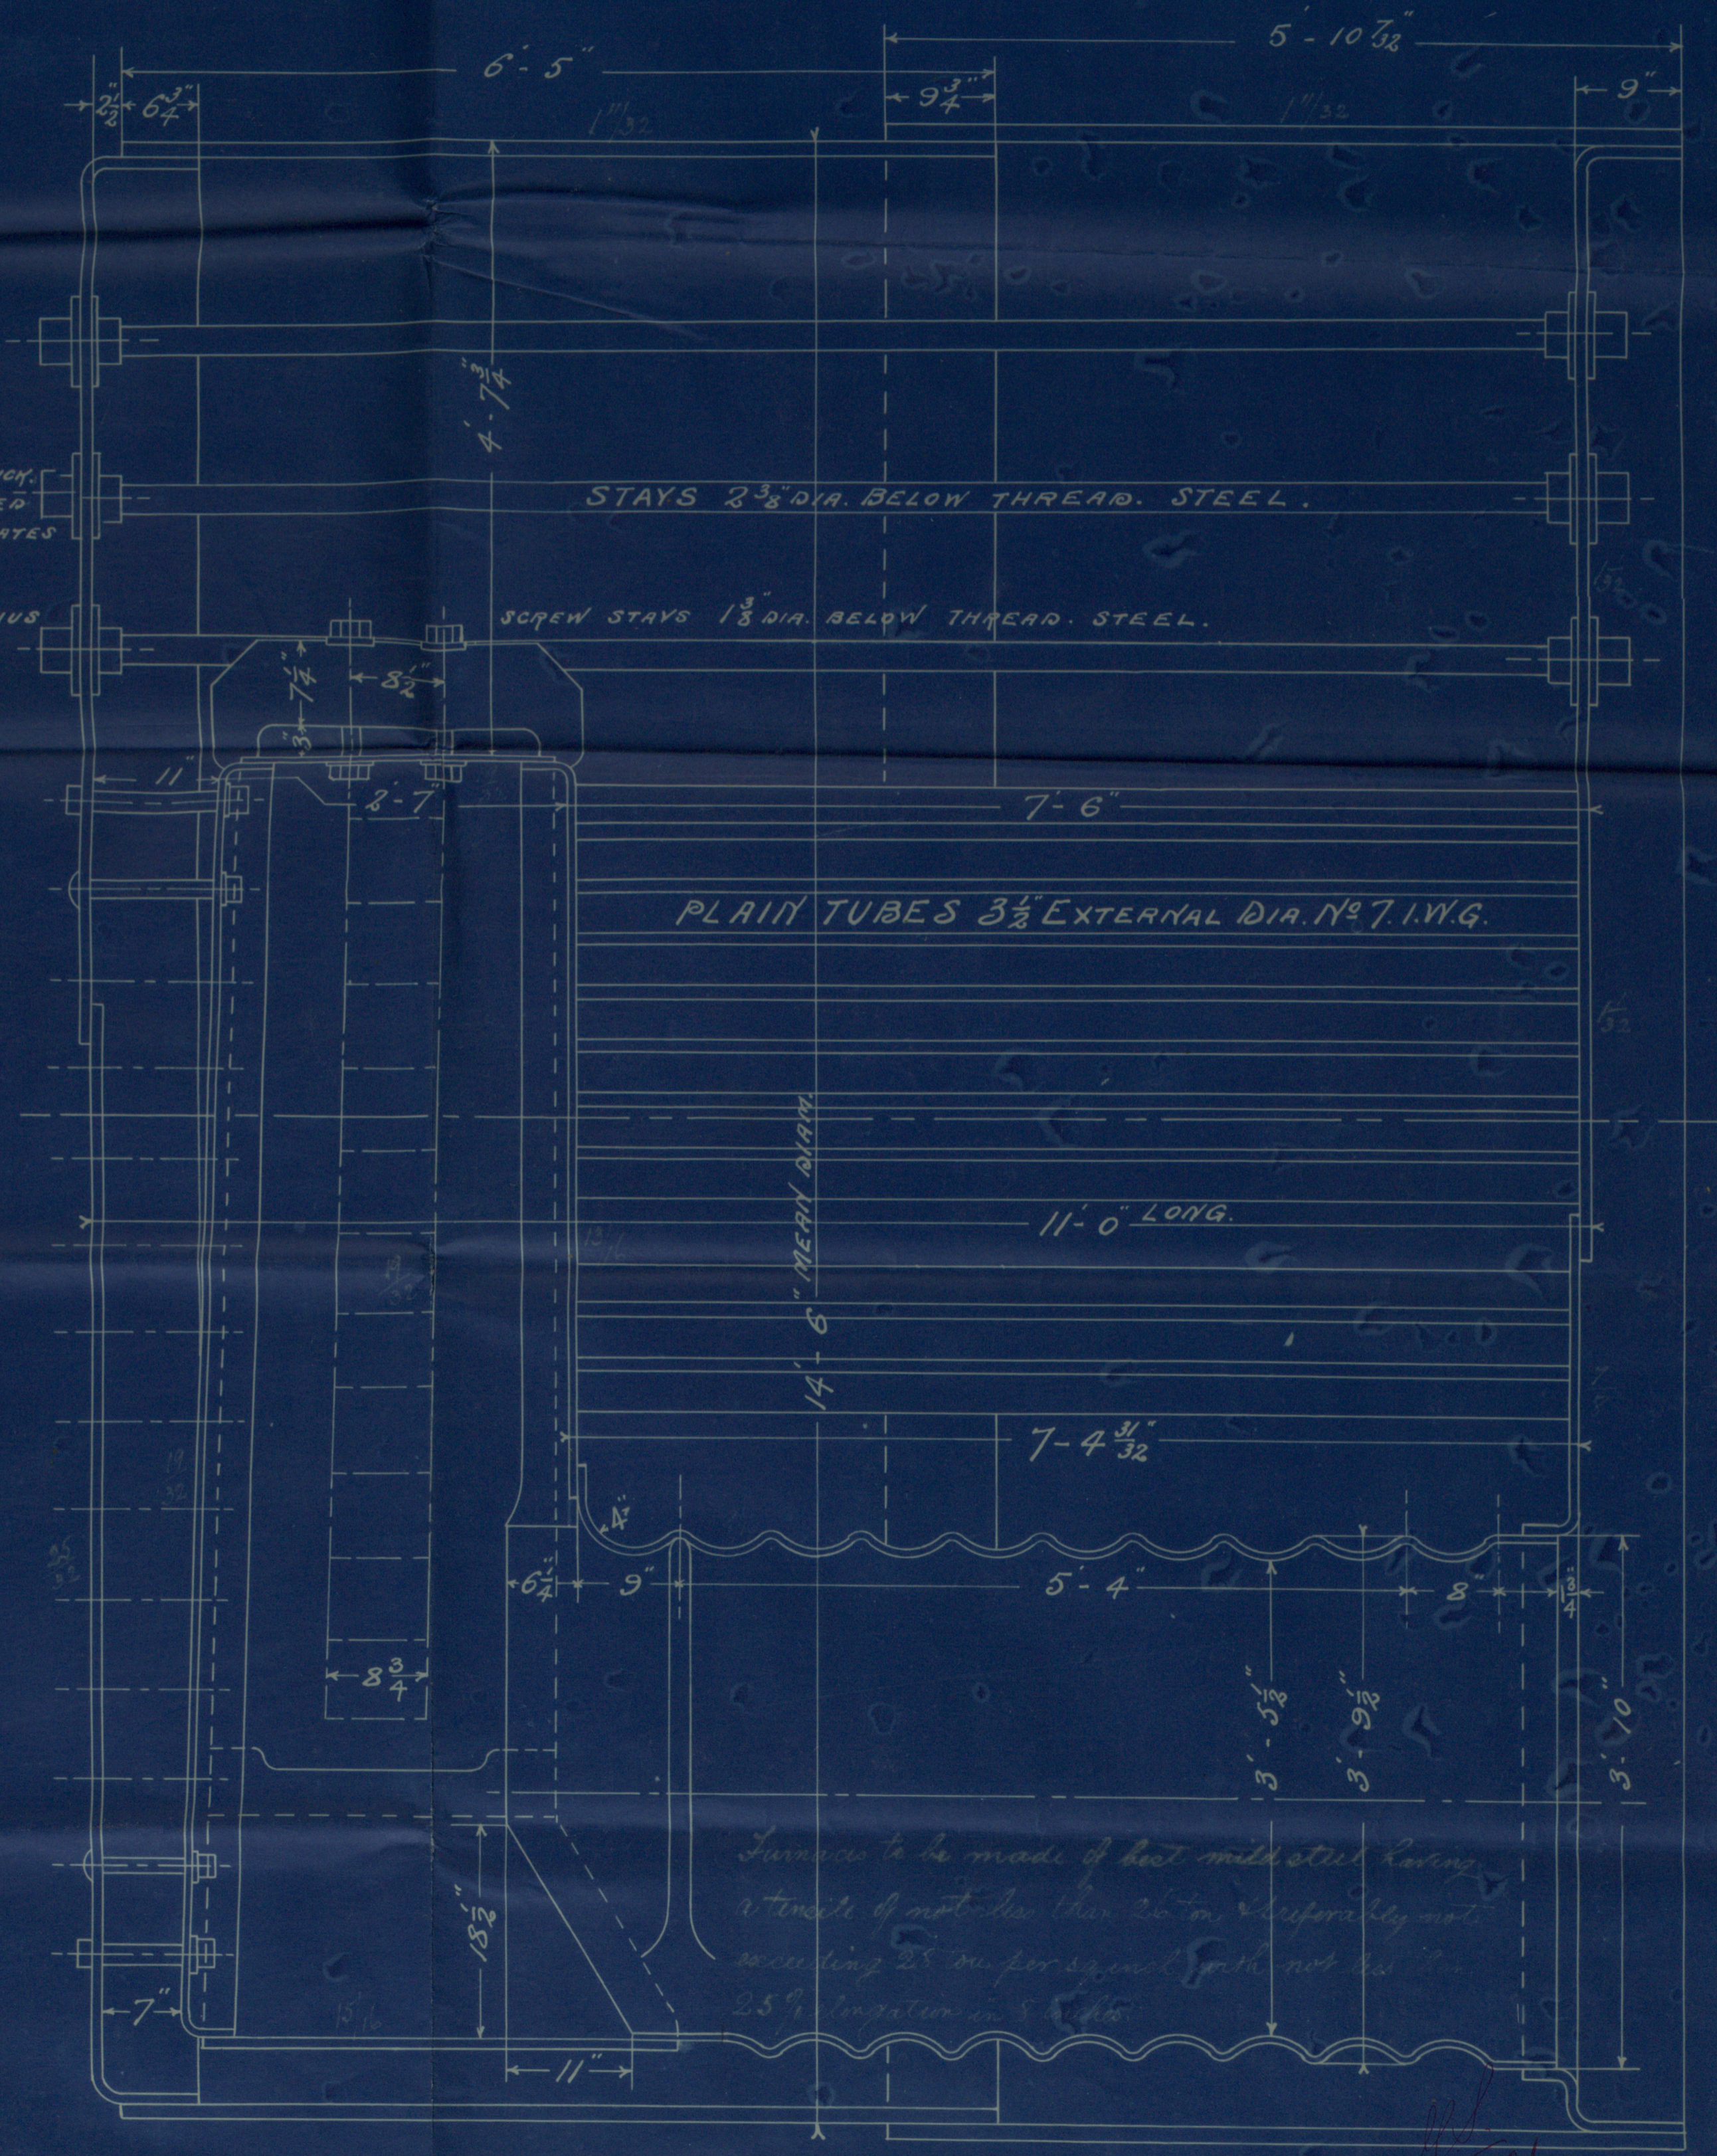
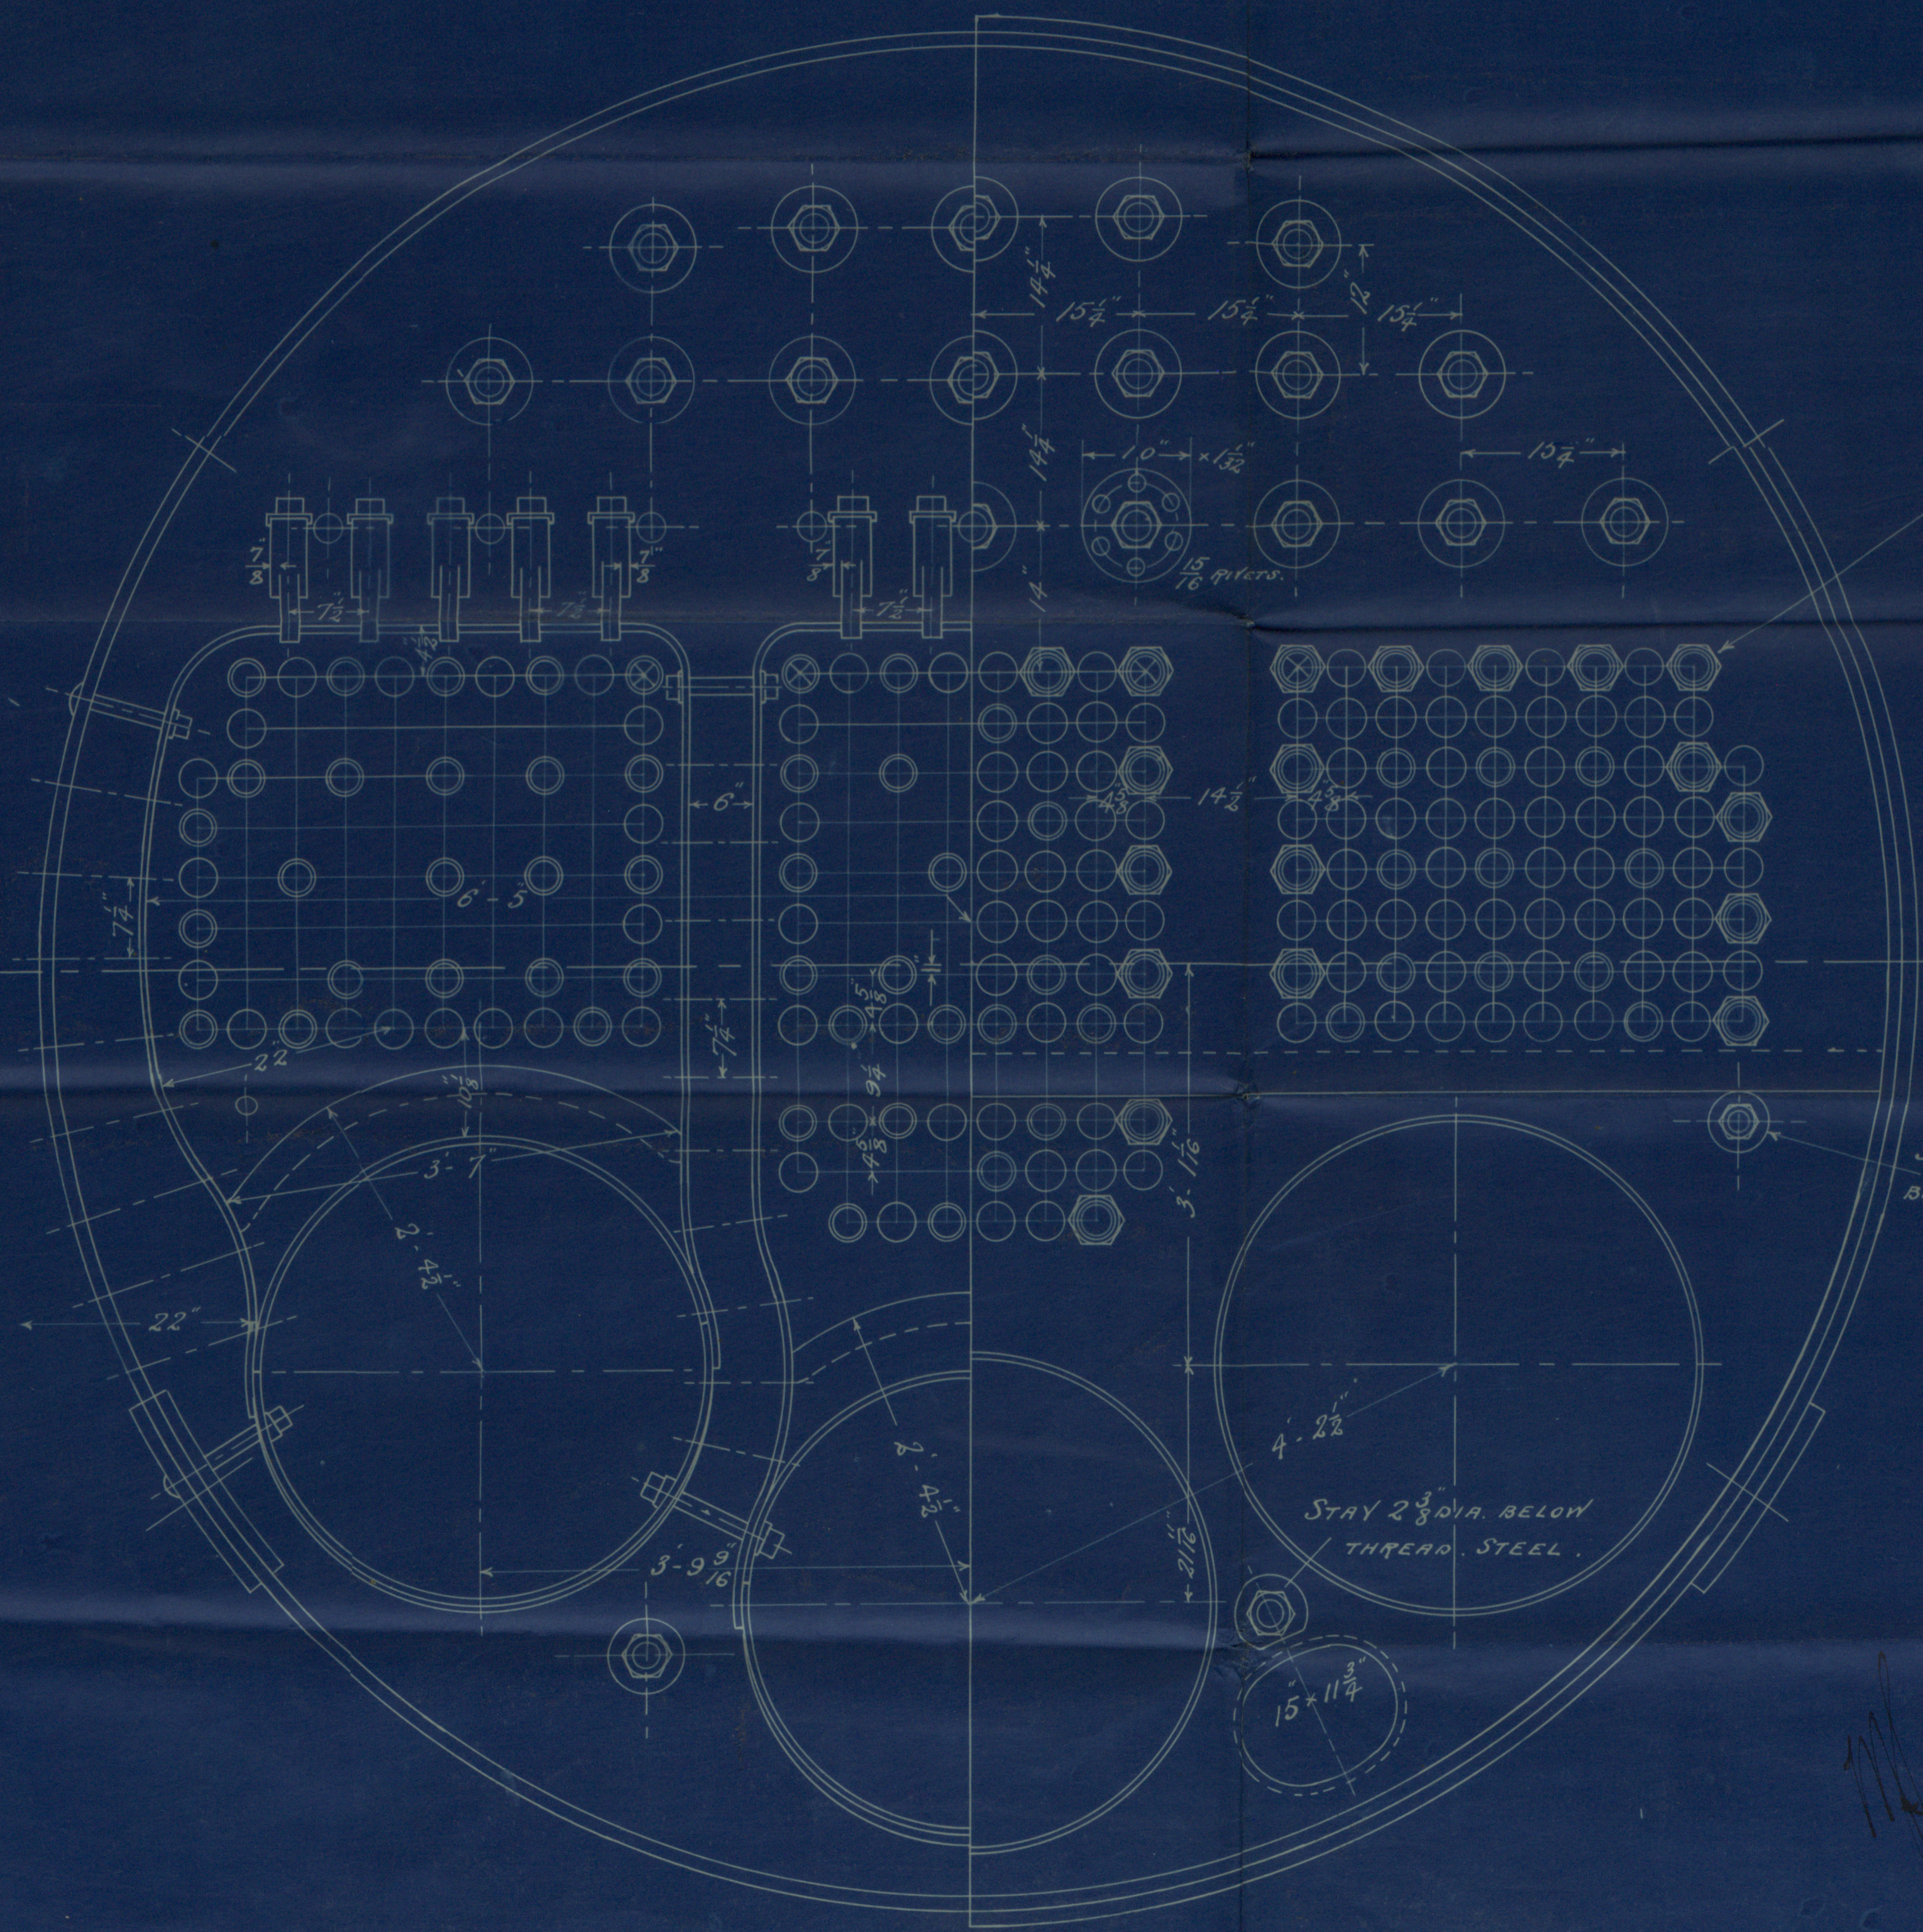
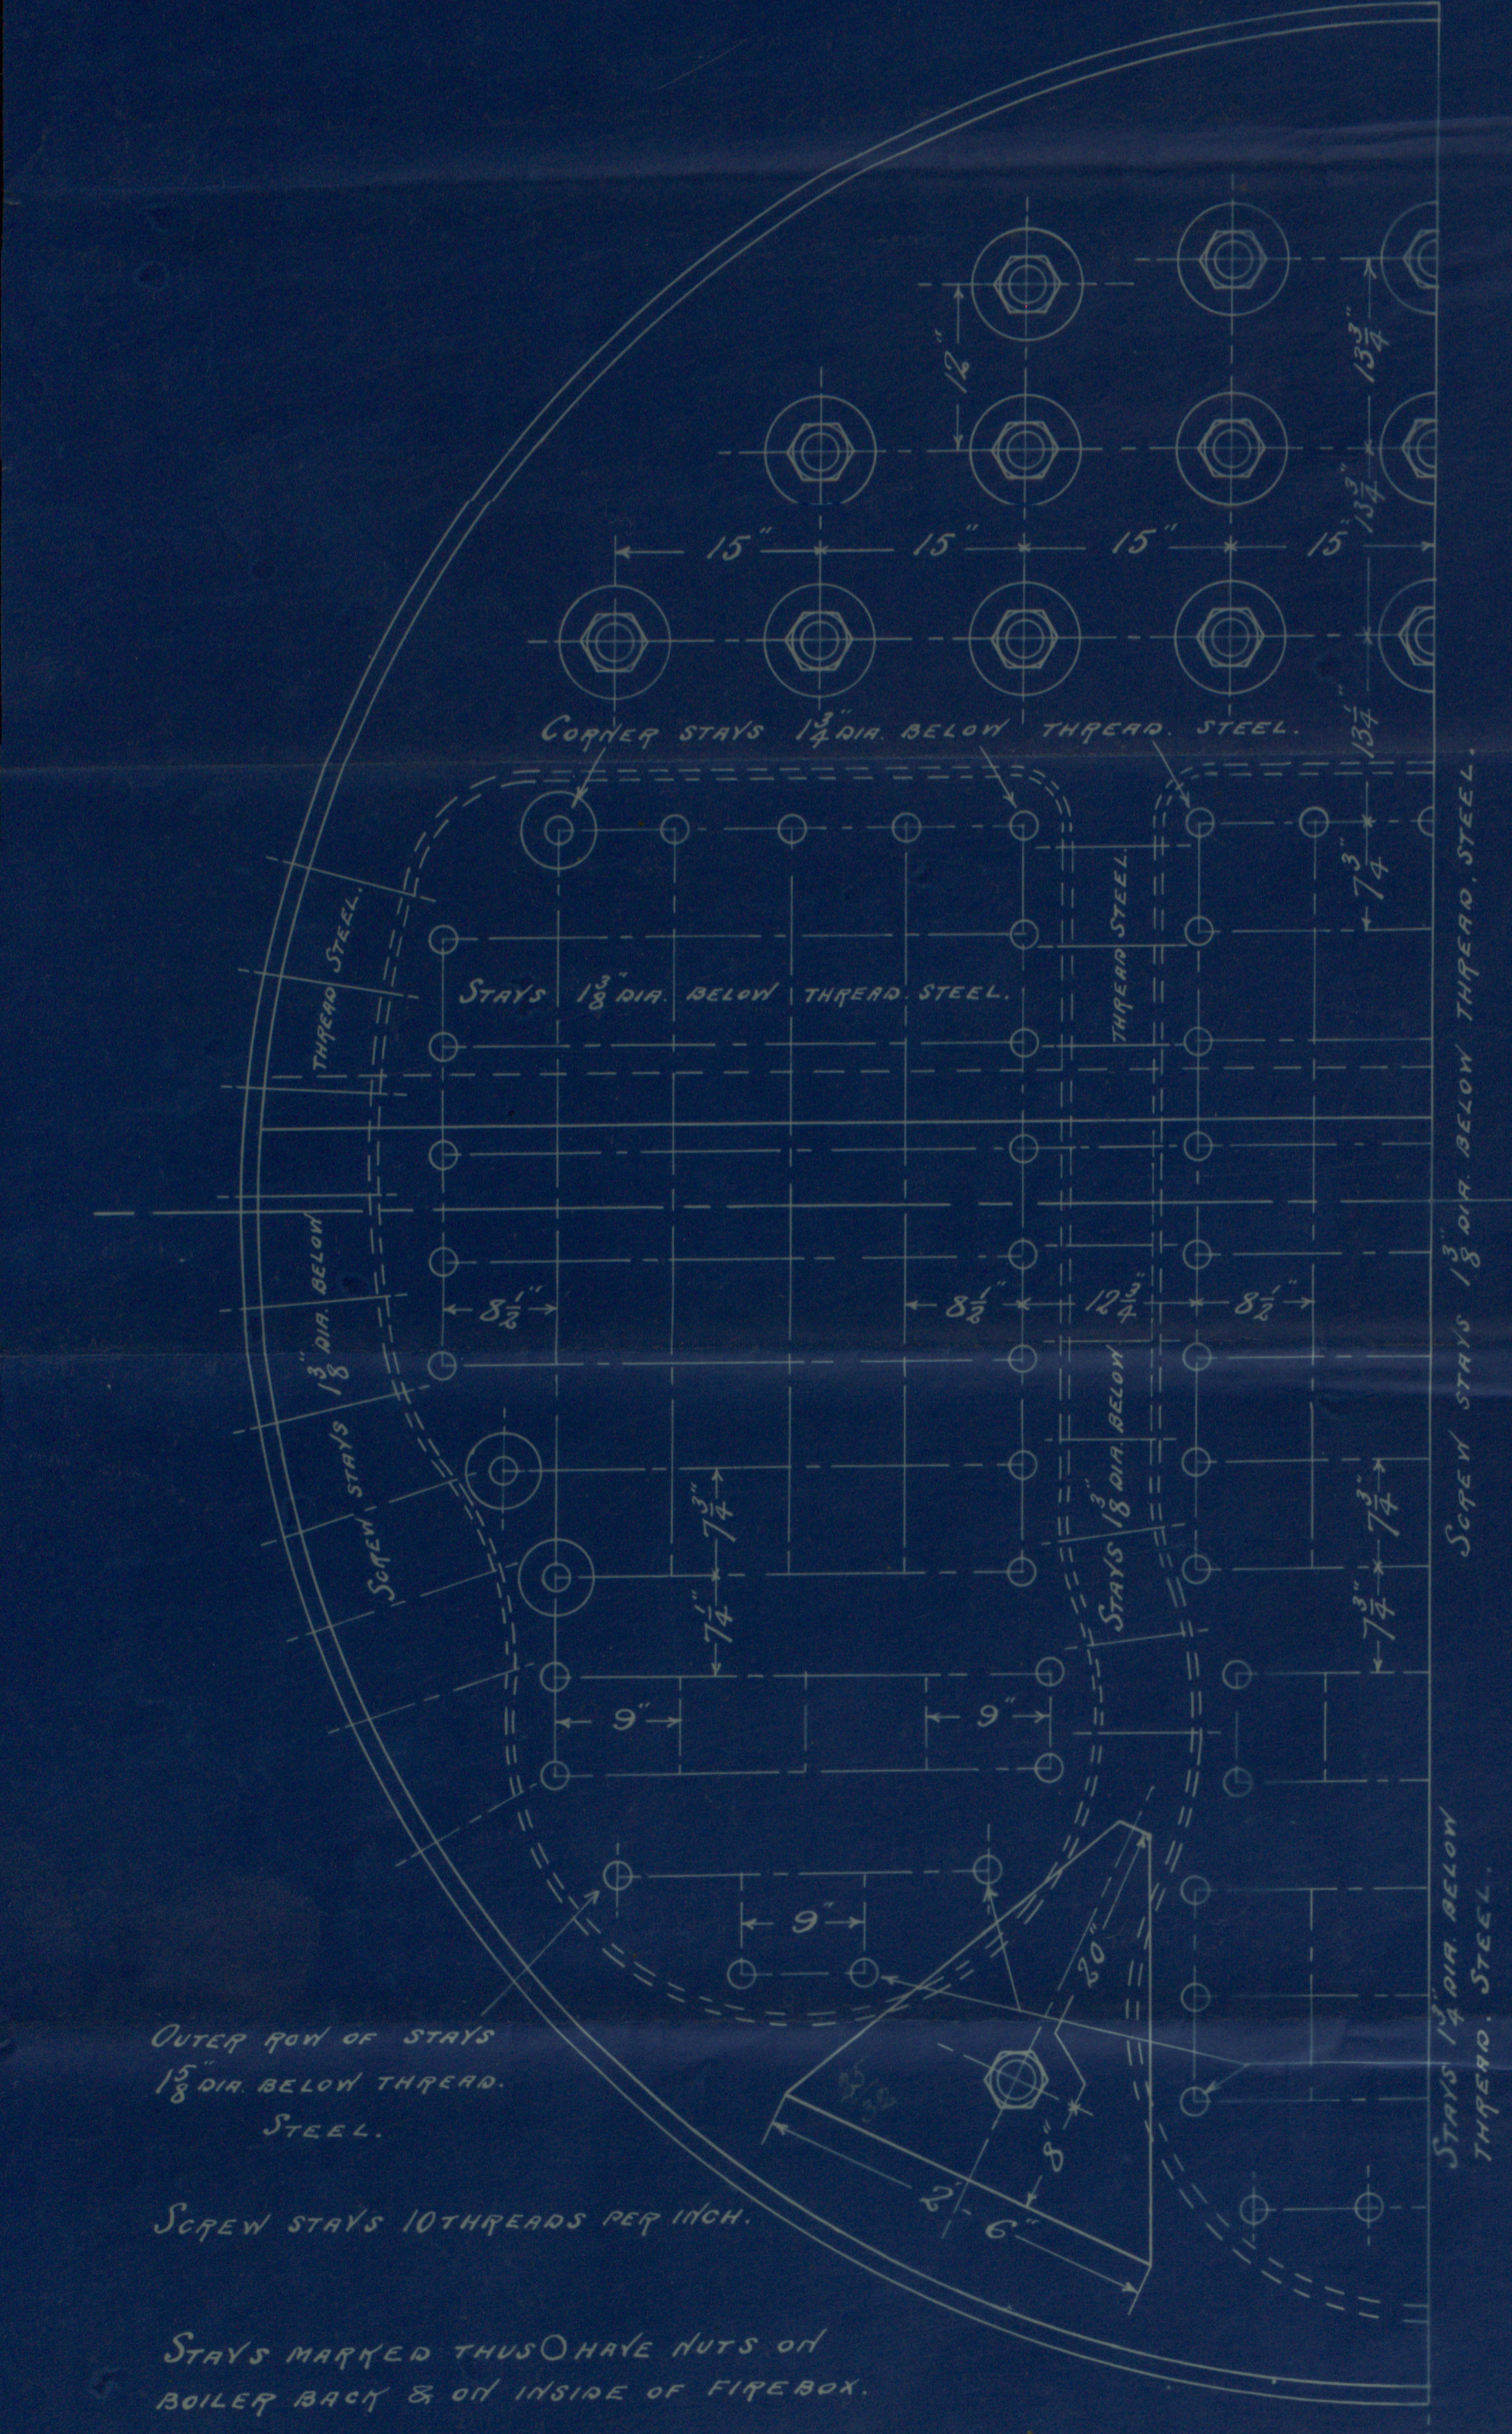


BOILERS No 1122-3.

TO BE FITTED TO MESSRS. FURNESS, WITBY & CO'S S.S. Nos. 257 AND 259.
TO PASS LLOYDS AND B.O.T. SURVEYS FOR A WORKING PRESS. OF 180 LBS. PER SQ. INCH.

RICHARDSONS, WESTGATH & CO. LIMITED, DRAWING OFFICE, HARTLEPOOL.	
NO. OF DRAWING	B 1122
NO. OF TRADING	12333
WHERE SENT	Lloyds
EXAMINED BY	R. S. S.
DATE	30th Jan 1901.

Minimum tensile of shell = 28 tons per sq. inch.
Main stays

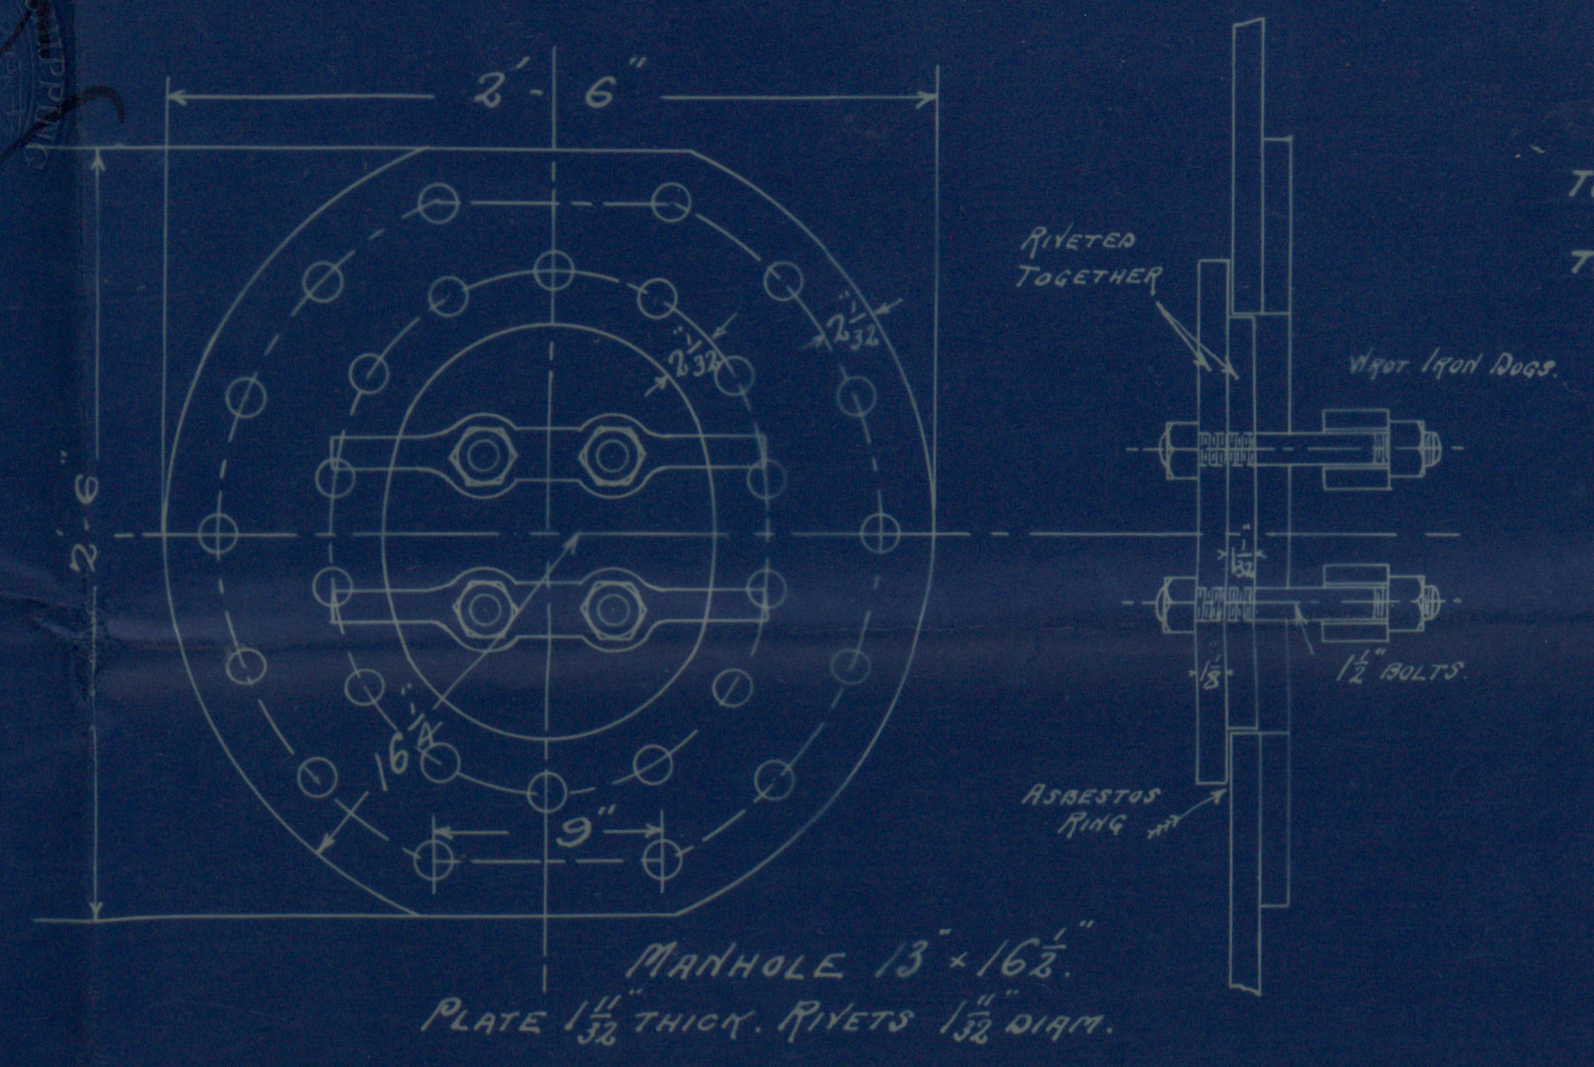


Stays to be made of best mild steel having a tensile of not less than 28 tons, preferably not exceeding 28 tons per sq. inch with not less than 35% elongation in 5 ft. length.

Main Boilers

Furness Withy & Co
254 + 259 Vessels.

Richardson Westgarth & Co.
(Harlepool)

No. 1122 + 1123

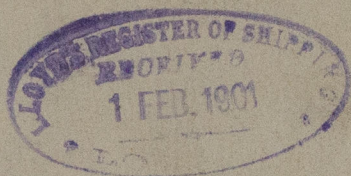

1122

No. 2821

Lloyds List

360 lbs.

W.S. 21.8.01

No. 257 "Manchester Exchange"

Hpl. Report No. 11708

No. 259 "Manchester Market"

Hpl. Report No. 11747

Lloyd's Register

W531-0054 Foundation