

23.1.12
4.2.12
12.2.12
5.3.12
9.4.12
30.4.12
1.6.12
3.7.12
6.7.12
15.7.12
23.7.12

ALTERATIONS IN BLUE ARE FOR S.S. N° 202


PROFILE AND DECK PLANS

S.S. N° 200-2

DIMENSIONS 540' 0" BP x 51' 8" MD x 30' 6" LD.


Scale 1/8" = 1' 0"

SHELTER DECK VESSEL.

 




SHELTER DECK.

 

UPPER DECK.

 

2ND DECK.

 






Northumberland
Shipbuilding Co., Ltd.
Howdon-on-Tyne.
DRAWING OFFICE.
Date: 11/11/12
No. 101

8
T.O. 30.
8 JAN 1912.

Handwritten signature and date: *C.B.*
23.1.12.







Northumberland S. B. Co. Ltd.
No 20042

Profile & Deck Plans

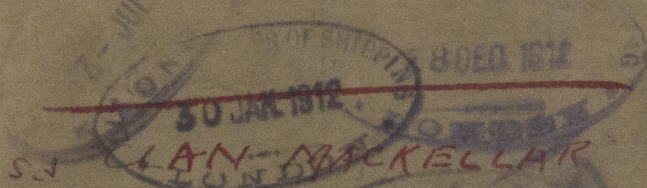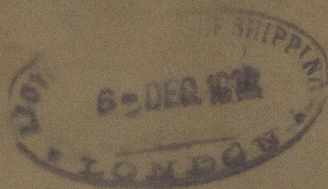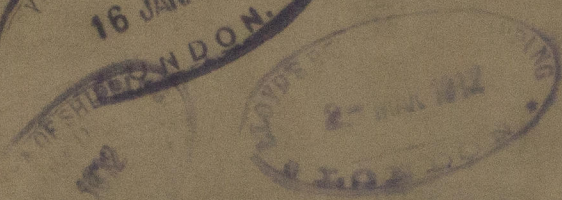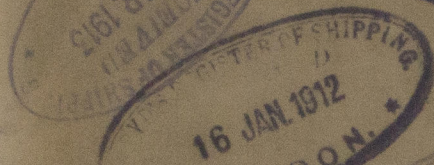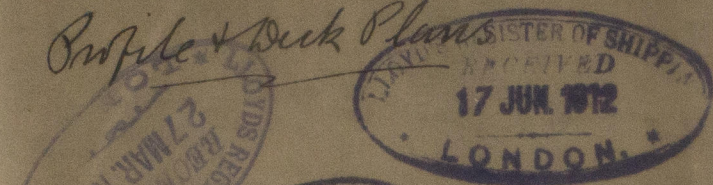

NEWCASTLE-ON-TYNE

Report No 63462

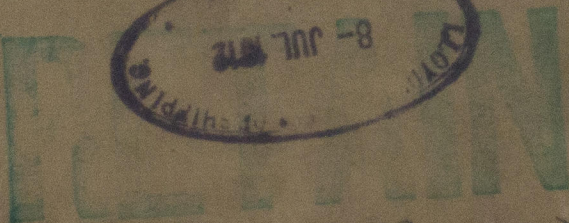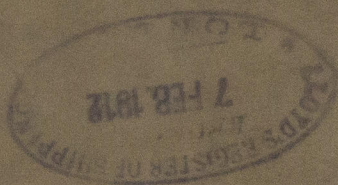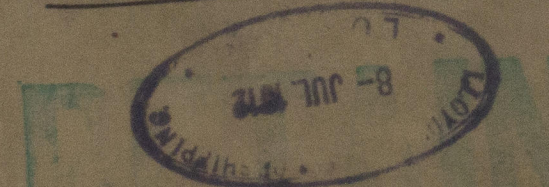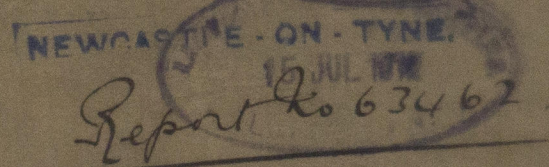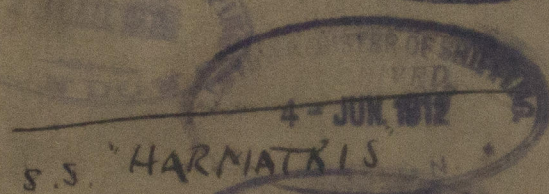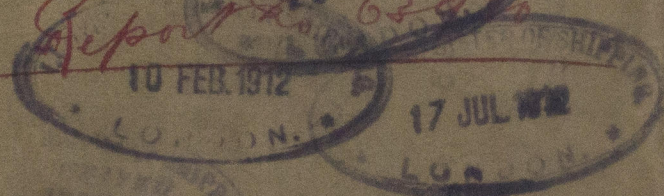

W531-0240



© 2019

Lloyd's Register
Foundation