


Lt. 298. 122
 Lloyd's
 Main Deck

Main Deck Plating No 298
 Scale 1/4" = 1 ft.

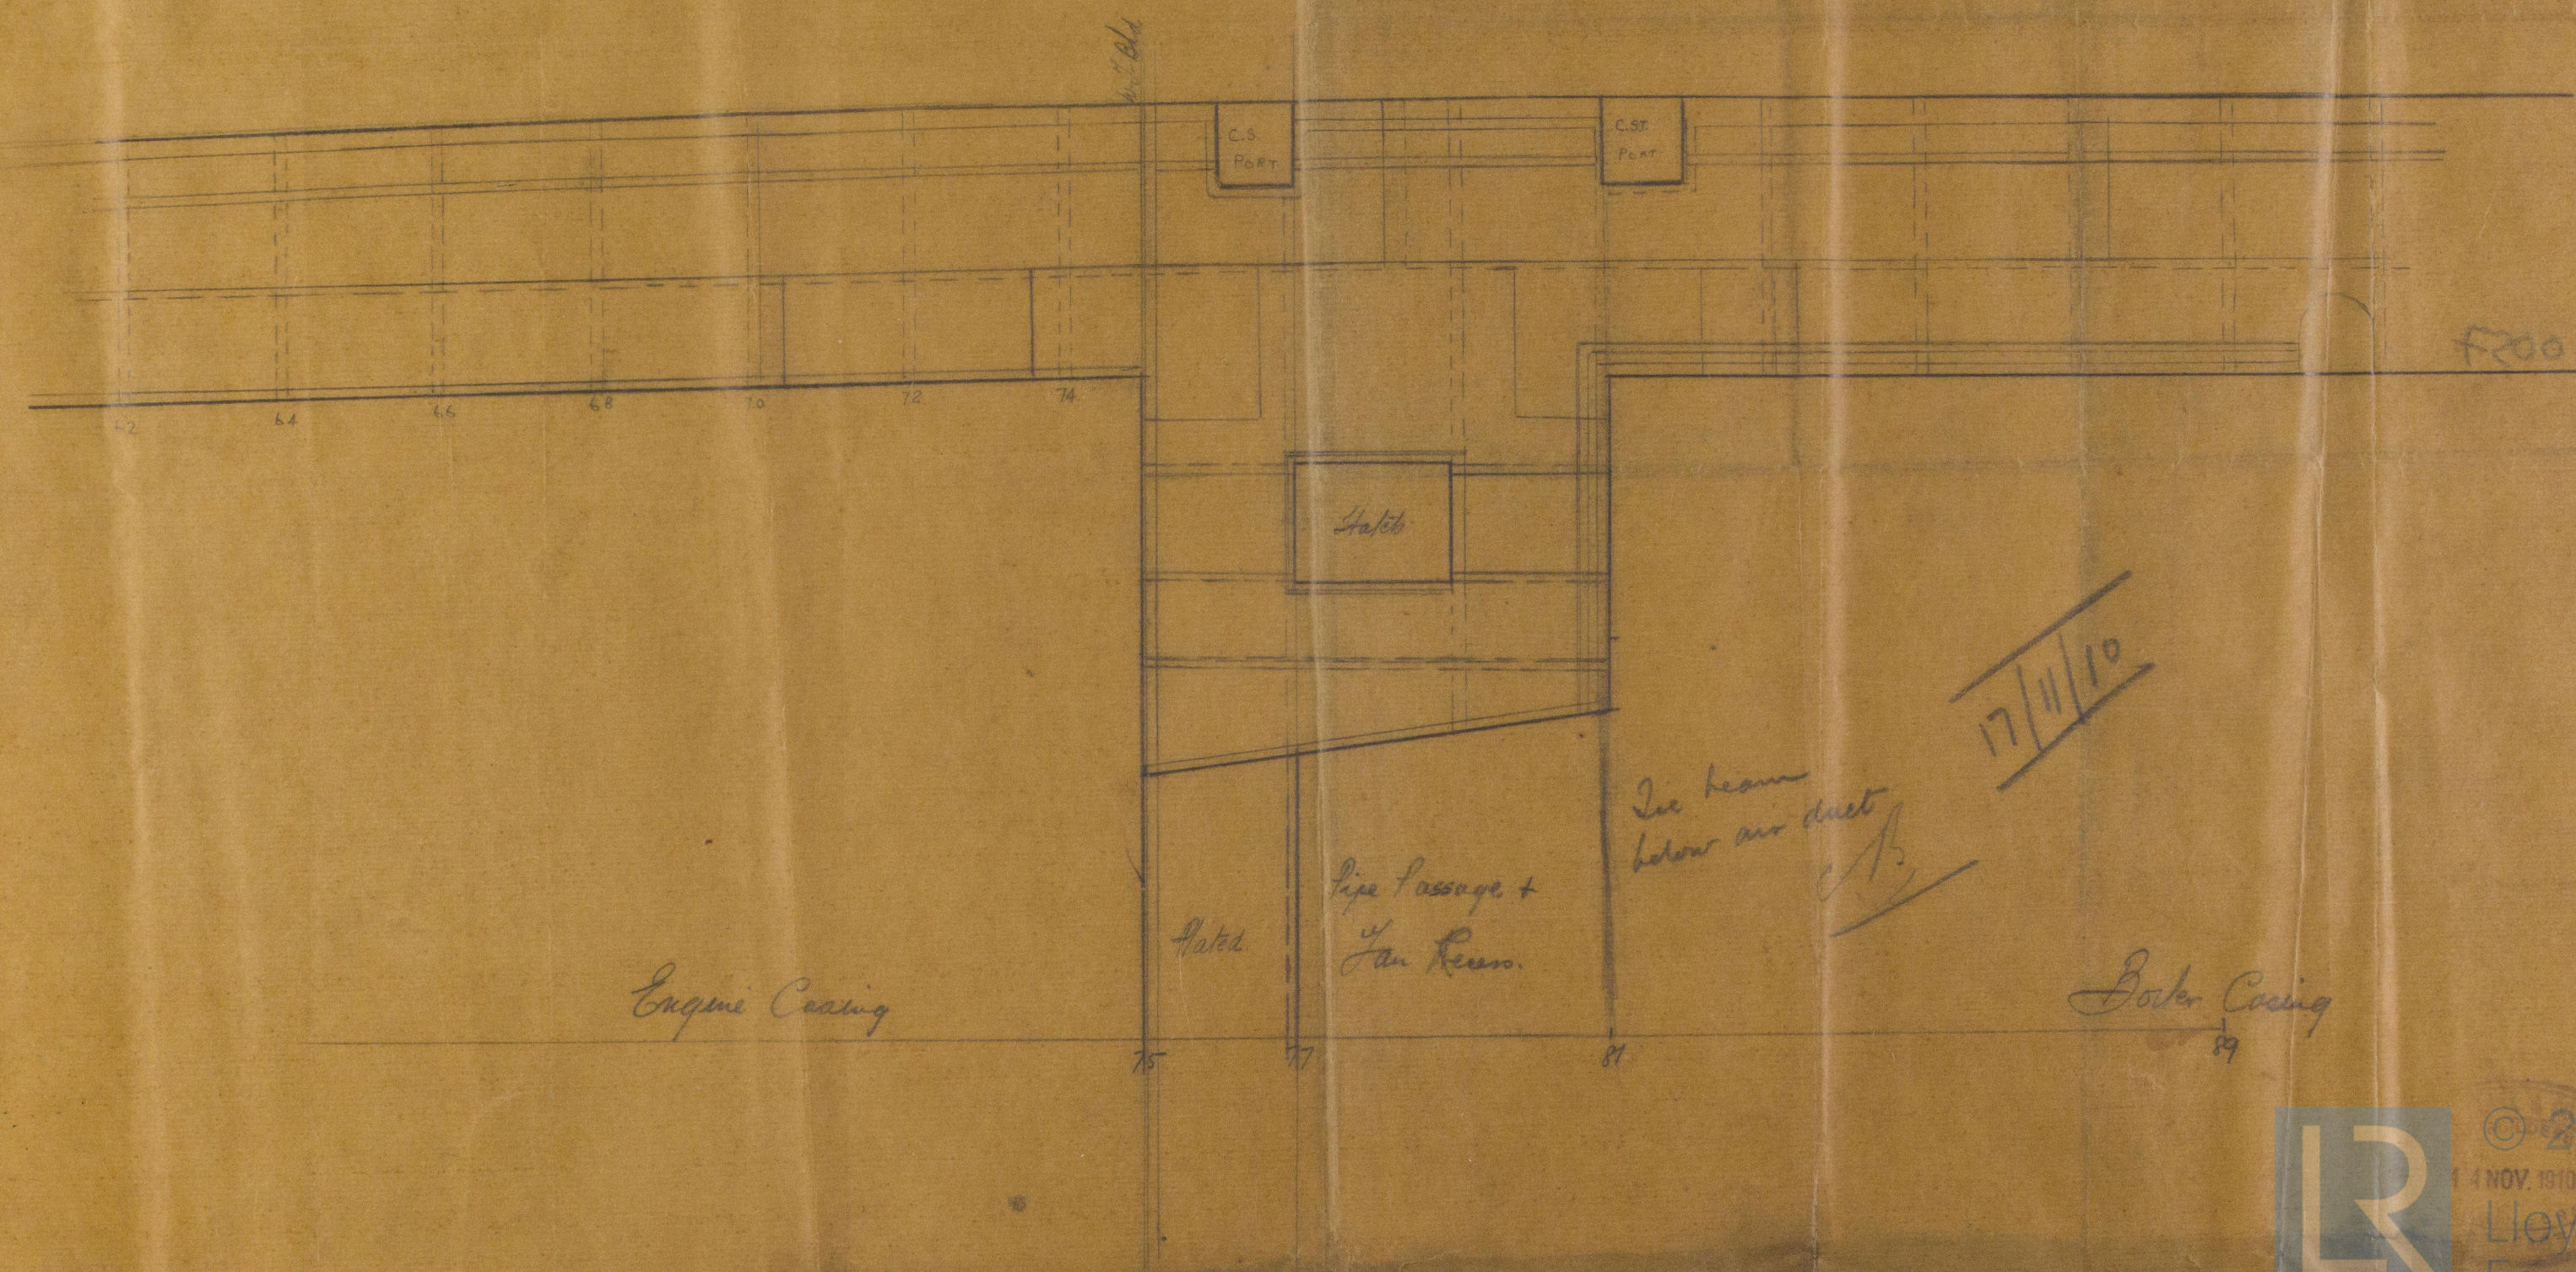

200-18241

17/11/10

LS00-0057

17^o. 298. TSS

Lloyds.

Main Deck.

WS32-0057

M235-0027

R

© 2019

0101 VOM 1 3

Lloyd's Register
Foundation