

Lloyd's Register of Shipping.

(Report on Vessel No. _____ Port _____)

No. 2745 SHIP FORGINGS ~~OR CASTINGS~~.

I have to report that the undermentioned Iron ~~or Steel~~ Forgings or Castings, manufactured by Jarmichael & Co. Ltd. of Lundu for the Vessel No. 124, being built by Carr & Sonsville Ltd of Leith, have been inspected by me as set forth below and found to be, so far as can be seen, Satisfactory

THE WORDS FORGINGS OR CASTINGS, IRON OR STEEL, SHOULD BE STRUCK OUT AS MAY BE REQUIRED.


Mark on Forgings or Castings.

Lloyd's
No. 613
J.H.M.

John H. Mackie
Lundu.

	STERN FRAME.	RUDDER FRAME.	STEM.
Material* ...	<u>Scrap Iron</u>		
How made ...	<u>Forged</u>		
Dimensions ...	<u>5 1/4 x 5 1/2 x 3"</u>		
Progress on Inspection ...	<u>Forge to finish.</u>		
Date when Inspected	<u>10/2/20 to 29/3/20</u>		
CASTINGS.			
Tests on Standard Test Pieces.			
Tensile Test—			
Tons per square inch ...			
Extension per cent. ...			
Cold Bending Test—			
Angle before fracture ...			
Drop Test—			
Height from ground ...			
Hammering Test—			
If made according to Rules and found satisfactory ...			

SKETCHES OF FRAMES SHOWING POSITION AND DESCRIPTION OF WELDS OF FORGINGS.

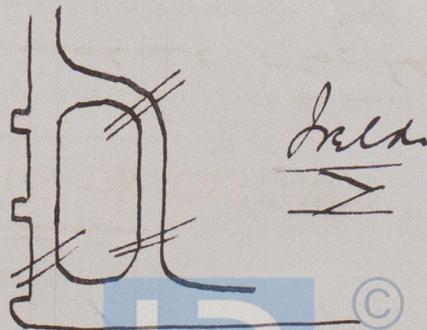

Fee (if any chargeable) £
 To be paid at _____

© 2019

Lloyd's Register Foundation

* If of Iron, state whether scrap or puddled Iron. If of steel, state whether made on the Open Hearth process.