


N<sup>o</sup> 606  
YARD PROFILE  
SCALE  $\frac{1}{8} = 1$  FT

DIMENSIONS  
LENGTH B.P. 319'-6"  
BREADTH MLD 45'-9"  
DEPTH MLD 23'-9"

BEAM KINGS					
SIZE OF BEAM	SIZE OF ANGLE	NUMBER RIVETS	POSITION	SIZE OF ANGLE	NUMBER RIVETS
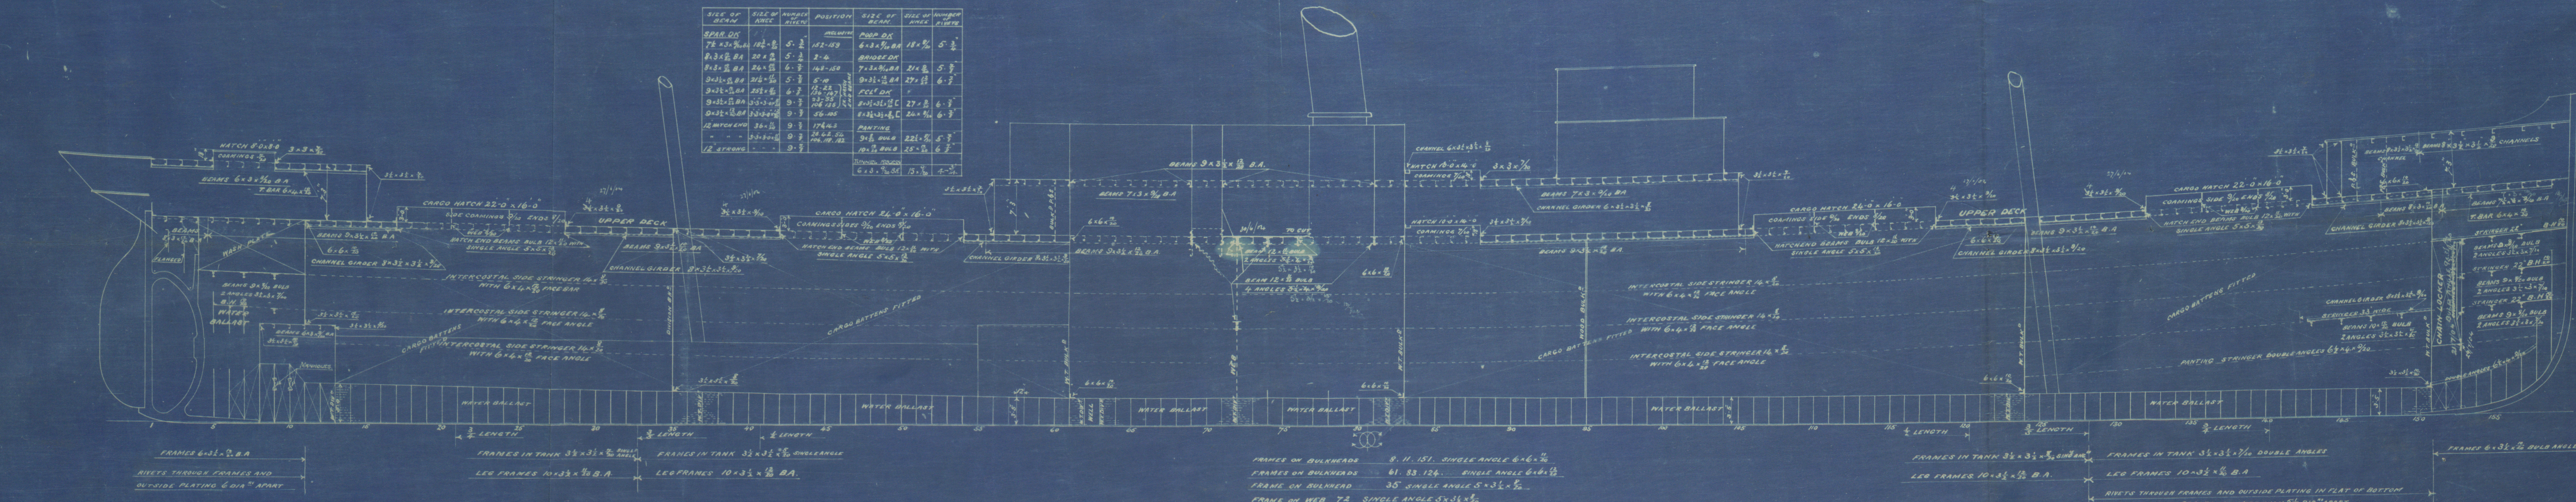



"DUNKELD"

Sn. J. Lang & Sons N° 606

Profile as built

Sld 22253.



© 2019

Lloyd's Register  
Foundation

W533-0026