


Proposed $\text{C.D. } 319.6 \times 45.9 \times 23.9$

<u>Humeral</u>	<u>Single Deck</u>	90.99	<u>Three Deck</u>	83.99
		28904		26680

PROPOSAL	23.
PLAN	L.2.A.
DATE	12-5-04

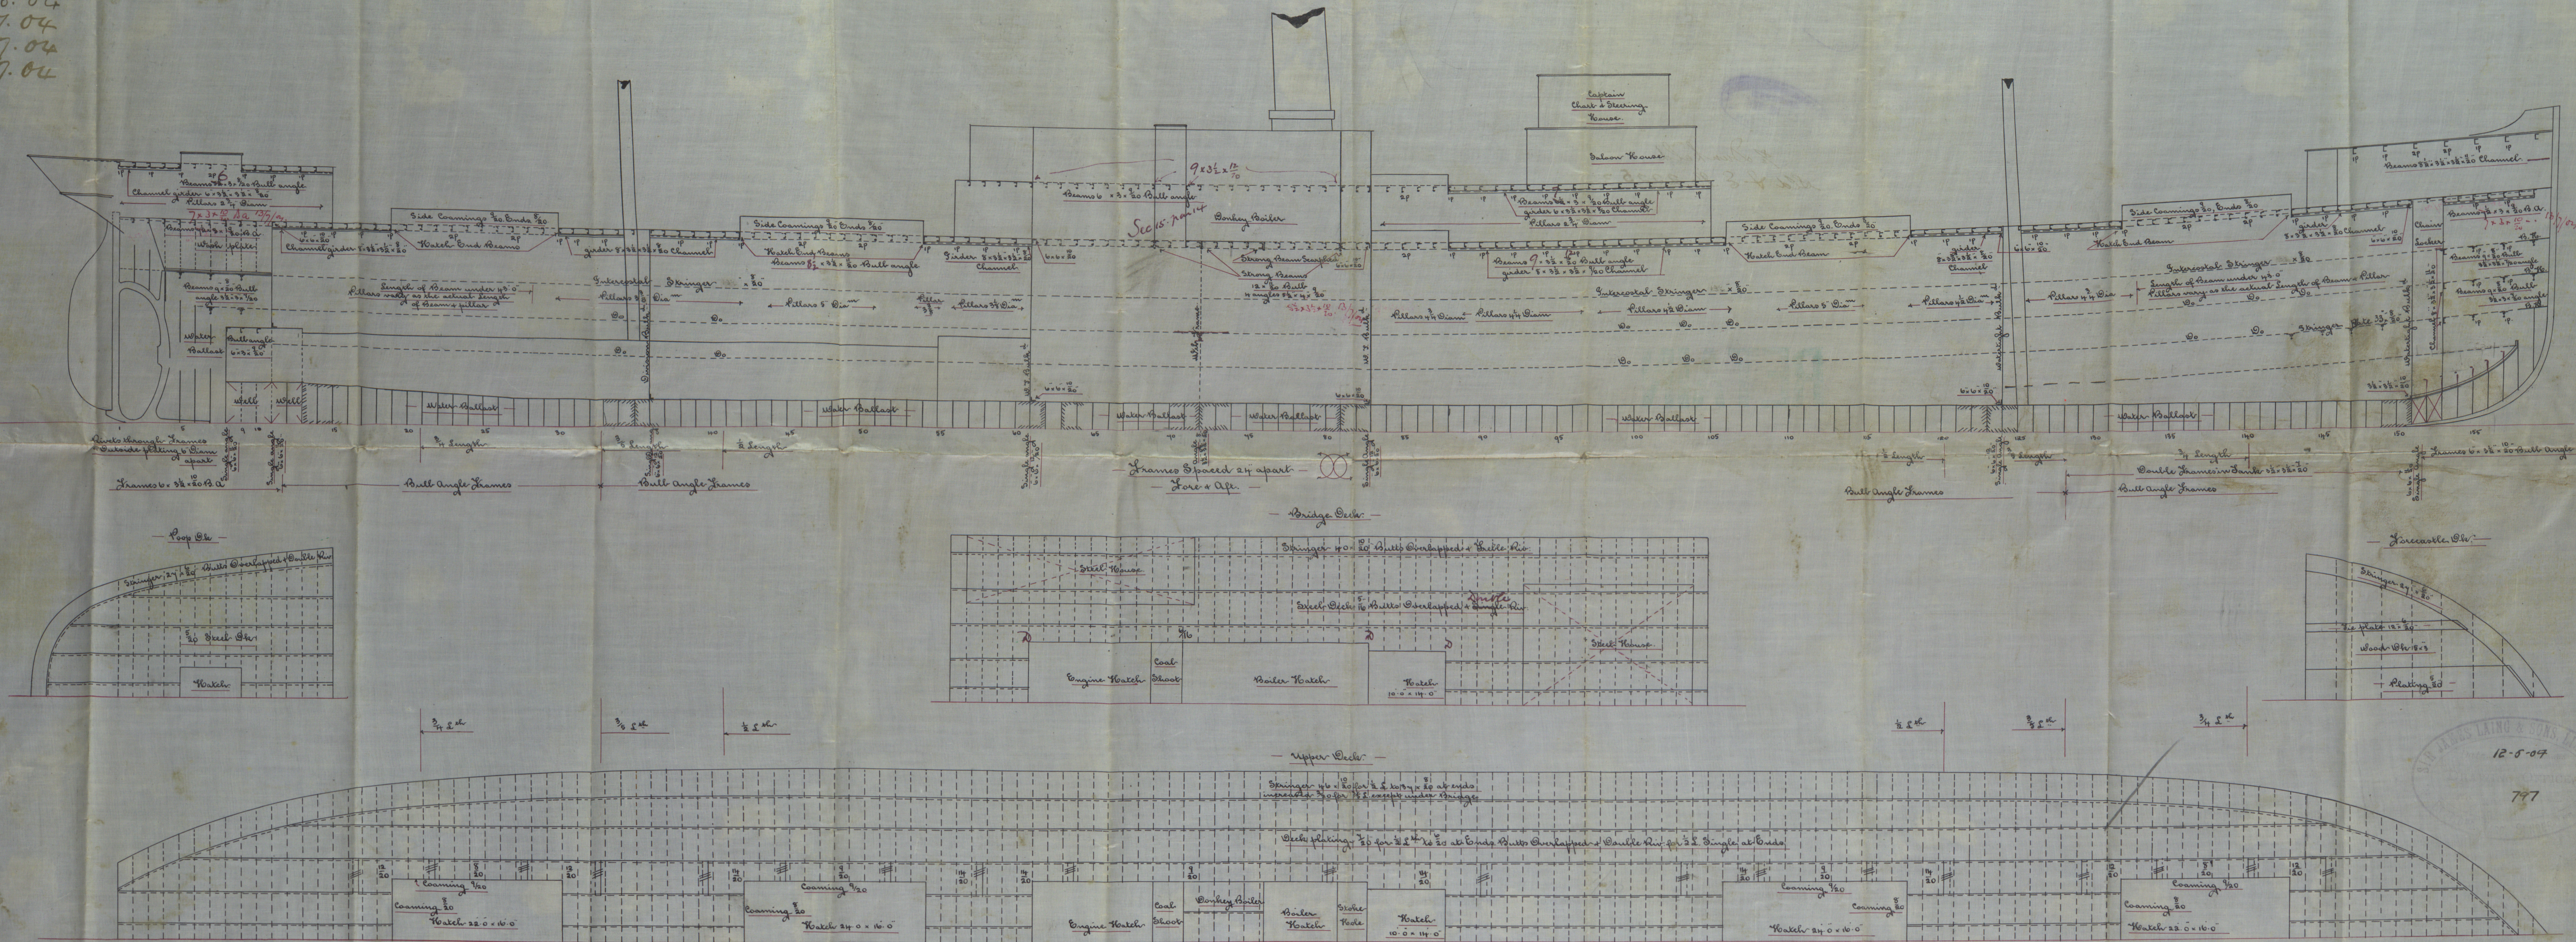

W533-0027

Per J. Lang & Son

N^o 606

Drunkald

$\frac{8}{5}$ Dunkeld

Sld & E. No 22253



Lloyd's Register
Foundation

W533-0027