


Class 100 B. 1. Lloyds

"DUNKELD"

For J. Laing & Sons No 606

Mid. Section as built

Id 22253

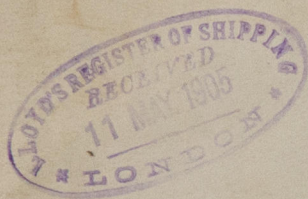

RETAIN

© 2019

Lloyd's Register
Foundation

W533 - 003Z