



19.11.09.
6.12.09.
18.12.09.
29.12.09.
10.2.10.

1782


..PROFILE..
T.S.S. 482

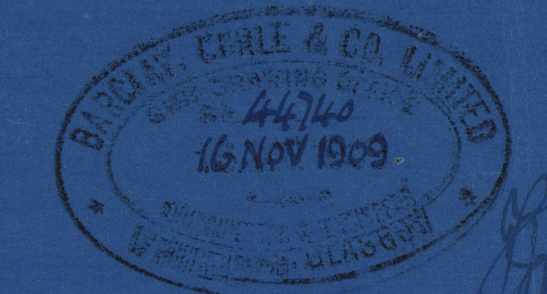

..MOULDED DIMENSIONS.. 450'-0" x 56'-0" x 33'-1 1/4"
..To CLASS.. 100° A.
..SCALE.. 1/8" = 1 FOOT.

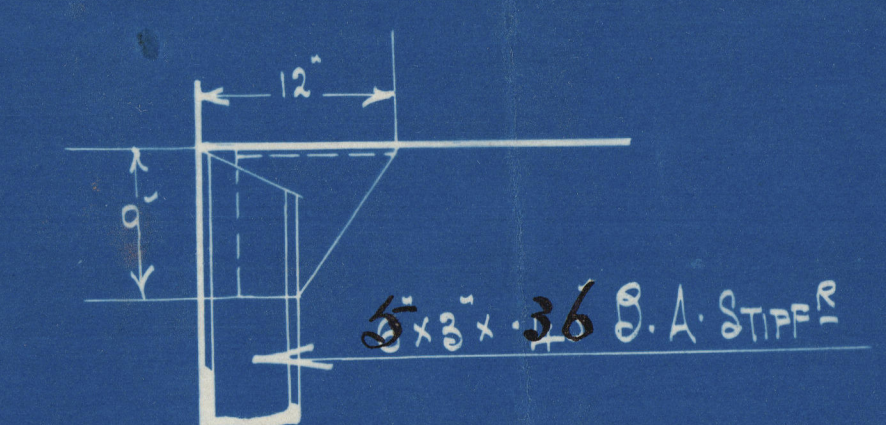

SKETCH OF BRACKETS CONNECTING
STIFFERS TO DECK'S - 1/4"
LOWER TWEEN DECK'S
SCALE 1" = 1 FOOT

 

FRAMES 9 1/2 x 3 1/2 x 52 BULB ANGLES TO MAIN & UPPER DECKS ALTERNATELY
WITH ANGLE FRAMES ABOVE BULB ANGLES SCARPHED 18" DOWN ON BULB ANGLE FRAMES
EVERY ALTERNATE BULB ANGLE FRAME CARRIED UP TO FORECASTLE
18x12 MANHOLES PUNCHED IN CENTRE GIRDER FROM 26' AFT
ONLY WHEN REQUIRED FOR ACCESSIBILITY

Web FRAMES 27 x 2 1/2 FACE BARS 7 x 3/4 x 68 TO MAIN DECK WITH B.A. FRAMES ABOVE
INTERMEDIATE FRAMES 7 x 3/4 x 68 BULB ANGLE TO MAIN & UPPER DECKS ALTERNATELY
ANGLE FRAMES 6 1/2 x 3 1/2 x 40 ABOVE INTERMEDIATE FRAMES FROM BRIDGE TO MAIN & UPPER DECKS ALTERNATELY
SCARPHED 18" DOWN ON BULB ANGLE FRAMES
BRACKETS TO STRINGERS ON ALTERNATE FROM 71 TO 187

FRAMES 6 1/2 x 3 1/2 x 40
REF FRAMES 3 x 3/4 x 40 TO MAIN & UPPER DECKS
18x12 MANHOLES PUNCHED IN CENTRE GIRDER FROM 26' AFT
ONLY WHEN REQUIRED FOR ACCESSIBILITY

FRAMES 9 1/2 x 3 1/2 x 52 BULB ANGLES
TO MAIN & UPPER DECKS ALTERNATELY
WITH ANGLE FRAMES ABOVE BULB ANGLES SCARPHED 18" DOWN ON BULB ANGLE FRAMES
EVERY ALTERNATE BULB ANGLE FRAME CARRIED UP TO FORECASTLE
18x12 MANHOLES PUNCHED IN CENTRE GIRDER FROM 26' AFT
ONLY WHEN REQUIRED FOR ACCESSIBILITY

All bulb angle frames to upper deck in way of Bridge

Bulb angles ally to upper & lower
intermediate frames 42 to 71. No not scarphed
see letter 7/2/10

C2
19/11/09








W52-032

Barclay Curle & Co.


Profile

N^o 482 $\frac{s}{s}$

GLASGOW REPORT No. 29324.

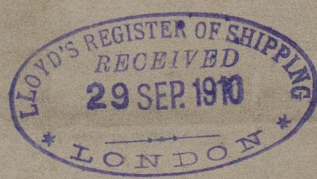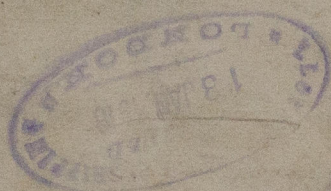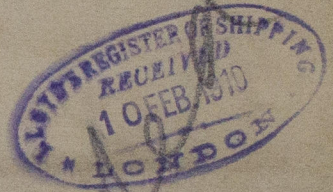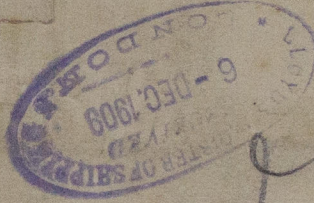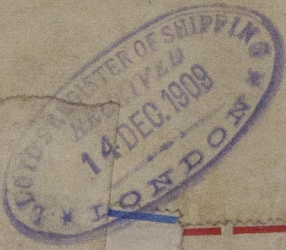

RETAIN

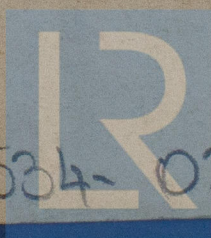

© 2020

W 534-0358

Lloyd's Register
Foundation