


Dimensions 430'-0" x 54'-0" x 34'-10" MLD.

To Class 100 At. 3 D<sup>+</sup> Rule.

Scale  $\frac{1}{2}'' = 1 \text{ Foot}$

15. 6. 06  
23. 6. 06  
5. 7. 06  
11. 9. 06

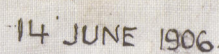

W535-0051



Messrs Workman Clark & Co


S.S. 430 x 54 x 34.10

Yard No 240  
Midship Section

S.S. Chyebaroa

Bel. 6283

RETAIN

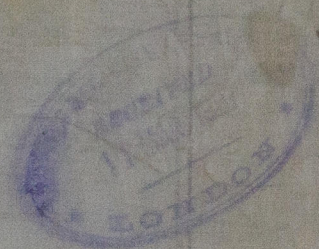

© 2020

Lloyd's Register  
Foundation

W 35-0051