

8.12.00

20 x 100 lbs

120

100

100

— PROFILE AND DECK PLAN OF S. S. No 159 —

— SCALE 1/4 INCH = ONE FOOT —

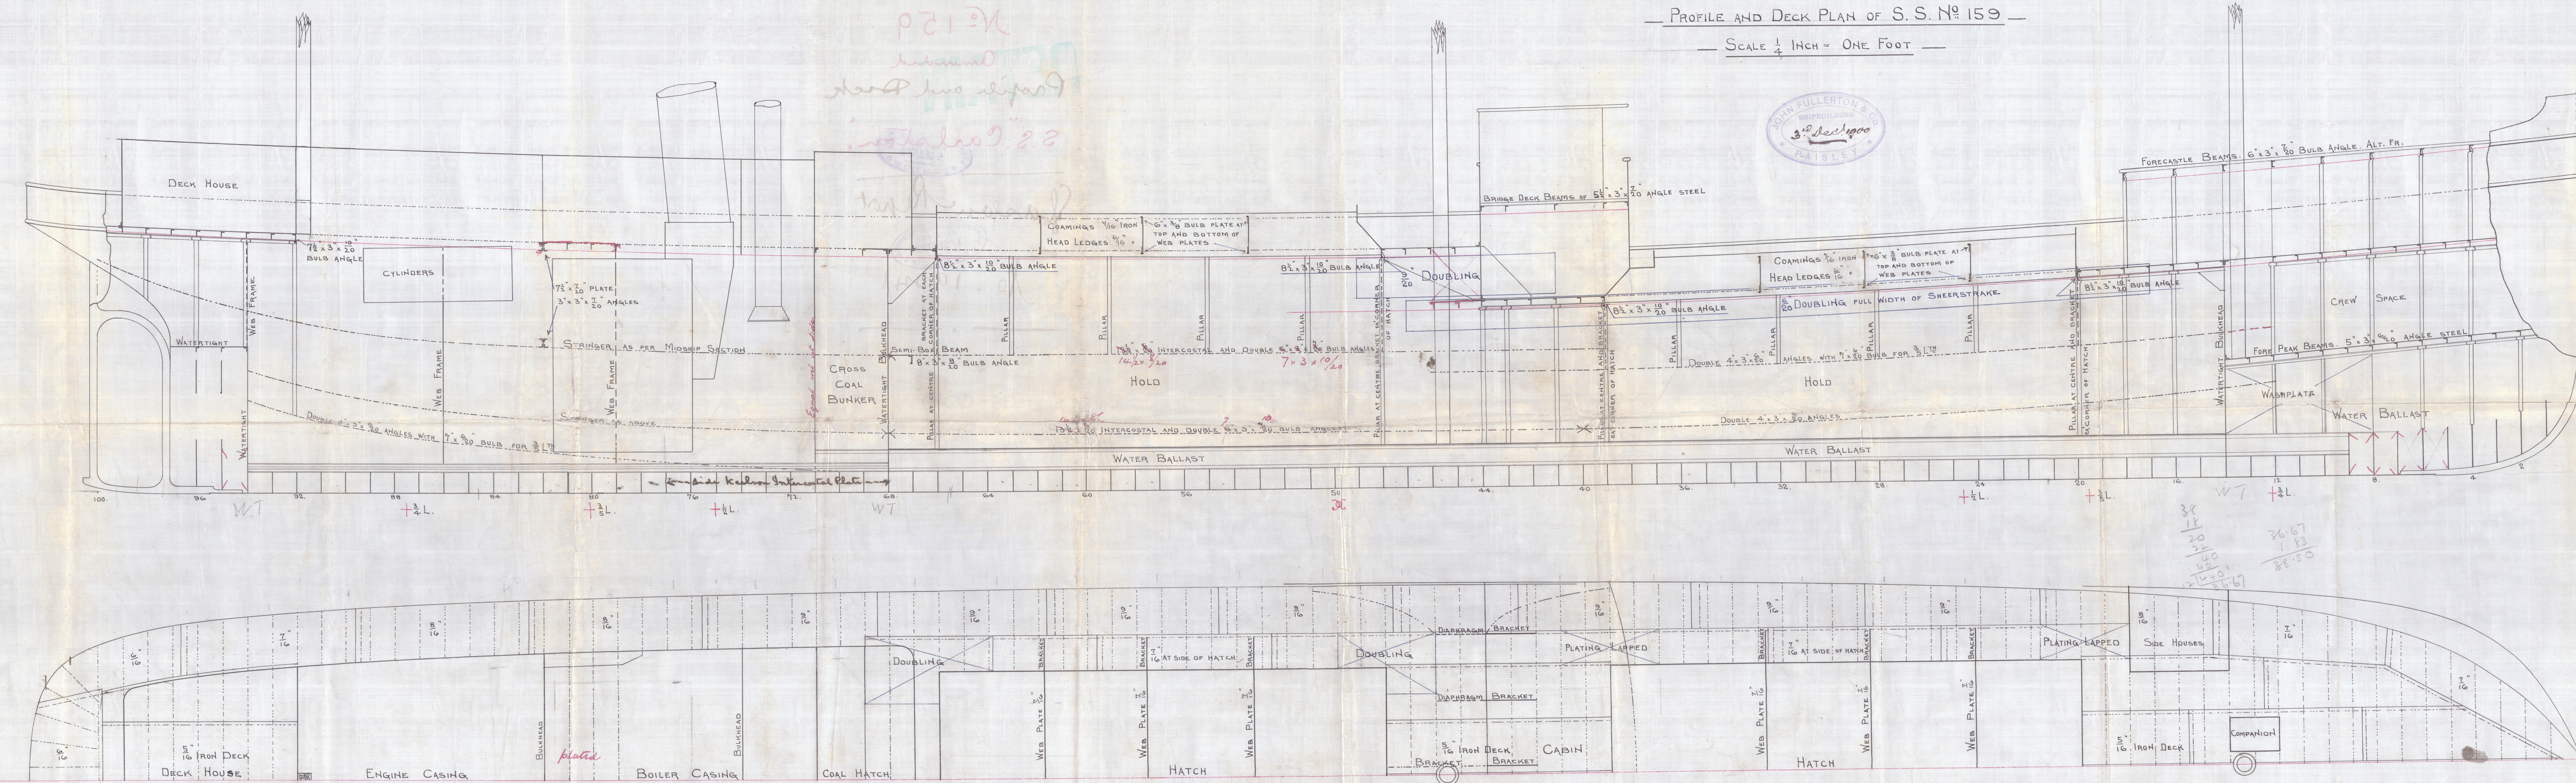

38
18
20
32
40
124.0
36.67
1.83
38.50

19 x 38
38 x 3.02

14/100

J. Fullerton & Co.

Nº 159


Amended

Profile and Deck

S.S. "Carlston".



Glasgow Report

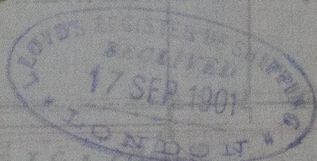

No. 19241



© 2020

Lloyd's Register
Foundation

W535-0080