


31. 6 25

DIMENSIONS:- 150'-0" B.P. x 25'-6" MLD x 15'-0" MLD

SCALE  $\frac{1}{4}" = 1 \text{ FOOT}$

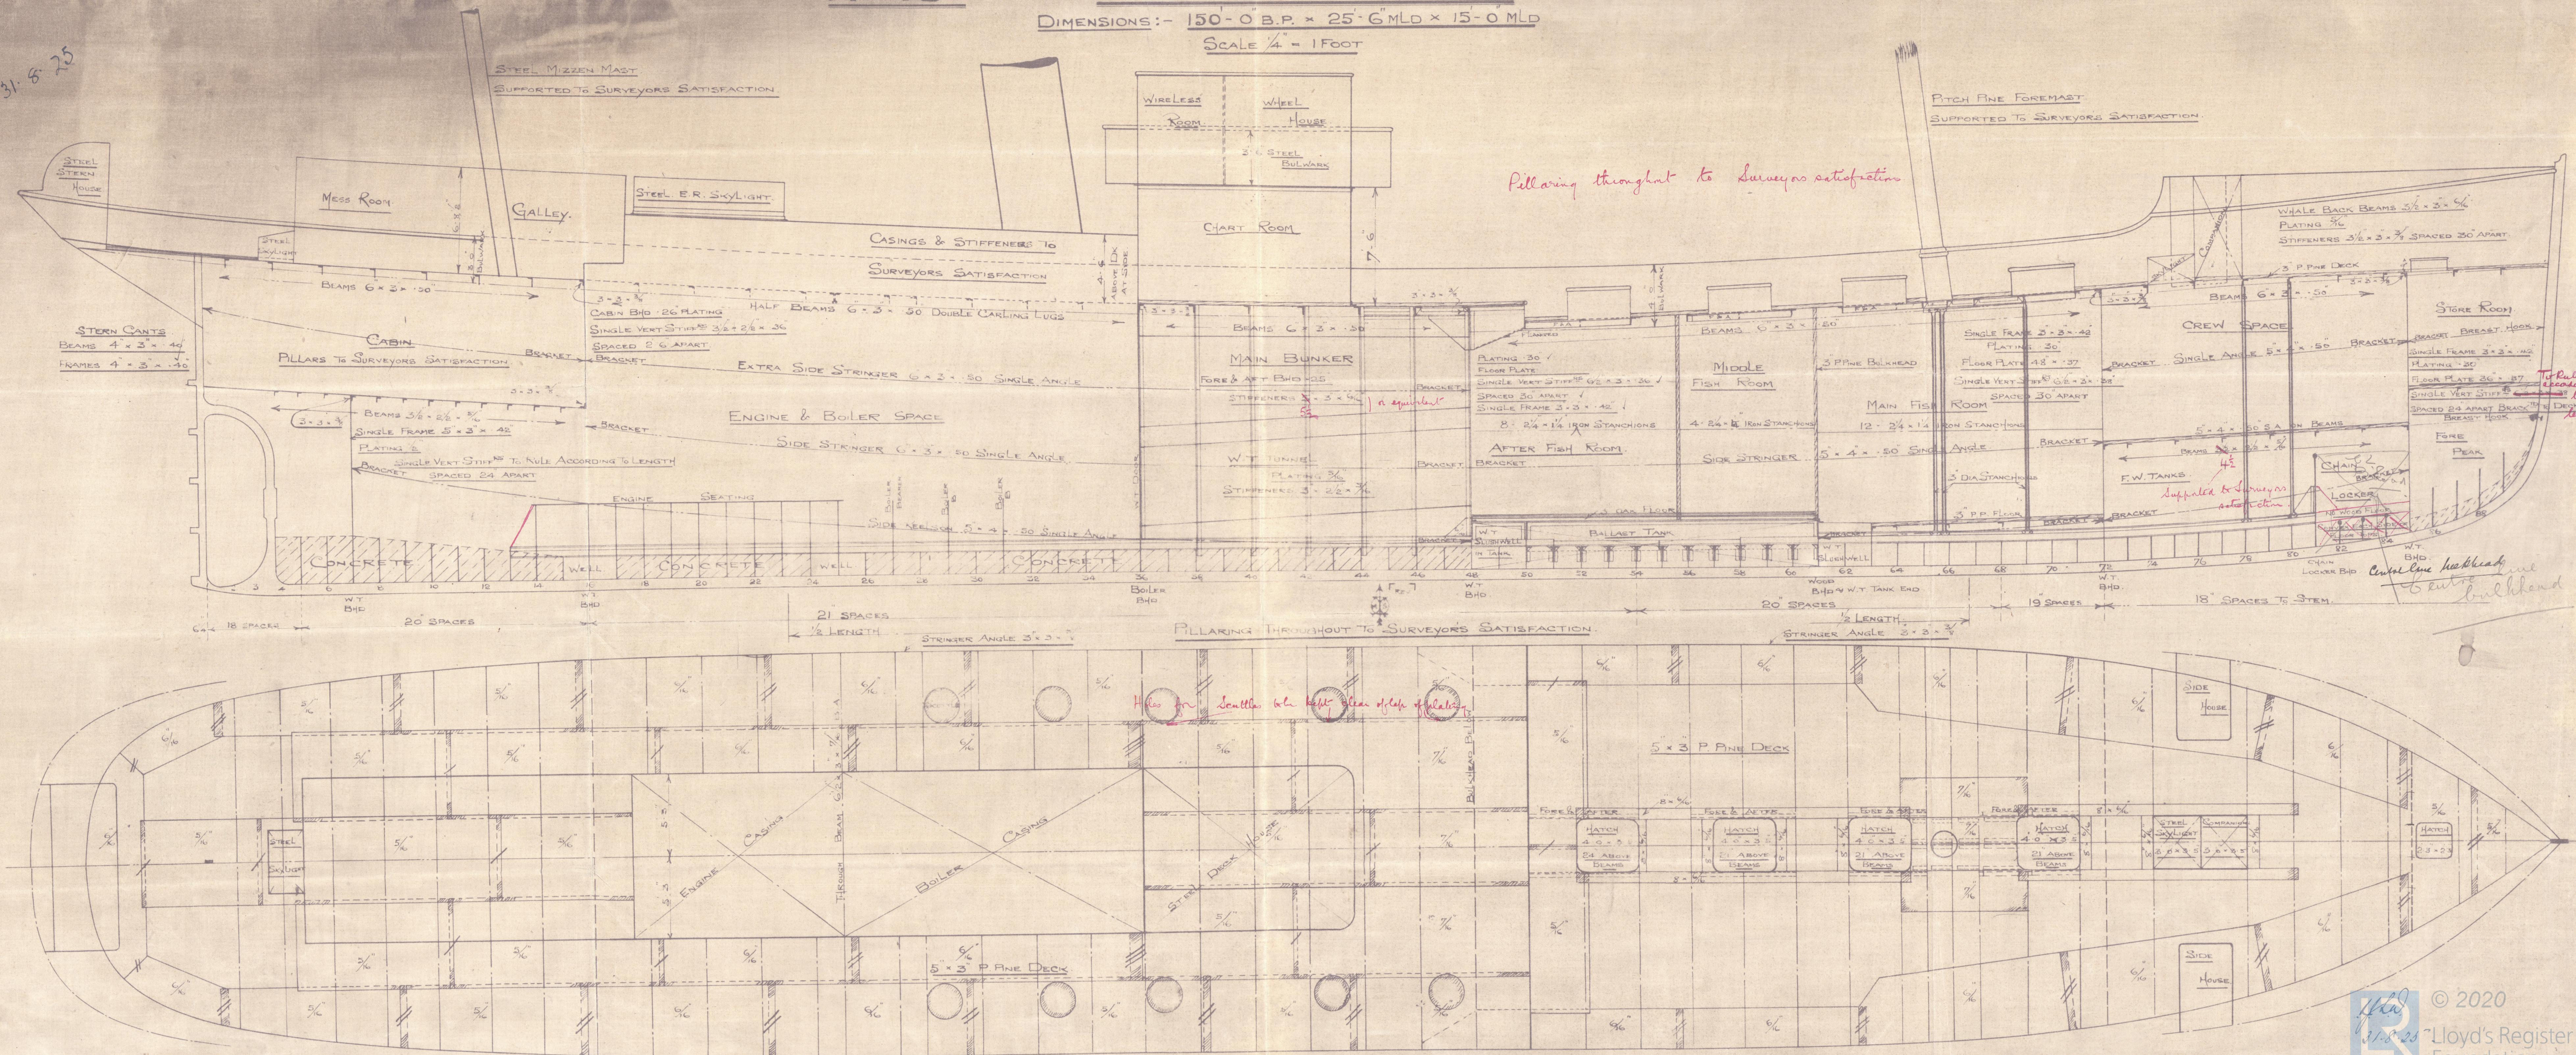




Cook Nelson & Gammell Lt  
Profile & Dr Plans

N<sup>o</sup> 480.

"Banner Radherre"

See F.C. Report No. 36925

RETAIN

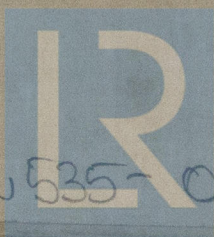

© 2020

Lloyd's Register  
Foundation

W 535-0196