

31.8.25

# No 480. MIDSHIP SECTION

DIMENSIONS:- 150'-0" B.P. x 25'-6" MLD x 15'-0" MLD.

SCALE 1/2" = 1 FOOT.

CLASS:- 100 A. I. STEAM TRAWLER.

NUMERALS.


$L \times D =$	2250
$L \times (B+D) =$	6075
$D =$	15-00
$B+D =$	40-50

PROPORTIONS.

$L/D =$	10-0
$L/B =$	5-88
$d =$	13-58

## EQUIPMENT.

1 STOCKLESS ANCHOR	9 1/2 CWTs
1 " "	9 1/2 " "
1 RODGERS	3/4 " " Ex Stock
120 FATHOMS OF	1 3/8" STUD LINK CHAIN CABLE
60 " "	7" HAWSER
60 " "	5" WARP

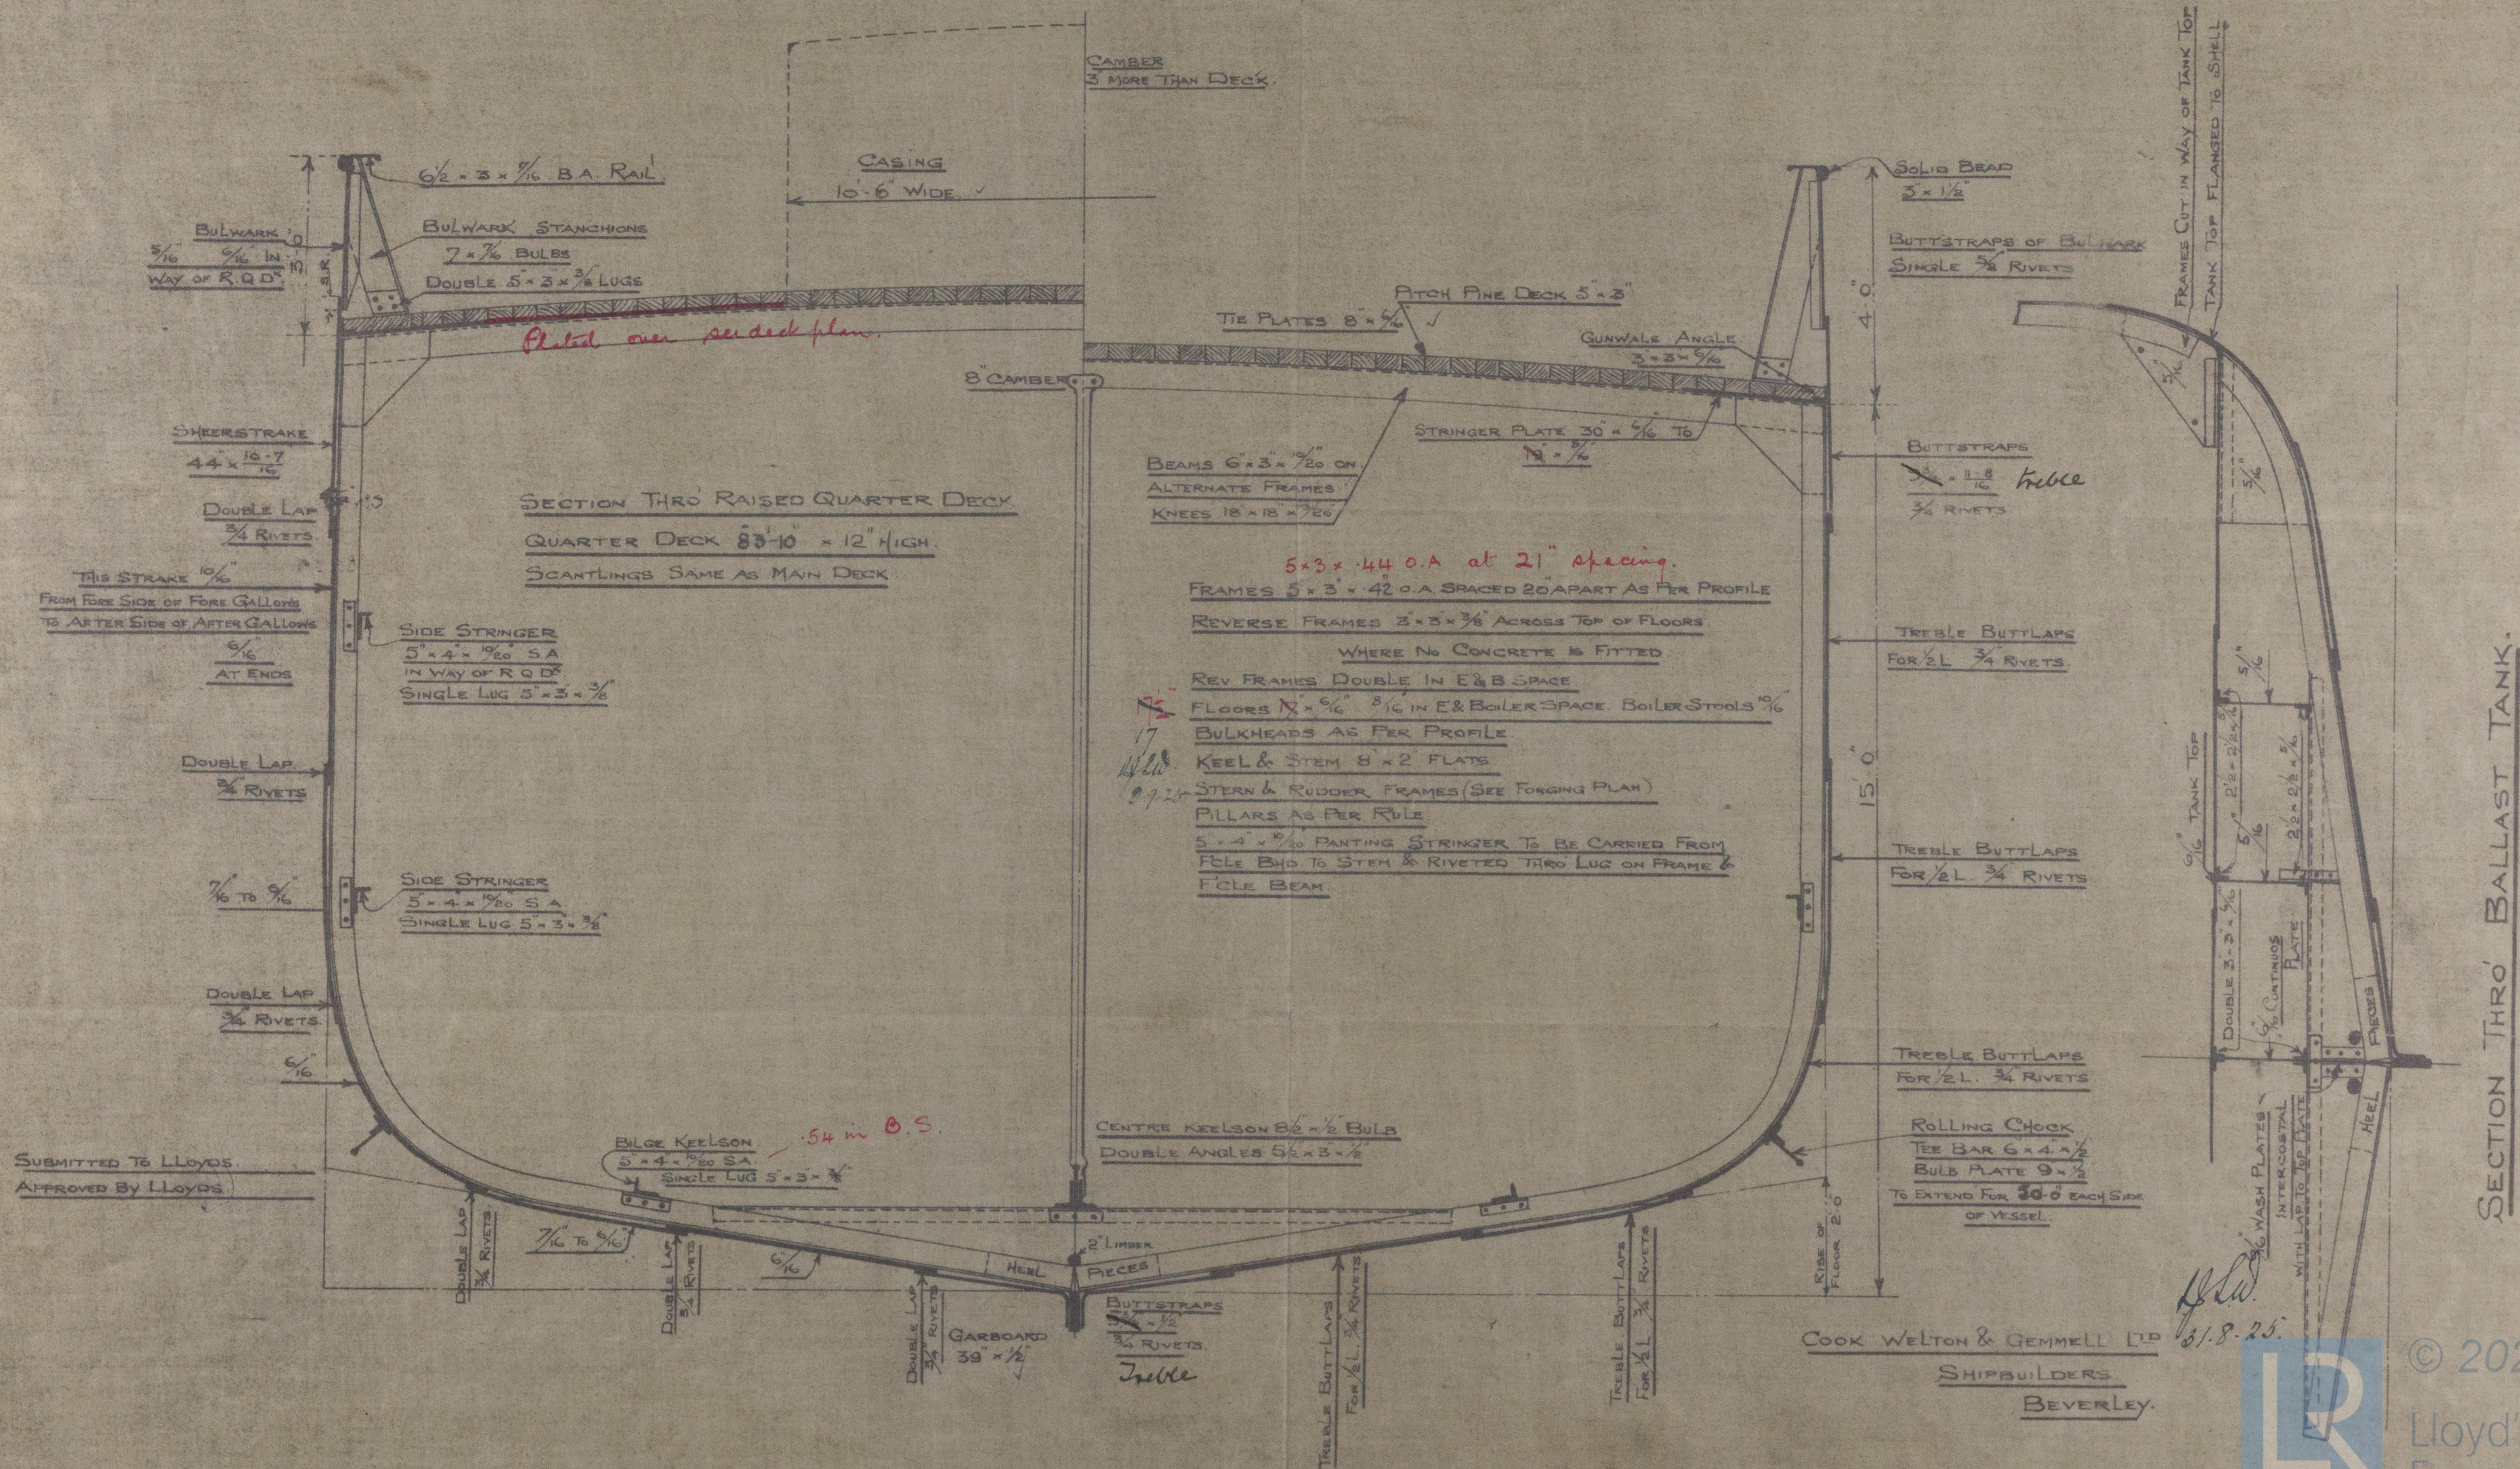

© 2020

Lloyd's Register Foundation

W535-0197




Midship Section

N<sup>o</sup> 480.

"Hannes Radherra"

Bull F.C. Report No 36925.

RETAIN



© 2020

Lloyd's Register  
Foundation

W535-0197